

SURVEYOR'S STATEMENT:

THIS TOPOGRAPHIC MAP WAS PREPARED BY ME OR UNDER MY DIRECTION AND IS BASED UPON A FIELD SURVEY COMPLETED ON JANUARY 06, 2012.

DATED: MAY 1, 2012

JOSEPH S. HICKS L.S. 8353
EXPIRES: 12/31/15
JACOBS

SURVEY NOTES:

- THE UNDERGROUND UTILITIES SHOWN HEREON HAVE BEEN LOCATED FROM FIELD SURVEY INFORMATION AND EXISTING DRAWINGS. THE SURVEYOR MAKES NO GUARANTEE THAT THE UNDERGROUND UTILITIES SHOWN COMPRISE ALL SUCH UTILITIES IN THE AREA, EITHER IN SERVICE OR ABANDONED. THE SURVEYOR FURTHER DOES NOT WARRANT THAT THE UNDERGROUND UTILITIES SHOWN ARE IN THE EXACT LOCATION INDICATED, ALTHOUGH HE DOES CERTIFY THAT THEY ARE LOCATED AS ACCURATELY AS POSSIBLE FROM THE INFORMATION AVAILABLE. THE SURVEYOR HAS NOT PHYSICALLY LOCATED THE UNDERGROUND UTILITIES.

BASIS OF BEARINGS:

THE BASIS OF BEARINGS FOR THIS MAP IS THE CALIFORNIA COORDINATE SYSTEM, ZONE 3, NORTH AMERICAN DATUM 1983 (CORS 98) PROJECTED TO GROUND COORDINATES, DERIVED FROM "OPUS" POSITION ON OCTOBER 11, 2011, ADJUSTED TO THE 2002.00 EPOCH AND USING THE FOLLOWING PROJECTION AND LOCAL SITE VALUES:

- PROJECTION - LAMBERT CONFORMAL CONIC
ORIGIN: 3740'00.00000"N 122°00'00.00000"W
FALSE NORTHING: 1640416.667 FALSE EASTING: 6561666.667
- LOCAL SITE - LAT: 37°38'14.98129"N LON: 122°26'15.03938"W
E HGT: 93.607 FT
GSF: 1.0000733387 FALSE OFFSET: 0.0 N, 0.0 E
- CONTROL #1 - LAT: 37°38'14.98129"N LON: 122°26'15.03938"W
E HGT: 93.607 FT (OPUS)

BENCHMARK:


CITY OF SAN BRUNO BENCHMARK SB-11.

A 2" BRASS MONUMENT STAMPED "CITY OF SAN BRUNO, PUBLIC WORKS, HVCN SB-11", SET IN TOP OF CURB ON HUNTINGTON AVE. 90' SOUTHERLY OF THE DRIVEWAY INTO THE SAN BRUNO POST OFFICE (APPROXIMATELY 1 MILE NORTHEAST OF THE PROJECT AREA).

ELEVATION: 45.572' (NAVD 88)

CONTROL TABLE:


PT#	NORTHING	EASTING	ELEV.	DESC.
1	2060396.17	6000688.01	200.79	CP 1 SET S/W
2	2060373.60	6004788.51	70.08	CP 2 SET S/W
3	2060822.96	6004972.69	63.44	CP 3 SET S/W
4	2060075.15	6005288.47	63.29	CP 4 SET SCR X
5	2059708.97	6004736.22	82.15	CP 5 SET SCR X
6	2059366.75	6004207.10	99.56	CP 6 SET SCR X
7	2059539.62	6003123.19	131.09	CP 7 SET S/W
8	2058865.57	6001837.16	171.98	CP 8 SET S/W
9	2059033.26	6001469.89	176.83	CP 9 SET S/W
10	2059002.78	6001315.52	177.68	CP10 SET S/W
11	2058633.16	6001124.94	184.72	CP11 SET S/W
12	2058270.86	6001356.22	190.82	CP12 SET S/W
13	2059311.58	6001149.62	137.54	CP13 SET S/W
14	2061327.35	6004796.22	66.40	CP 14 SET MN
15	2058974.15	6001224.08	171.07	CP 15 SET SCR X
16	2059156.10	6003748.59	116.49	CP 16 SET MN
17	2059209.22	6003660.26	118.86	CP 17 SET MN

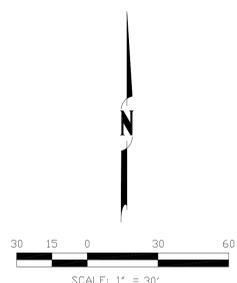

ENLARGEMENT - EXISTING WALL

LEGEND

- ▲ CONTROL POINT
- ▽ DROP INLET
- FIRE HYDRANT
- GAS MARKING
- GATE
- GRAVE
- HEADSTONE
- IRRIGATION BOX
- LIGHT ON POLE/LANDSCAPE LIGHT
- POWER BOX
- POWER CABINET
- POWER MARKING
- POWER METER
- POWER RISER
- POWER VAULT
- SEWER MANHOLE
- SIGN
- STORM DRAIN MANHOLE
- TELEPHONE VAULT
- TRAFFIC LOOP WELL
- TRAFFIC SIGNAL
- TRAFFIC SIGNAL PULL BOX
- WATER METER
- WATER MARKING
- WATER RISER
- WATER VALVE
- EP — EDGE OF PAVEMENT LINE
- G — GAS LINE
- F — FENCE LINE
- W — WATER LINE
- TREE
- SPOT ELEVATION
- SPOT ELEVATION (TOP WALL)
- SPOT ELEVATION (BOTTOM WALL)
- 175 — MAJOR CONTOUR
- 174 — MINOR CONTOUR

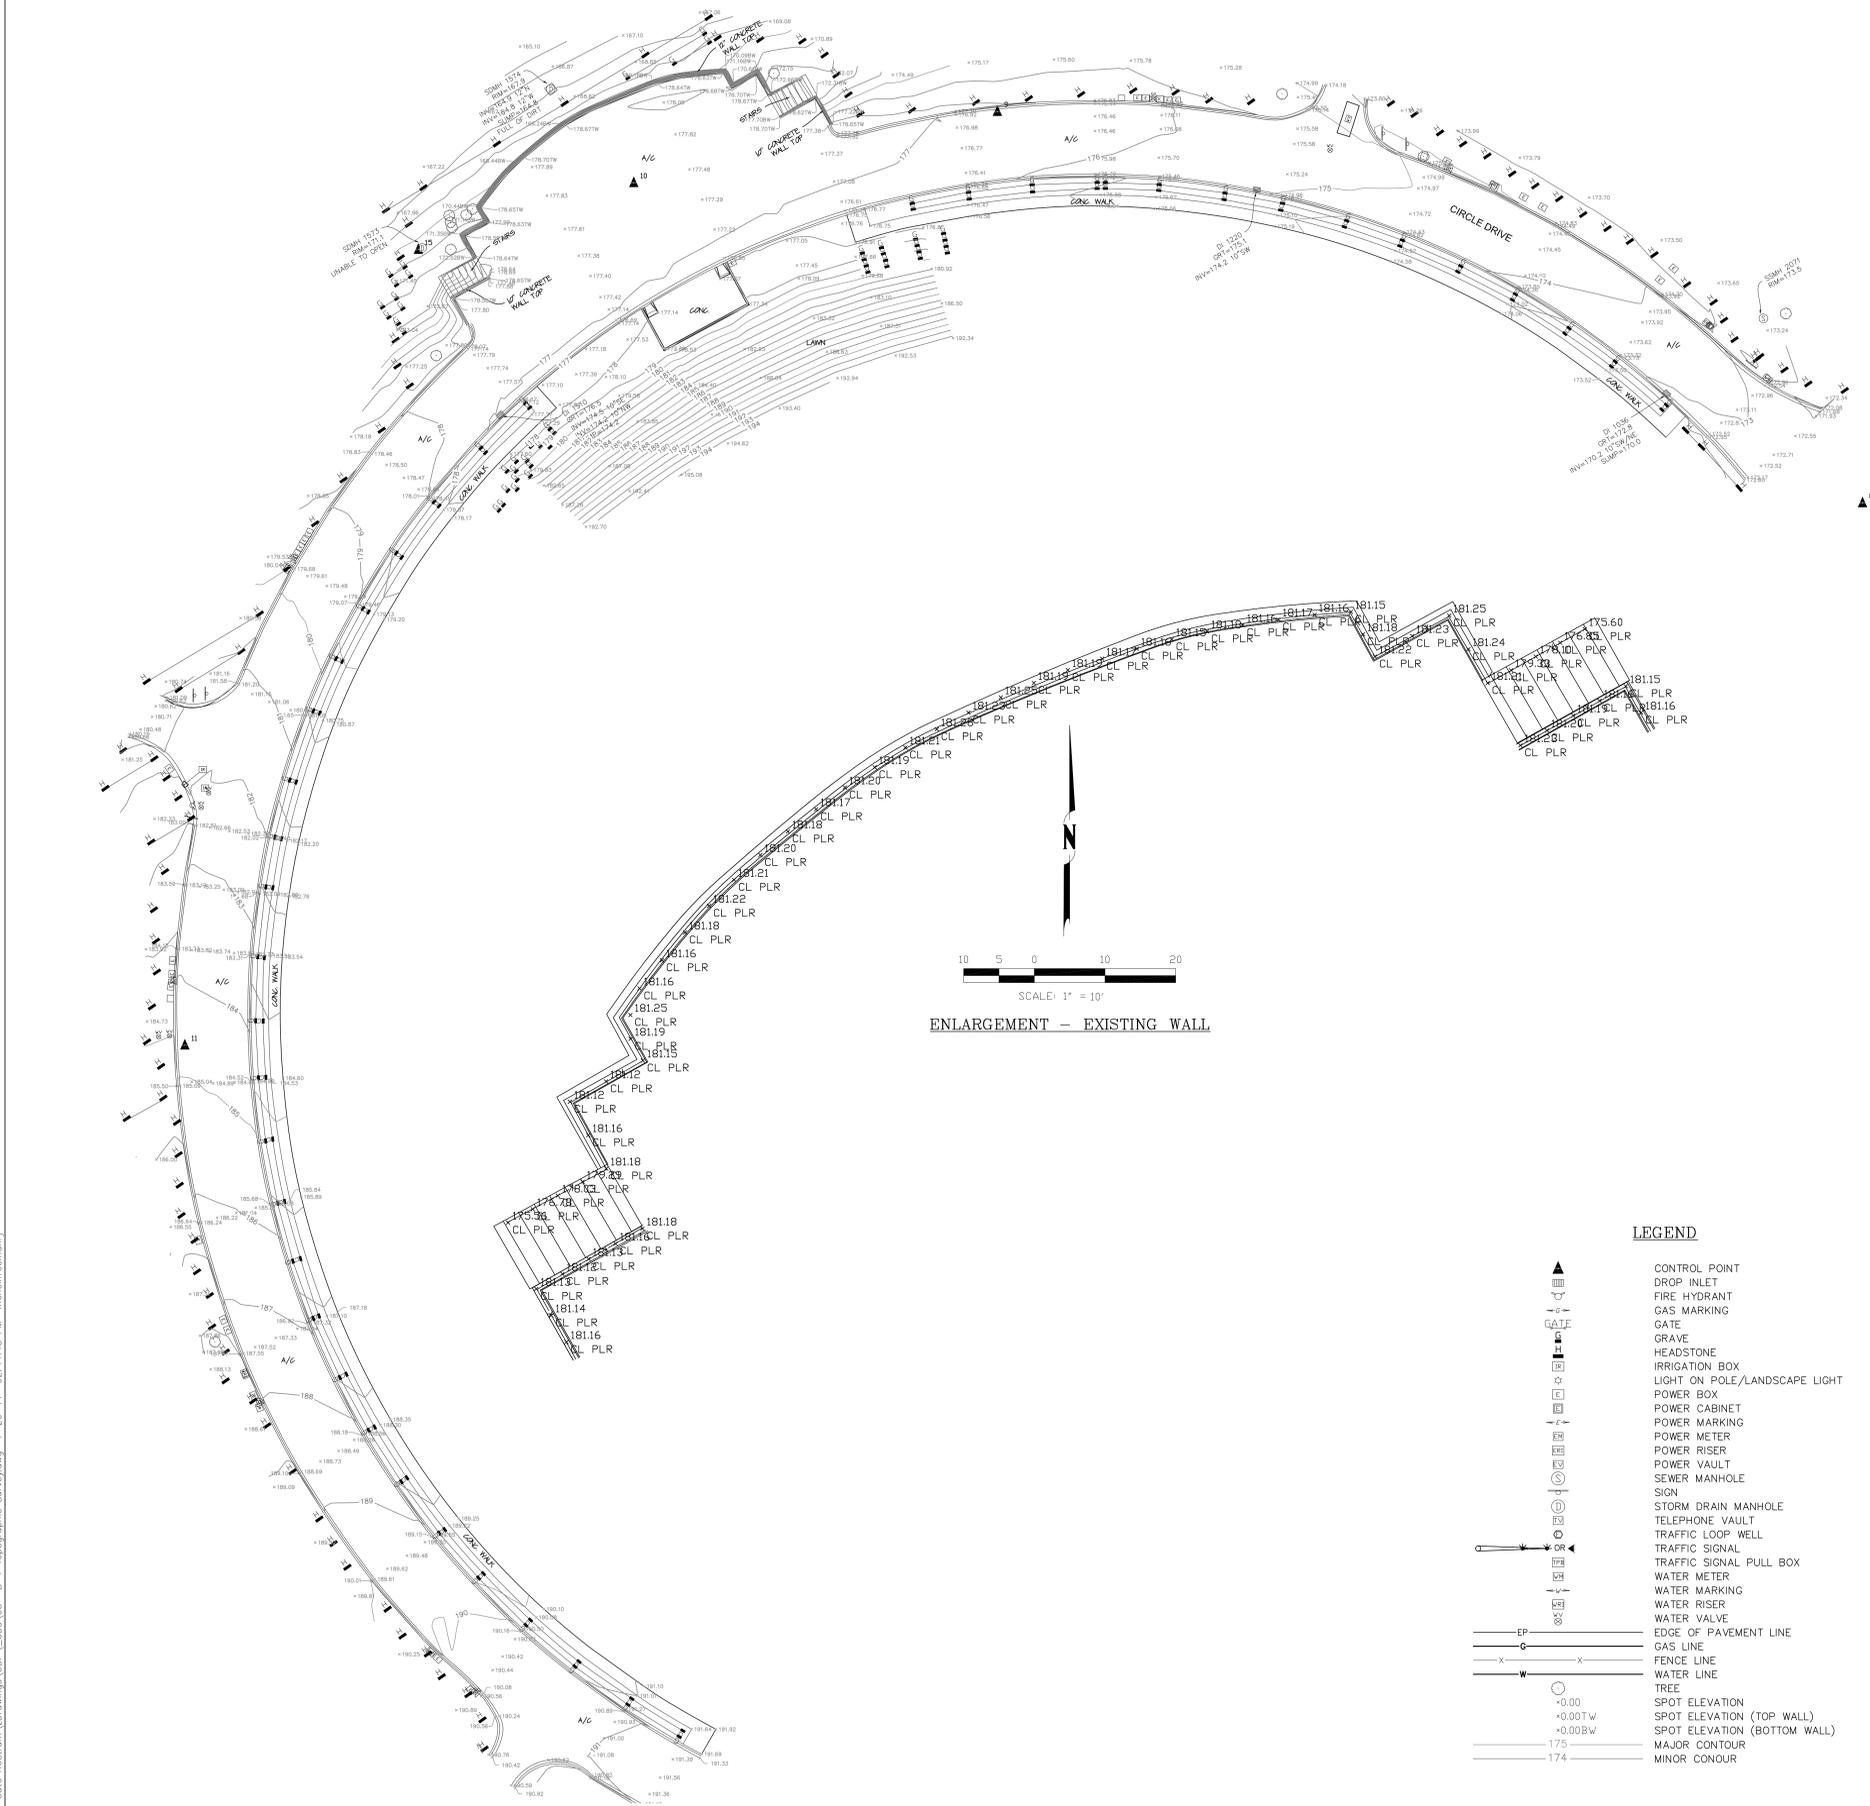

P:\Projects\17869704_VA_ID00_Golden Gate Rostum_VDrawings\UDP_C03_03_B-1_Topographic_Survey.dwg 7-29-14 02:44:13 PM mrcnell@jacobs.com

Revisions	Date

JACOBS
1050 20TH STREET, SUITE 200
SACRAMENTO, CA 95811
PHONE (916) 929-3323 FAX (916) 929-1772

Subconsultant List

THE SIERRA WEST GROUP, LLC 9700 BUSINESS PARK DRIVE, STE. 102, SACRAMENTO, CA 95827 (916) 925-4000

NATIONAL CEMETERY ADMINISTRATION

Drawing Title: TOPOGRAPHIC SURVEY

Approved: Director, Office of Construction Management

Approved: Director, Project Management Service

Project Title: RENOVATE ROSTRUM AND ROAD

Building Number: Checked: Drawn:

Location: GOLDEN GATE NATIONAL CEMETERY
1300 SNEATH LANE
SAN BRUNO, CALIFORNIA

Date: JULY 30, 2014

Project No.: 895CM3047

DRAWING NO.: B-1

Dwg. 3 of 18