RATED WALL LEGEND

- 2 HR FIRE BARRIER
- 1 HR FIRE BARRIER
- 1 HR SMOKE BARRIER
- WALLS RESISTANT TO SMOKE

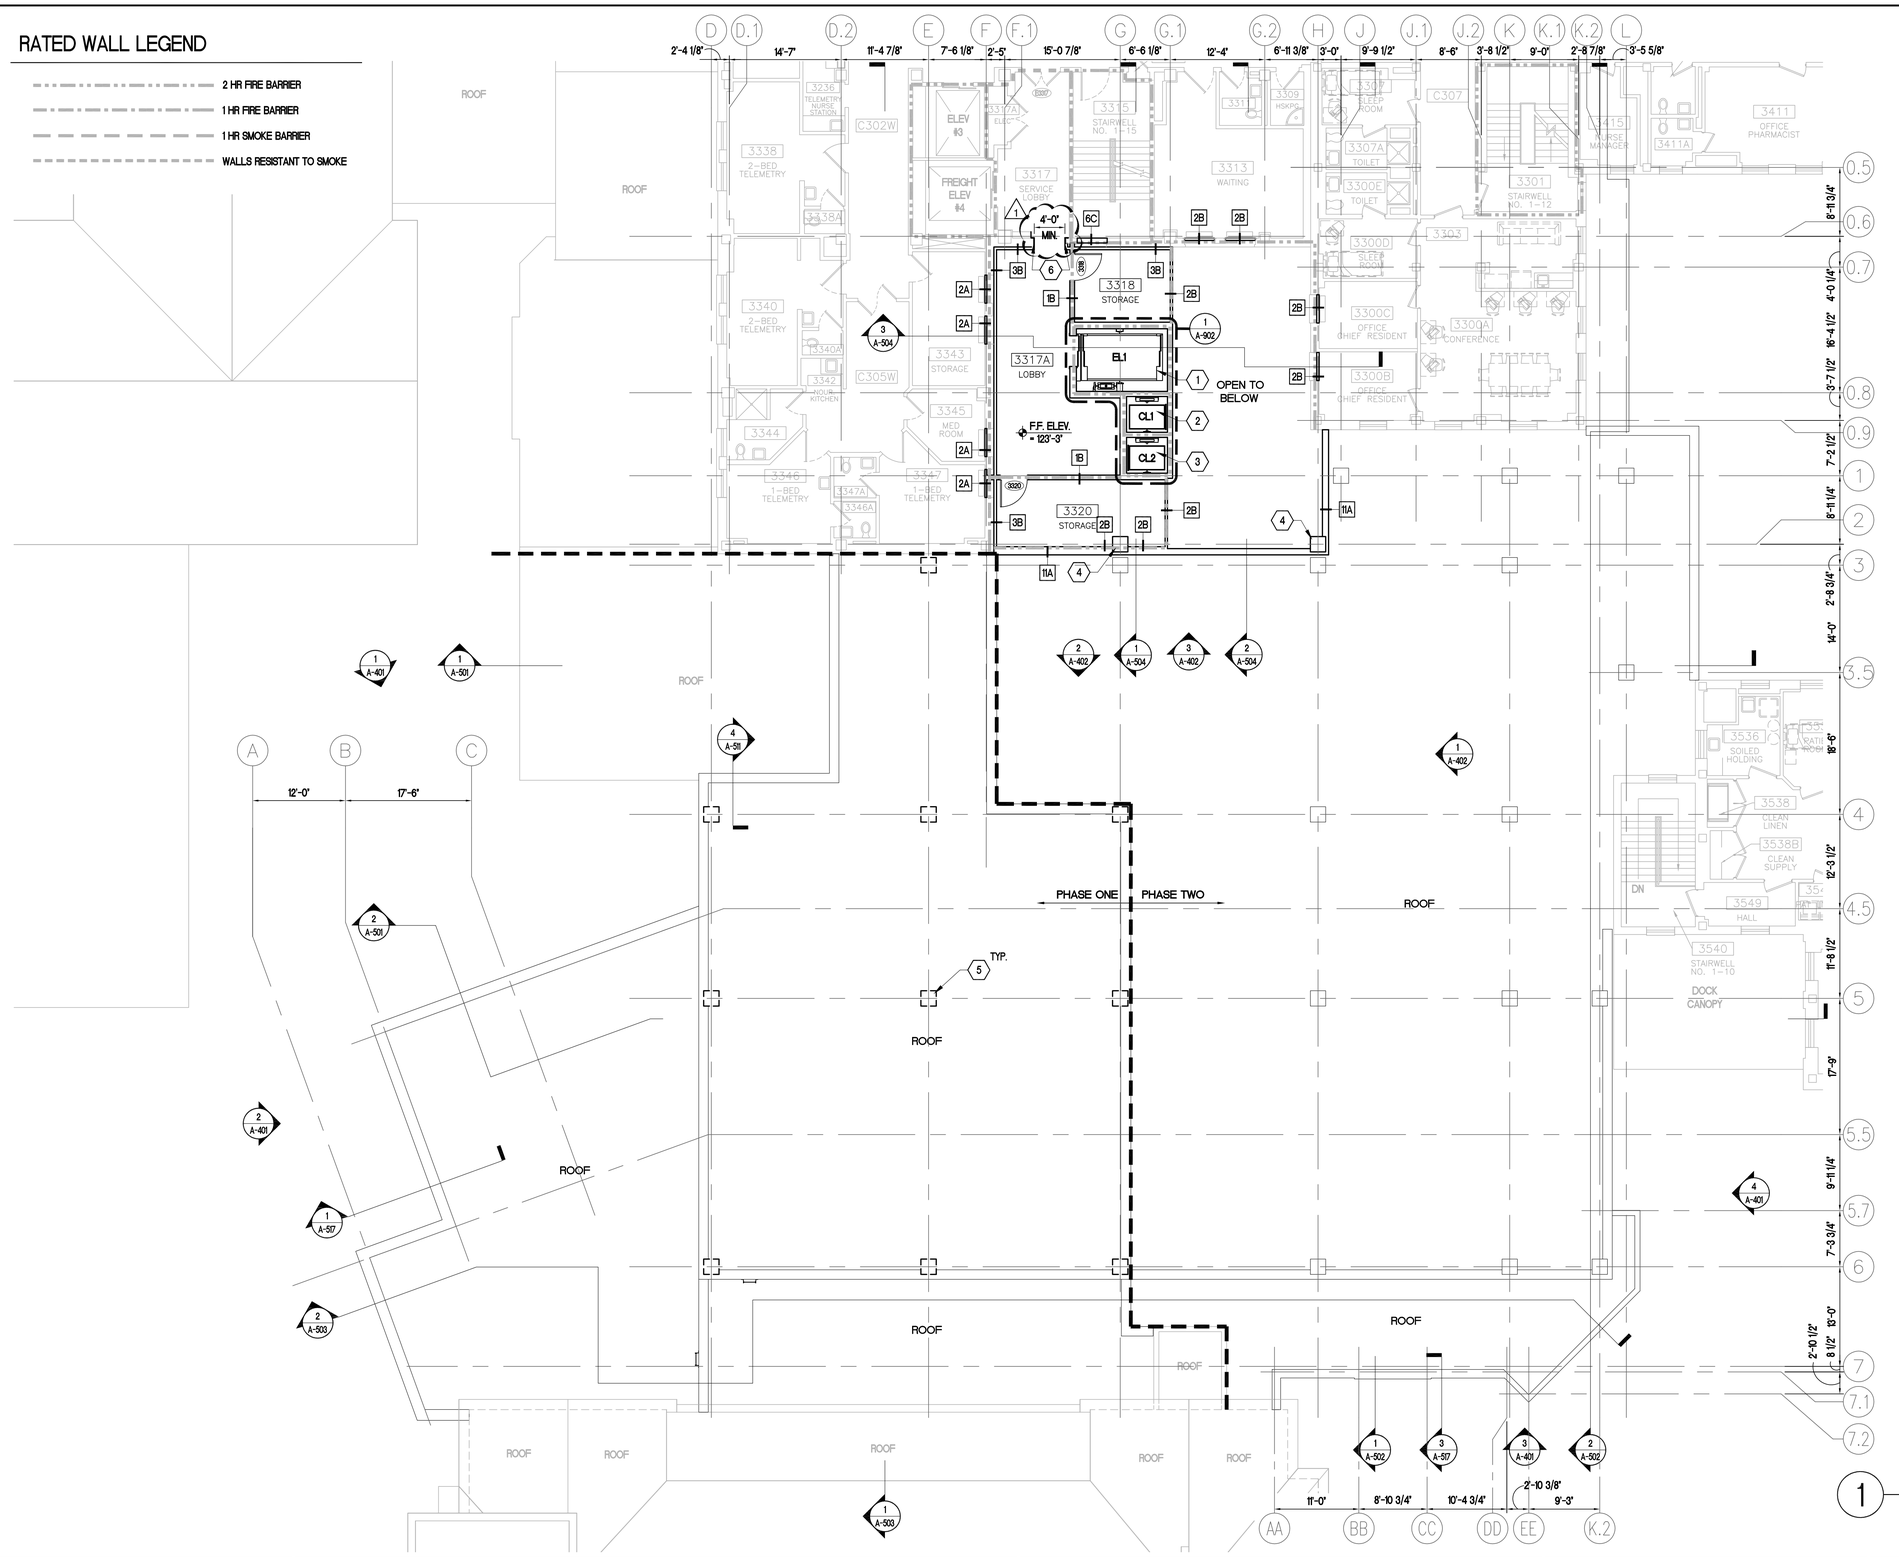

FLOOR PLAN GENERAL NOTES

1. ALL NEW WALLS SHALL BE TYPE 1A UNLESS OTHERWISE NOTED, SEE 1/A-001 FOR WALL TYPES
2. FOLLOW MANUFACTURER'S INSTALLATION AND ROUGH-IN GUIDES FOR ALL EQUIPMENT TO BE INSTALLED
3. ALL OTHER ITEMS TO BE CONTRACTOR FURNISHED, CONTRACTOR INSTALLED UNLESS OTHERWISE NOTED
4. OMIT THE REQUIREMENT FOR PHASING UNDER ALTERNATE DEDUCT #1

FLOOR PLAN KEYNOTES

1. NEW PASSENGER ELEVATOR (EL1) AND ASSOCIATED ELEVATOR EQUIPMENT, OMIT UNDER ALTERNATE DEDUCT #3. ALL ASSOCIATED CONDUITS AND PATHWAYS FOR THE ELEVATOR TO BE INSTALLED UNDER BASE BID REGARDLESS.
2. NEW DIRTY CART LIFT (CL1) AND ASSOCIATED LIFT EQUIPMENT, OMIT UNDER ALTERNATE DEDUCT #5. ALL ASSOCIATED CONDUITS AND PATHWAYS FOR THE CART LIFT TO BE INSTALLED UNDER BASE BID REGARDLESS.
3. NEW CLEAN CART LIFT (CL2) AND ASSOCIATED LIFT EQUIPMENT, OMIT UNDER ALTERNATE DEDUCT #5. ALL ASSOCIATED CONDUITS AND PATHWAYS FOR THE CART LIFT TO BE INSTALLED UNDER BASE BID REGARDLESS.
4. 2'-0" x 2'-0" REINFORCED CONCRETE COLUMN
5. EXPOSED COLUMNS WITH TEMPORARY CAP, SHOWN DASHED, SEE DETAIL 8/A-520
6. SEE DETAILS 1LL, 1OO, 1PP / A-704.

1 THIRD FLOOR PLAN (PHASE ONE AND TWO)

0 8 16 24 1 / 8 "

-	-
-	-
-	-
-	-
-	-
-	-
-	-
-	-
#1 AMENDMENT 002	08-07-14
Revisions:	Date

CONSULTANTS:

ARCHITECT/ENGINEERS:

Kenneth Hahn Architects

1343 South 75th Street | Omaha, NE 68124-1610 | 402.391.2111 | www.kharch.com

AE Project # 171-001

Drawing Title: THIRD FLOOR PLAN (PHASE ONE AND TWO)

Approved: Project Director

Project Title: BUILD SUPPLY, PROCESSING AND DISTRIBUTION

Location: VAMC DES MOINES IOWA

Date: 13 FEBRUARY 2014 | Checked: NAS | Drawn: MTS

Project Number: 636-121

Building Number: BUILDING 1W

Drawing Number: A-131

Dwg. 29 of 235

Office of Construction and Facilities Management

Department of Veterans Affairs

VA FORM 08-6231

P:\171\171-001 SPS Addition - Des Moines VA Med Ctr\DRAWINGS\333_636-121_A131.dwg 8-05-14 03:33:04 PM Neal