



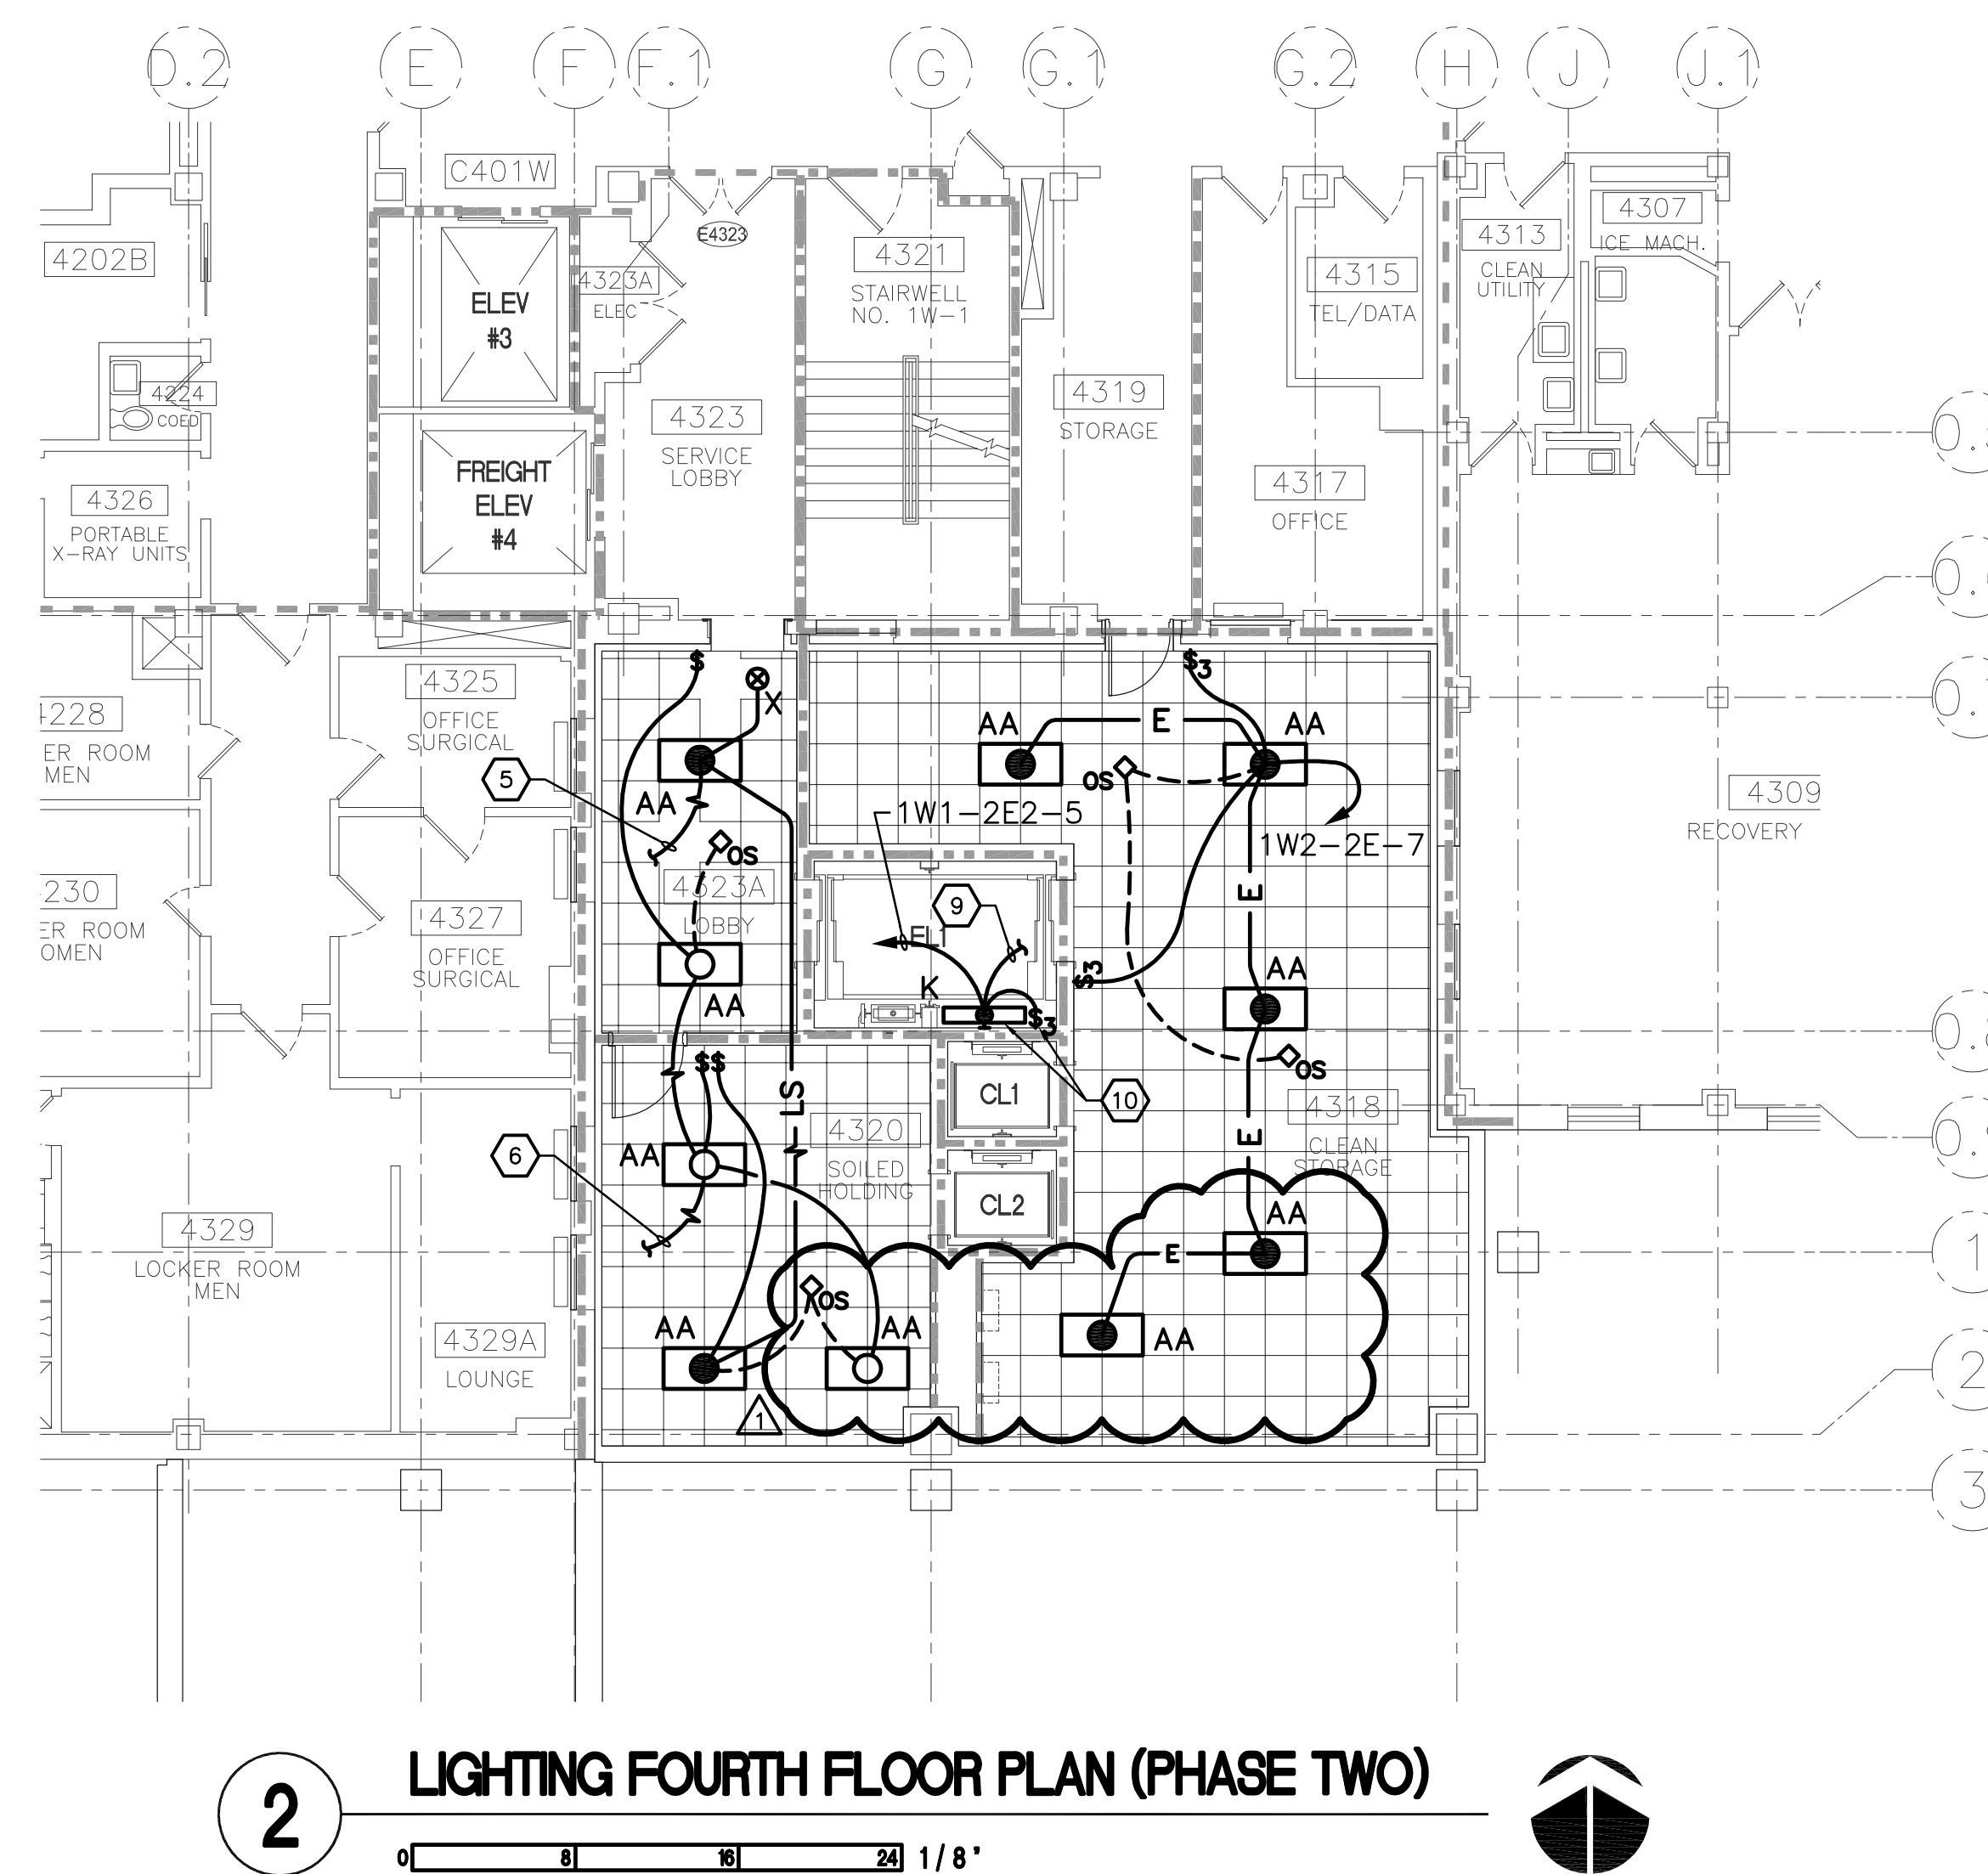

three inches = one foot
one and one half inches = one foot
one inch = one foot
three quarters inch = one foot
one half inch = one foot
three eighths inch = one foot
one quarter inch = one foot
one eighth inch = one foot
C:\AutoBack\Temp\Acad\list_6320\333_636-121_EL131.dwg 8-06-14 02:03:31 PM EMN

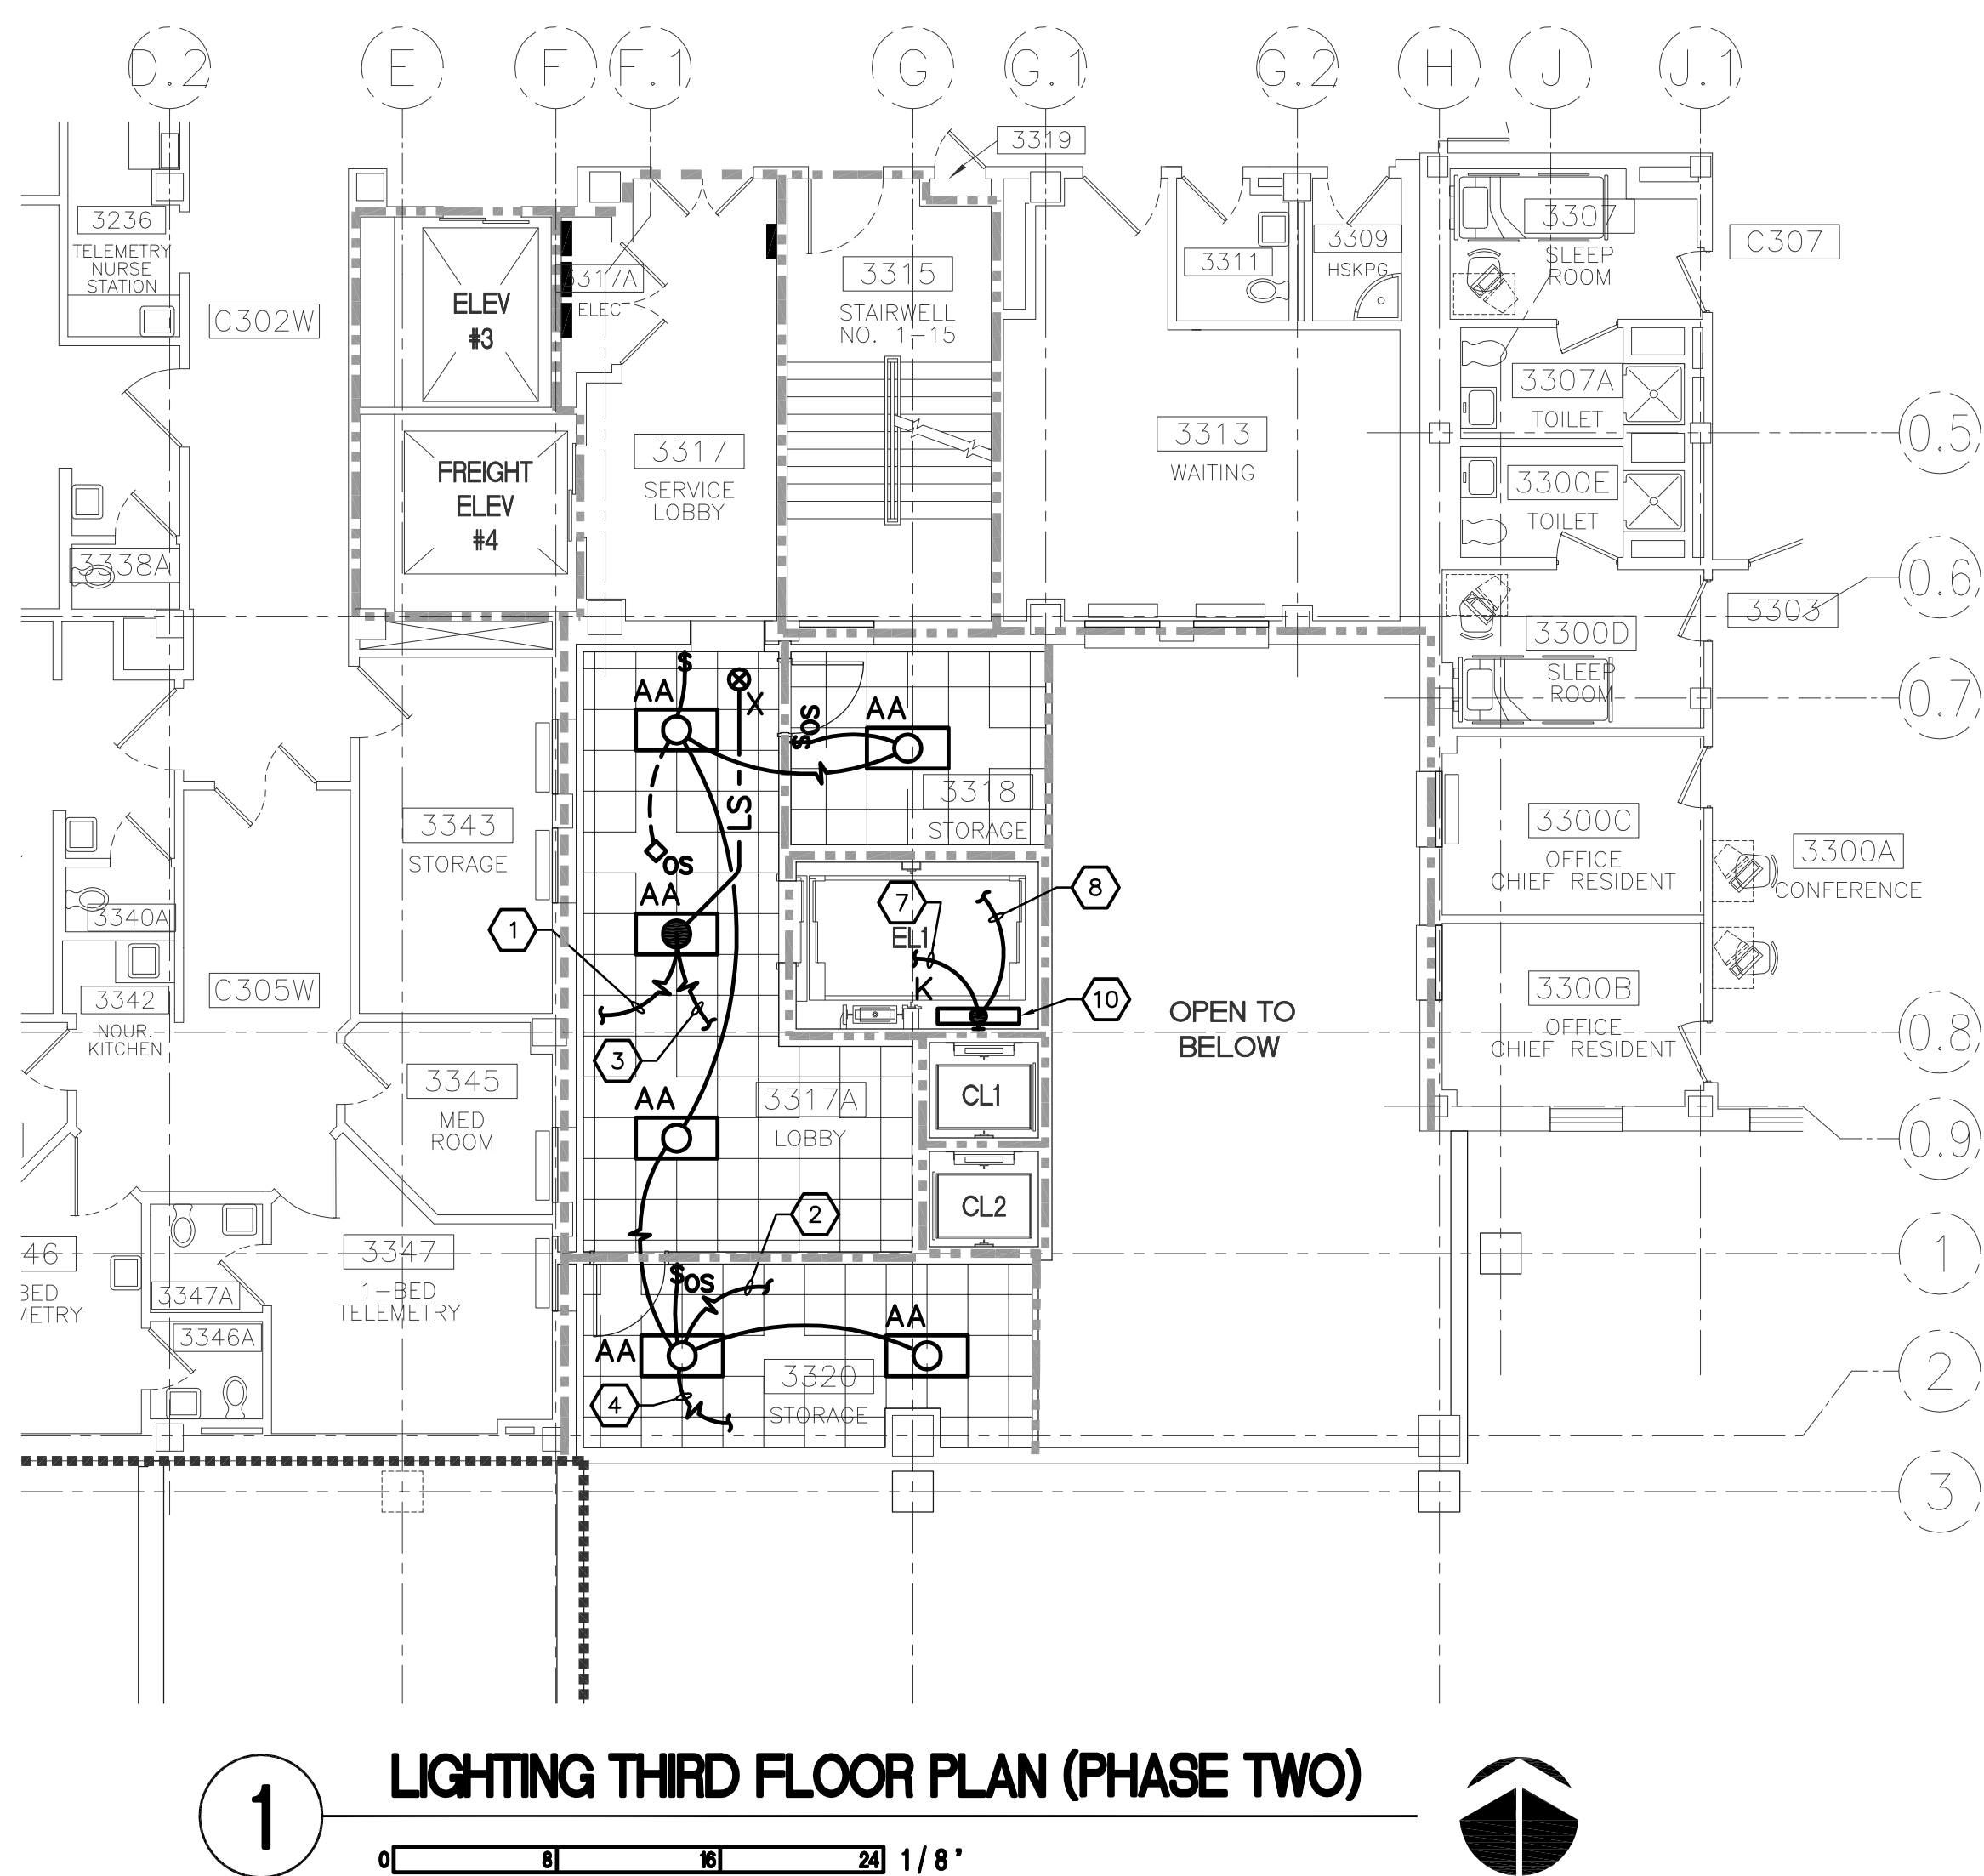

ELECTRICAL KEYNOTES: (◇)

- TO SECOND FLOOR UNSWITCHED LIFE SAFETY CIRCUIT. SEE SHEET EL122 FOR CONTINUATION.
- TO SECOND FLOOR UNSWITCHED NORMAL POWER. SEE SHEET EL122 FOR CONTINUATION.
- TO FOURTH FLOOR UNSWITCHED LIFE SAFETY CIRCUIT. SEE 'LIGHTING FOURTH FLOOR PLAN (PHASE TWO)' THIS SHEET FOR CONTINUATION.
- TO FOURTH FLOOR UNSWITCHED NORMAL POWER. SEE 'LIGHTING FOURTH FLOOR PLAN (PHASE TWO)' THIS SHEET FOR CONTINUATION.
- TO THIRD FLOOR UNSWITCHED LIFE SAFETY CIRCUIT. SEE 'LIGHTING THIRD FLOOR PLAN (PHASE TWO)' THIS SHEET FOR CONTINUATION.
- TO THIRD FLOOR UNSWITCHED NORMAL POWER. SEE 'LIGHTING THIRD FLOOR PLAN (PHASE TWO)' THIS SHEET FOR CONTINUATION.
- TO LIGHT IN EL1 ON SECOND FLOOR. SEE SHEET EL122 FOR CONTINUATION.
- TO LIGHTS IN EL1 ON FOURTH FLOOR. SEE 'LIGHTING FOURTH FLOOR PLAN (PHASE TWO)' THIS SHEET FOR CONTINUATION.
- TO LIGHT IN EL1 ON THIRD FLOOR. SEE 'LIGHTING THIRD FLOOR PLAN (PHASE TWO)' THIS SHEET FOR CONTINUATION.
- PROVIDE ROUGH-IN ONLY FOR WORK REQUIRED IN ELEVATOR SHAFT UNDER ALTERNATE DEDUCT 3.

-	-	CONSULTANTS:	<div><div>FARRIS ENGINEERING</div><div>OMAHA LINCOLN DES MOINES COLORADO SPRINGS</div><div>farris-uso.com</div><div>FE#124014</div></div>		ARCHITECT/ENGINEERS:	<div><div>Kenneth Hahn Architects</div><div>1343 South 75th Street Omaha, NE 68124-1610 402.391.2111 www.kharch.com</div></div> <div>AE Project # 171-001</div>	Drawing Title LIGHTING THIRD AND FOURTH FLOOR PLANS (PHASE TWO)	Project Title BUILD SUPPLY, PROCESSING AND DISTRIBUTION	Project Number 636-121	Office of Construction and Facilities Management
-	-									
-	-									
-	-									
-	-									
-	-									
-	-									
#1 AMENDMENT 002	08-07-14									Department of Veterans Affairs
Revisions	Date									