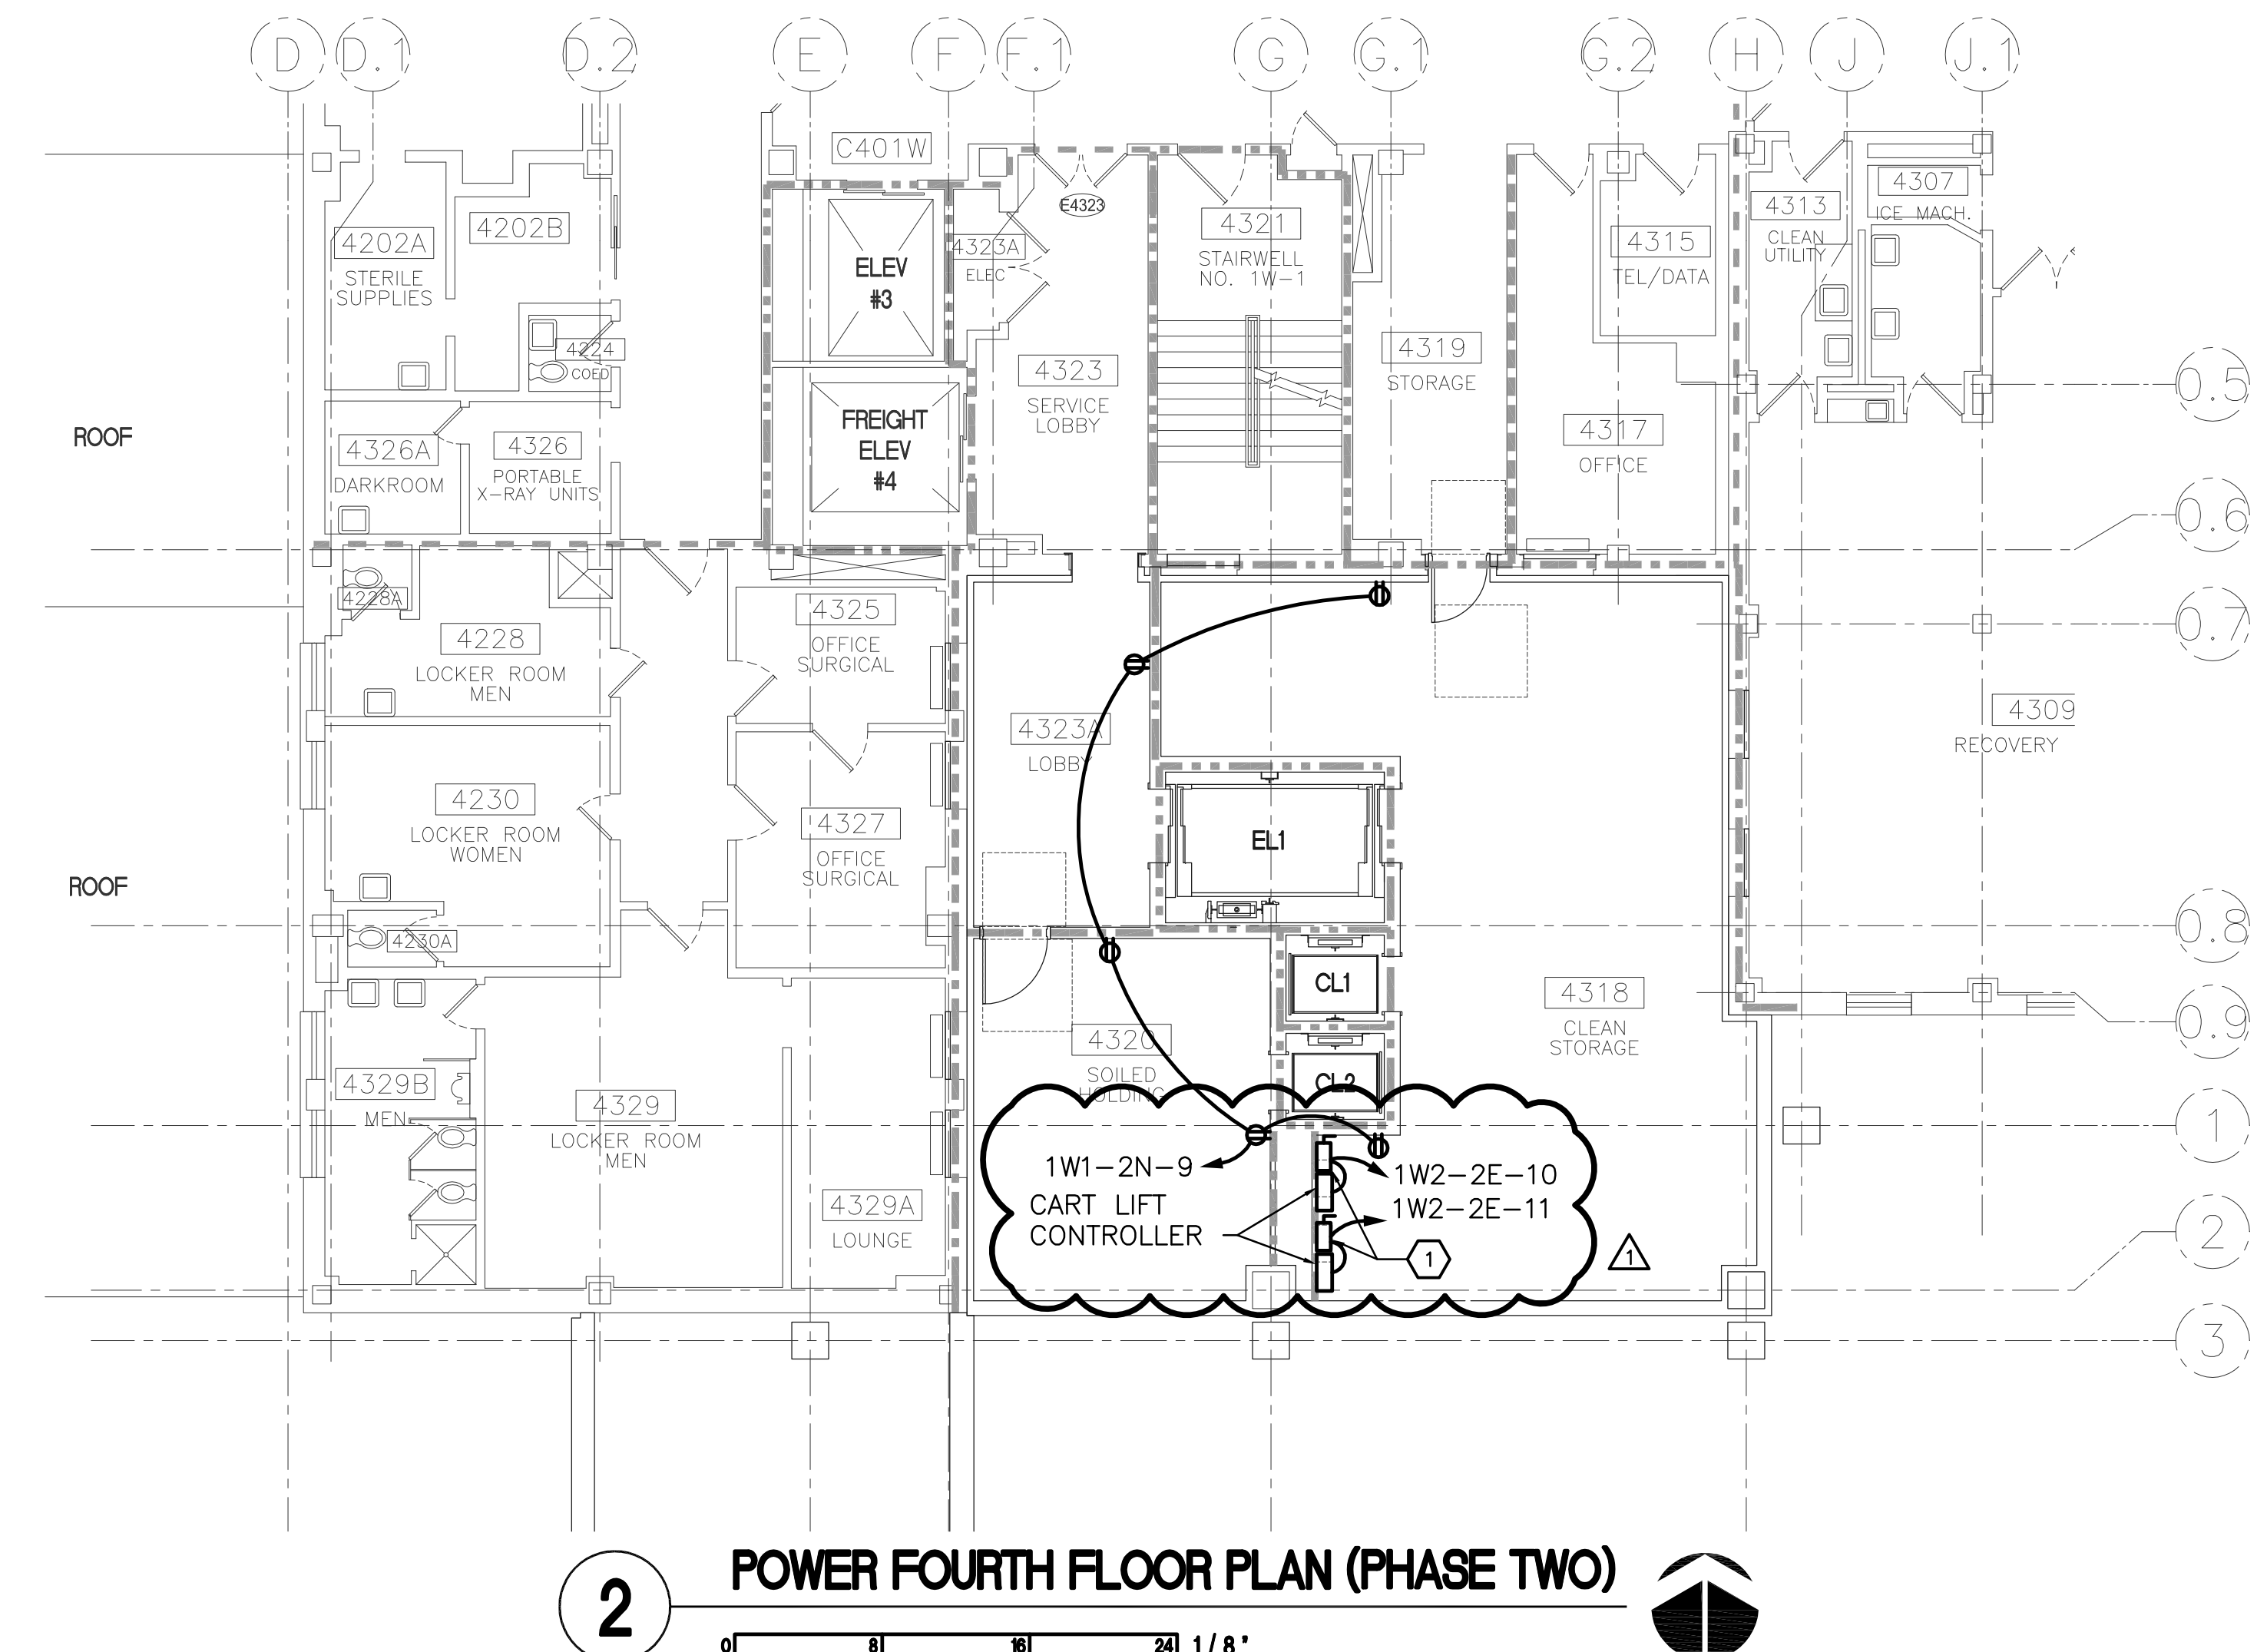


1 BUSSMAN POWER MODULE, OR EQUAL, PS3 T48 R1 K B F3 30A, 480V, 3 PHASE WITH FIRE SAFETY INTERFACE RELAY, KEY TEST SWITCH, AND AUXILIARY CONTACTS. PROVIDE CLASS 'J' FUSES, COORDINATE SIZE WITH APPROVED ELEVATOR SHOP DRAWINGS.

VA FORM 08-6231