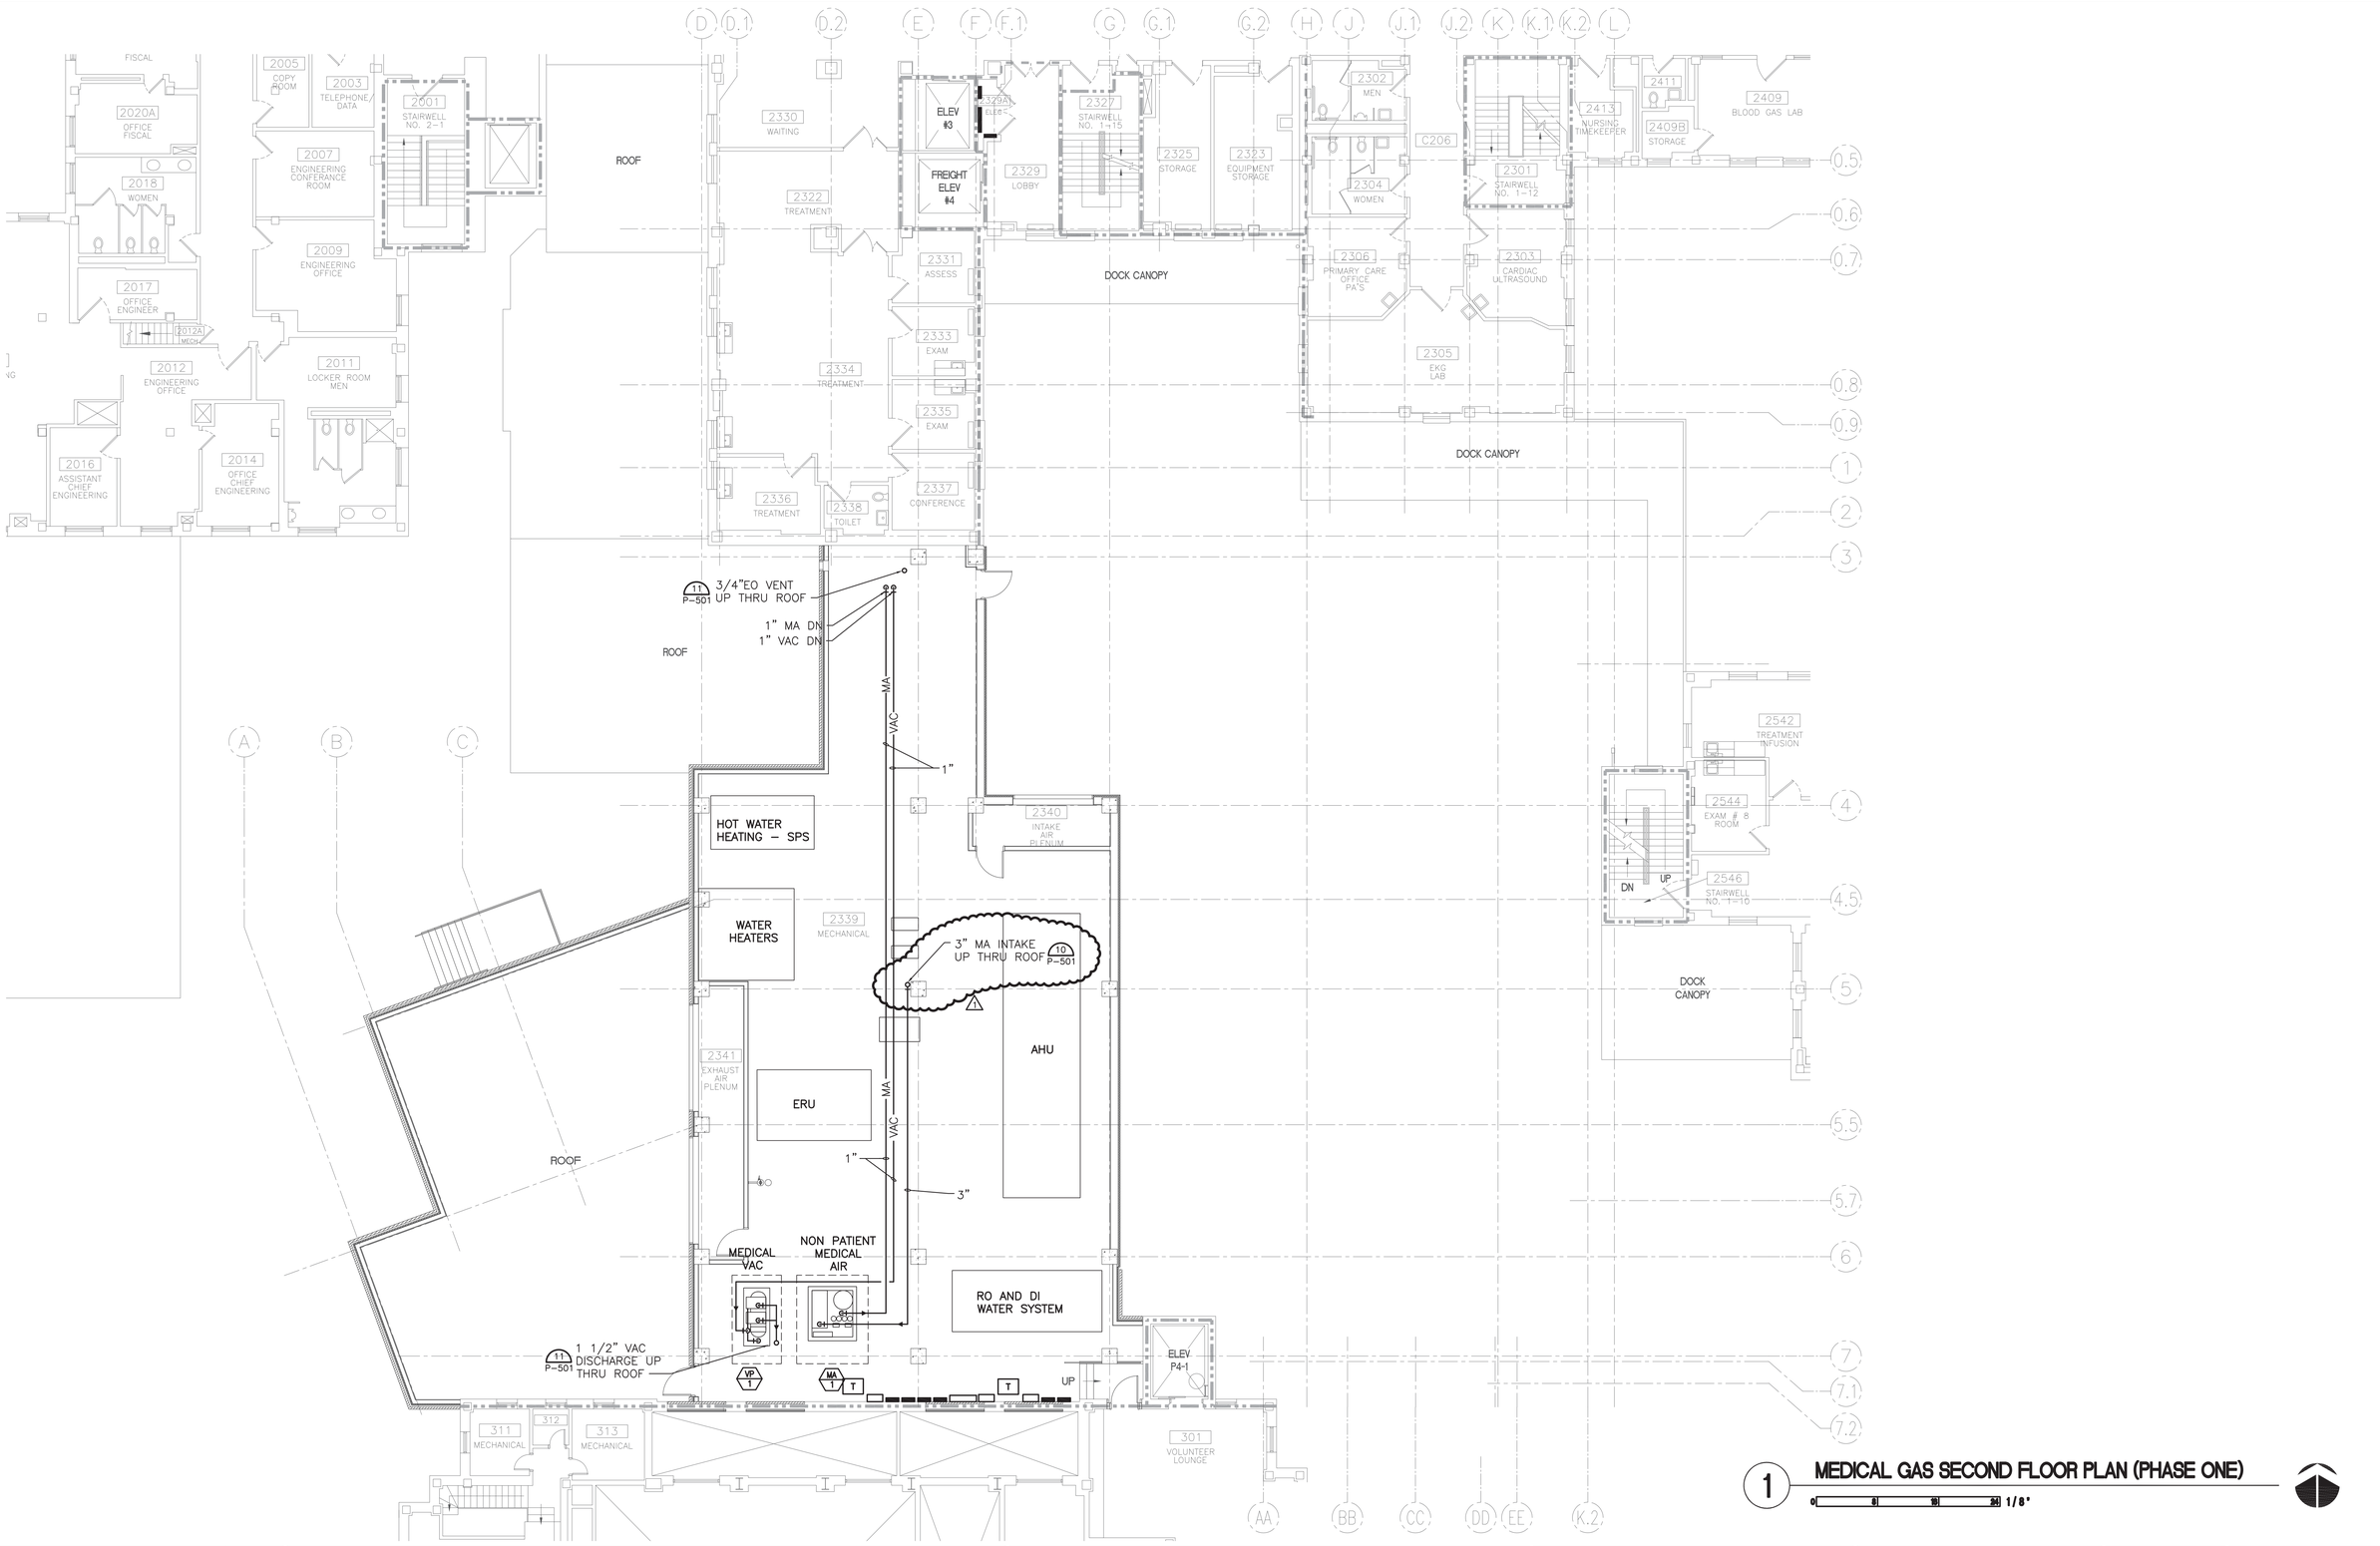

1 MEDICAL GAS SECOND FLOOR PLAN (PHASE ONE)

0 4' 8' 16' 1/8"

–	–
–	–
–	–
–	–
–	–
–	–
–	–
–	–
–	–
#1	05-30-14
Revisions:	Date

CONSULTANTS:

FARRIS ENGINEERING
OMAHA | LINCOLN | DES MOINES | COLORADO SPRINGS
farris-use.com
FE#124014

ARCHITECT/ENGINEERS:

Kenneth Hahn Architects
1343 South 75th Street | Omaha, NE 68124-1610 | 402.391.2111 | www.kharch.com

AE Project # 171-001

Drawing Title: MEDICAL GAS SECOND FLOOR PLAN (PHASE ONE)

Approved: Project Director

Project Title: BUILD SUPPLY, PROCESSING AND DISTRIBUTION

Location: VAMC DES MOINES IOWA

Date: 13 FEBRUARY 2014 | Checked: JMM | Drawn: MDB

Project Number: 636-121

Building Number: BUILDING 1W

Drawing Number: PL221

Dwg. 137 of 235

Office of Construction and Facilities Management

Department of Veterans Affairs

VA FORM 08-6231

C:\2012\124014\CAD\Plumbing\333_636-121_PL221.dwg 5-27-14 01:54:53 PM HDS

three inches = one foot 6" 0
one and one half inches = one foot 1 6" 0
one inch = one foot 2 6" 0
three quarters inch = one foot 2 6" 0
one half inch = one foot 4 0
three eighths inch = one foot 4 0
one quarter inch = one foot 8 0
one eighth inch = one foot 16 8 4 0