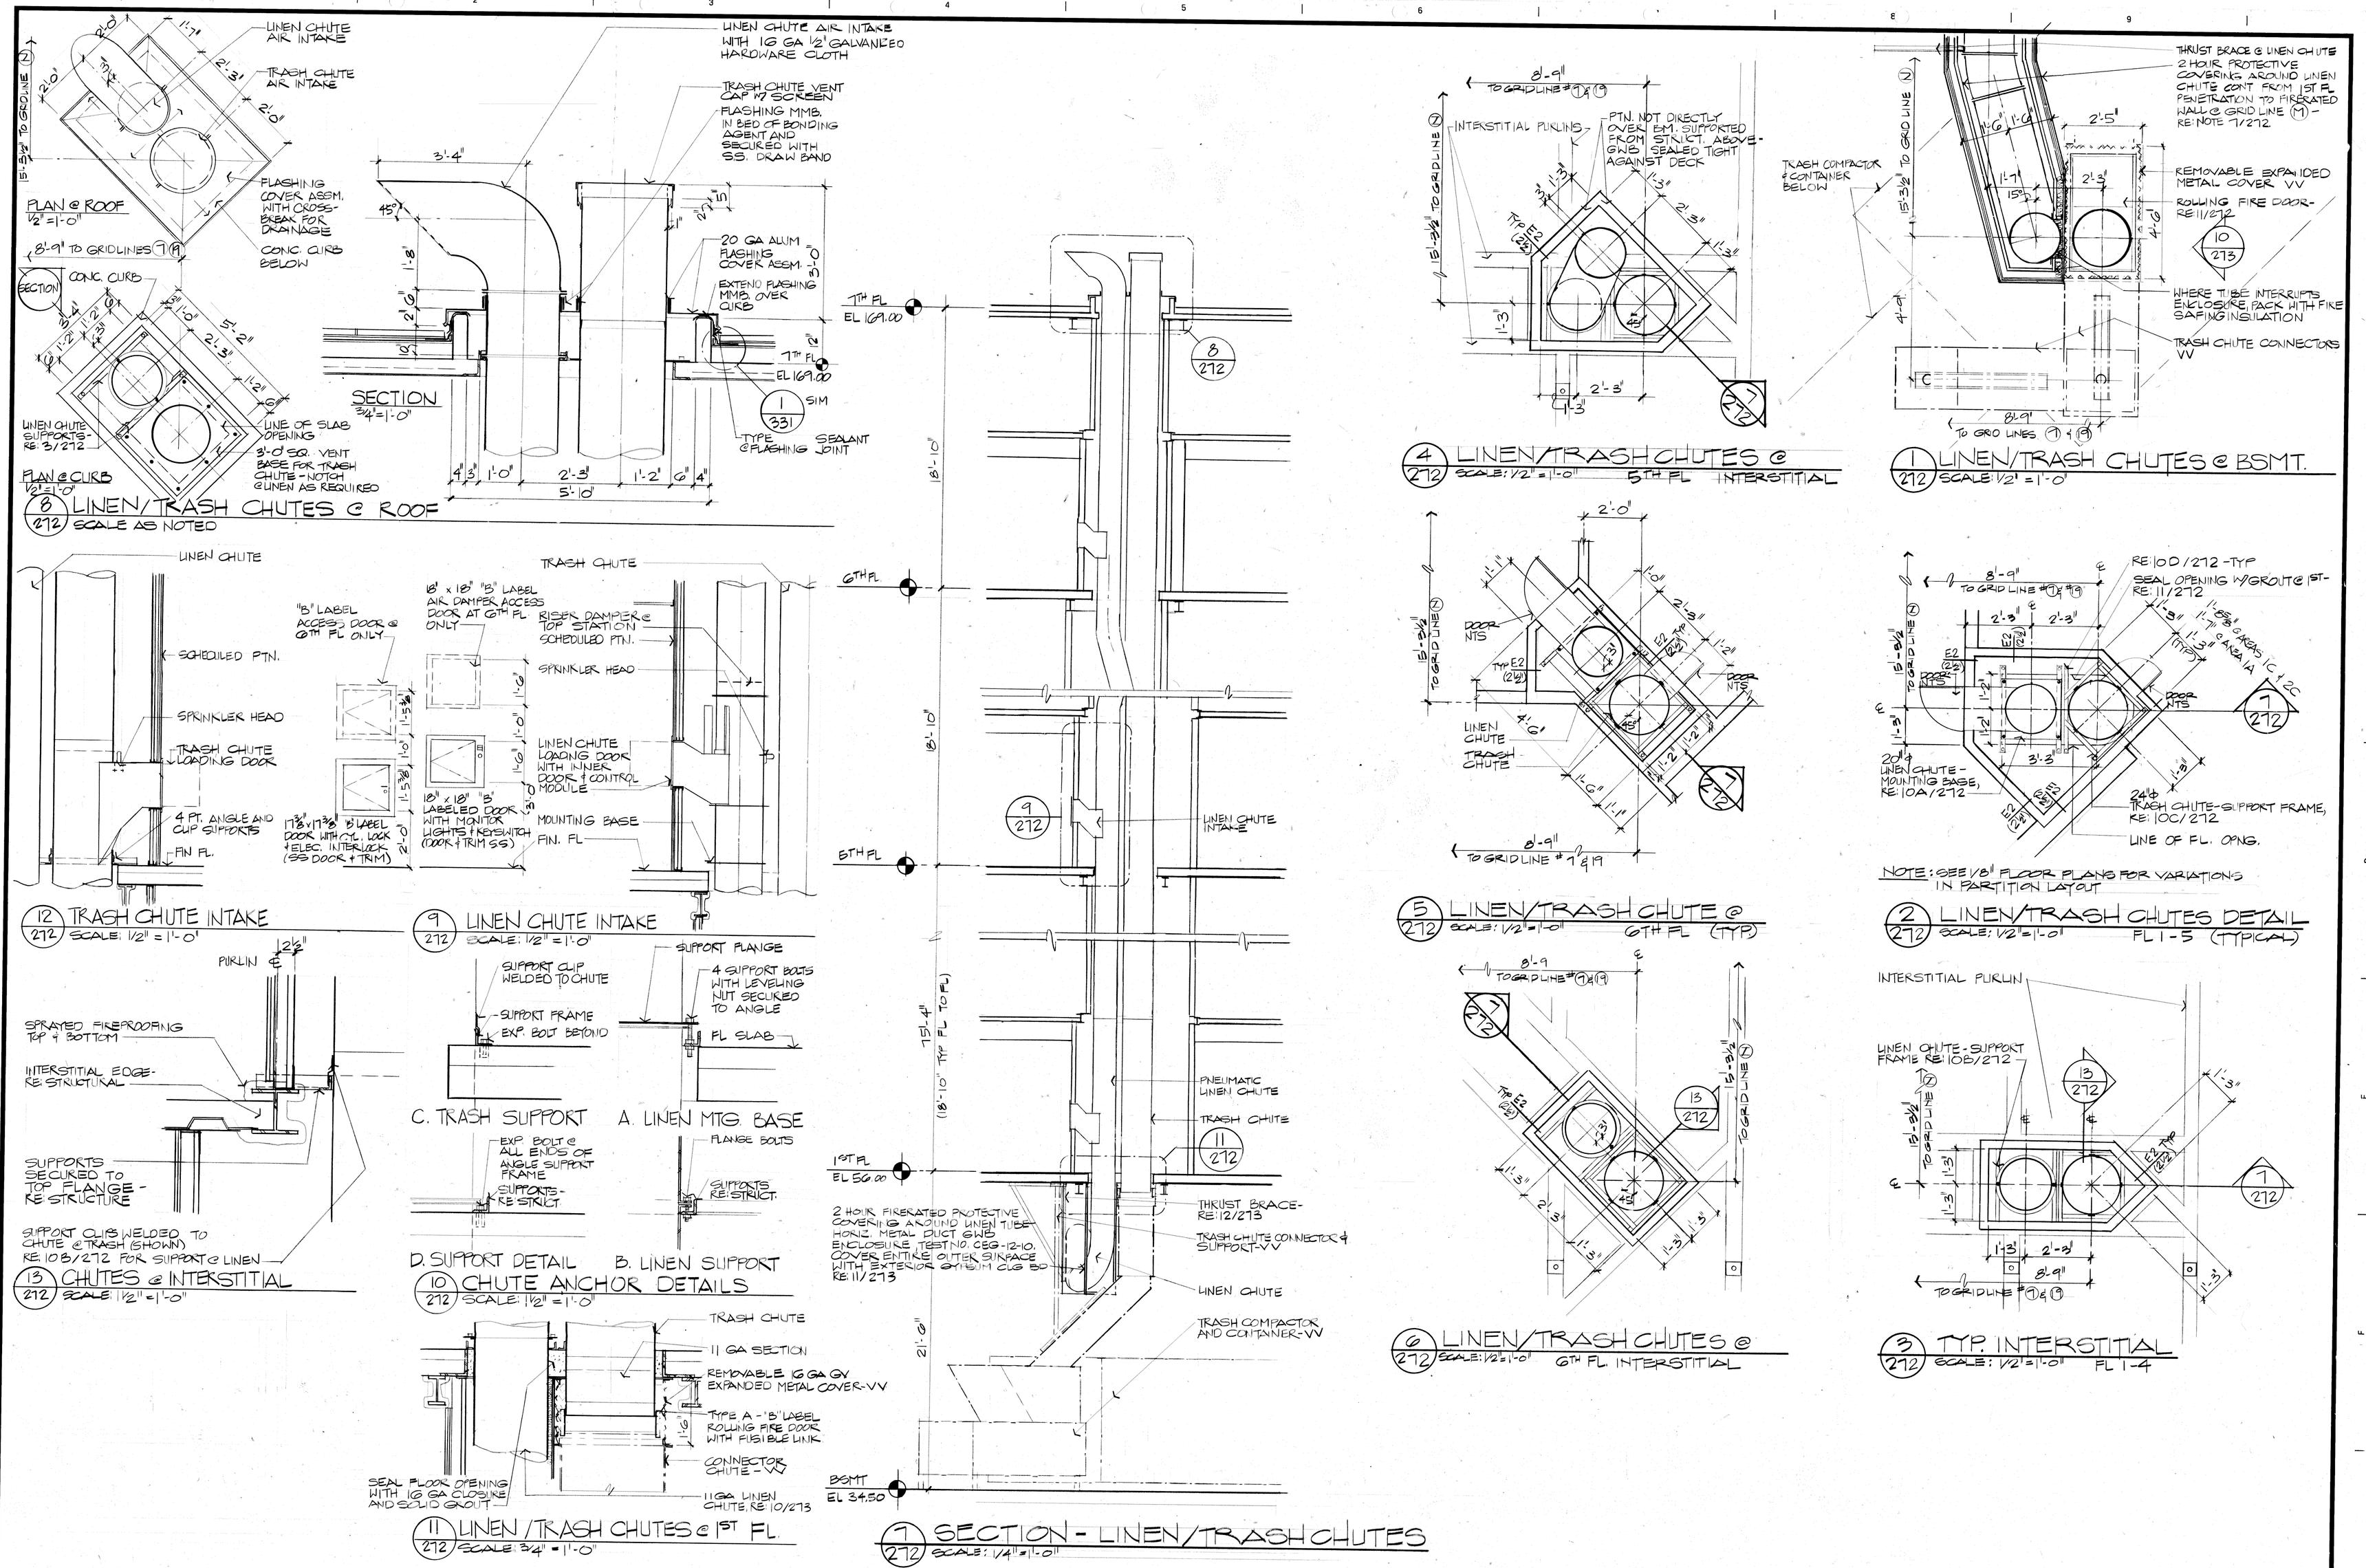

Revisions	Date
RECORD DRAWING	8-3-92

3D/INTERNATIONAL AND STONE, MARRACCINI AND PATTERSON
3D/I • SMP A JOINT VENTURE HOUSTON, TEXAS
1900 WEST LOOP SOUTH, SUITE 200 HOUSTON, TEXAS 77027 TELEPHONE (713) 871-7000

STRUCTURAL AND CIVIL : WALTER P. MOORE AND ASSOCIATES, INCORPORATED
MECHANICAL AND ELECTRICAL : YANDELL & HILLER, INC. AND 3D/INTERNATIONAL

Drawing Title: TRANSPORT DETAILS - TRASH AND LINEN CHUTES
SCALE: AS NOTED
Approved Project Director
Project Title: REPLACEMENT / MODERNIZATION MEDICAL CENTER
Date: 2 JAN. 87
Project No. 580-040
Building Number 100 | Checked FDB | Drawn JW
Location: VAMC HOUSTON, TEXAS
DRAWING NO. 100-272
Dwg 328 01 404
Veterans Administration

TRANSPORT DTL - CHUTES
100-272