


FIRST FLOOR

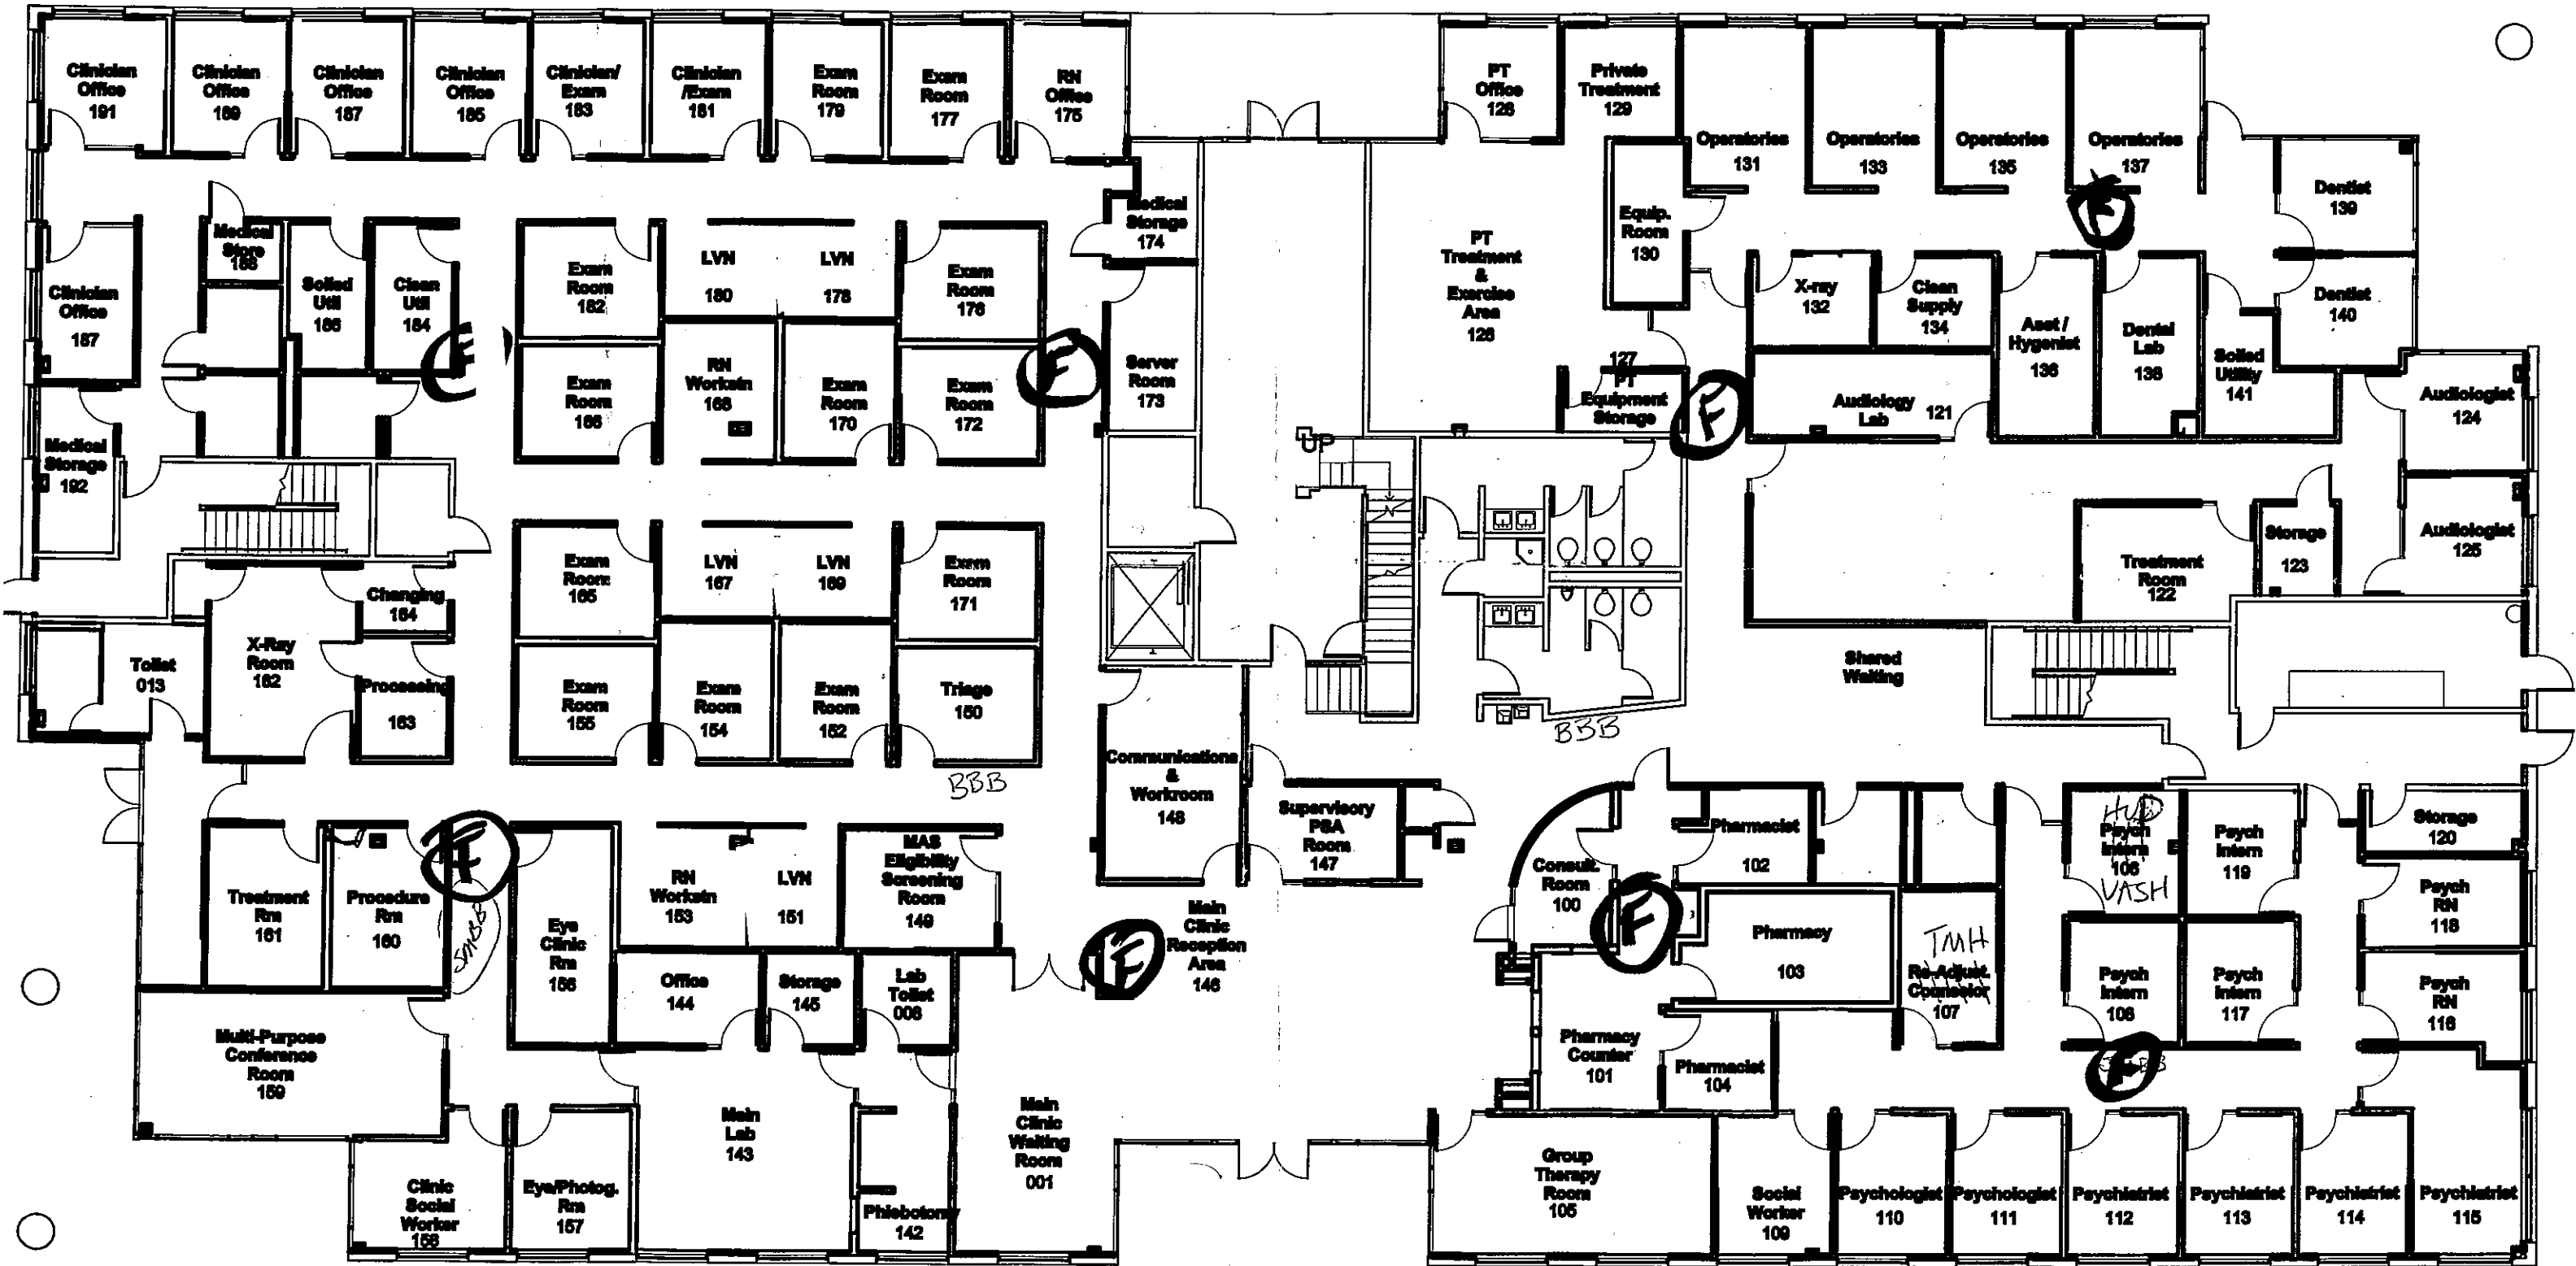

## Second Floor

