

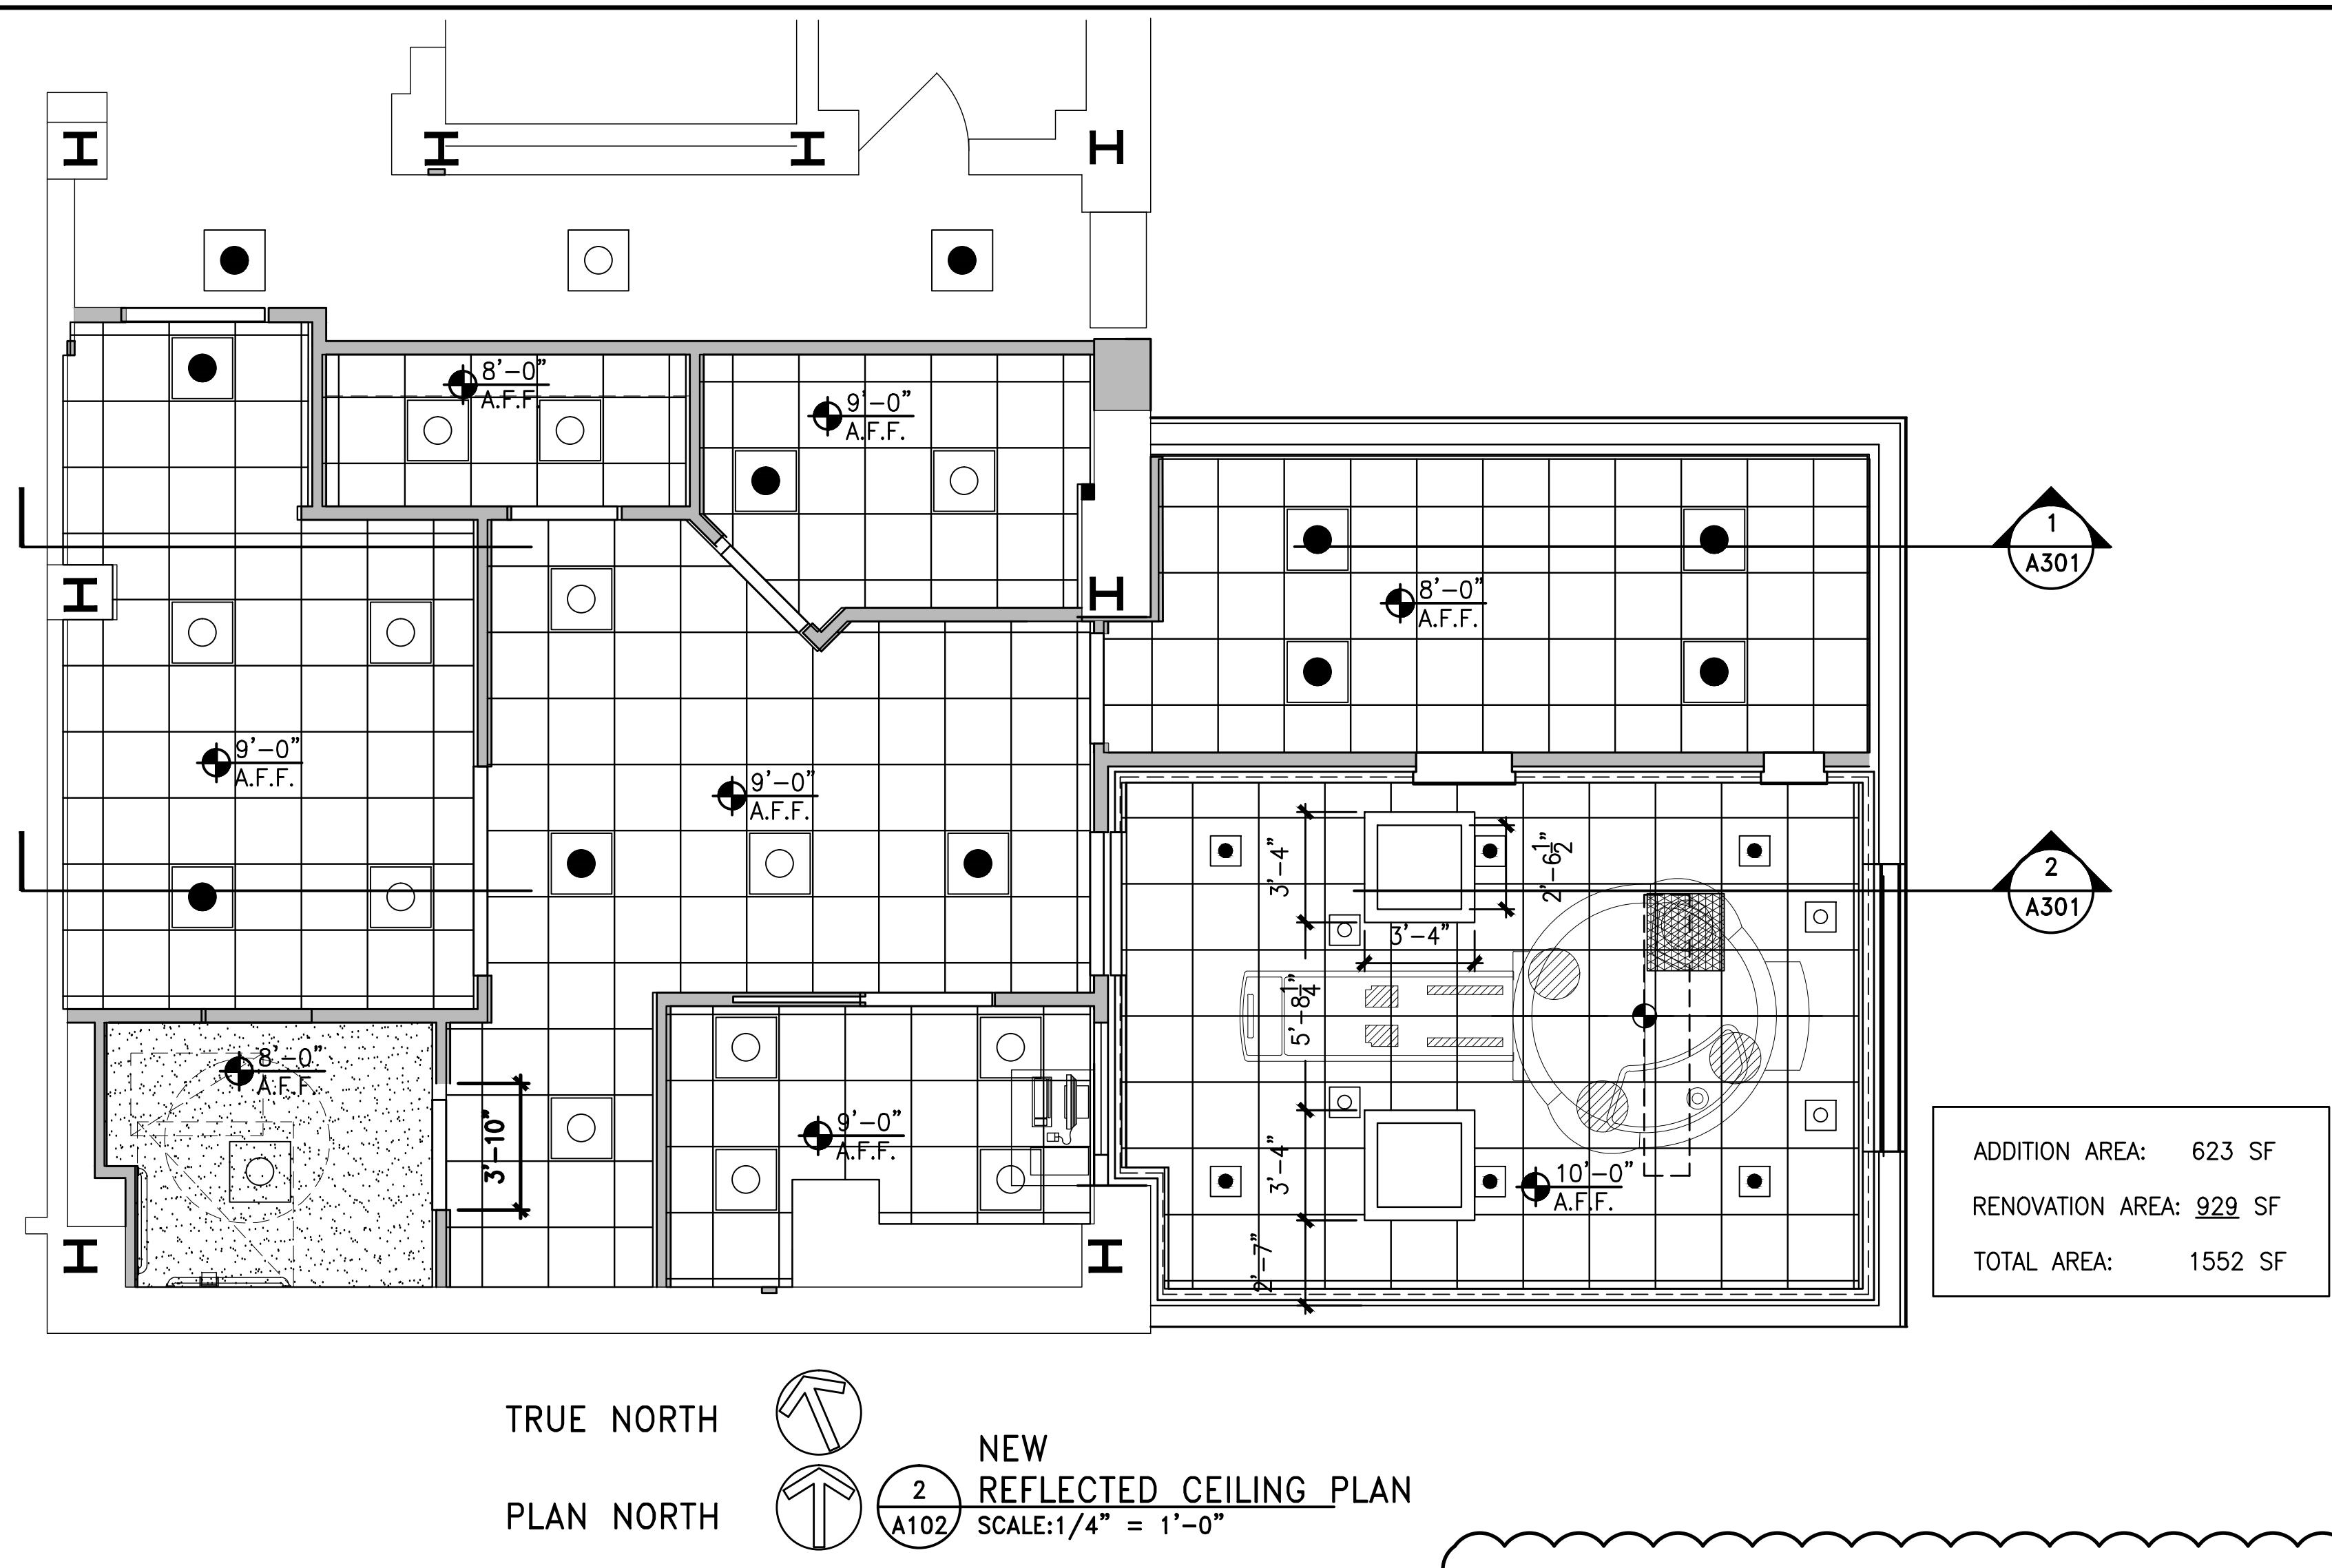
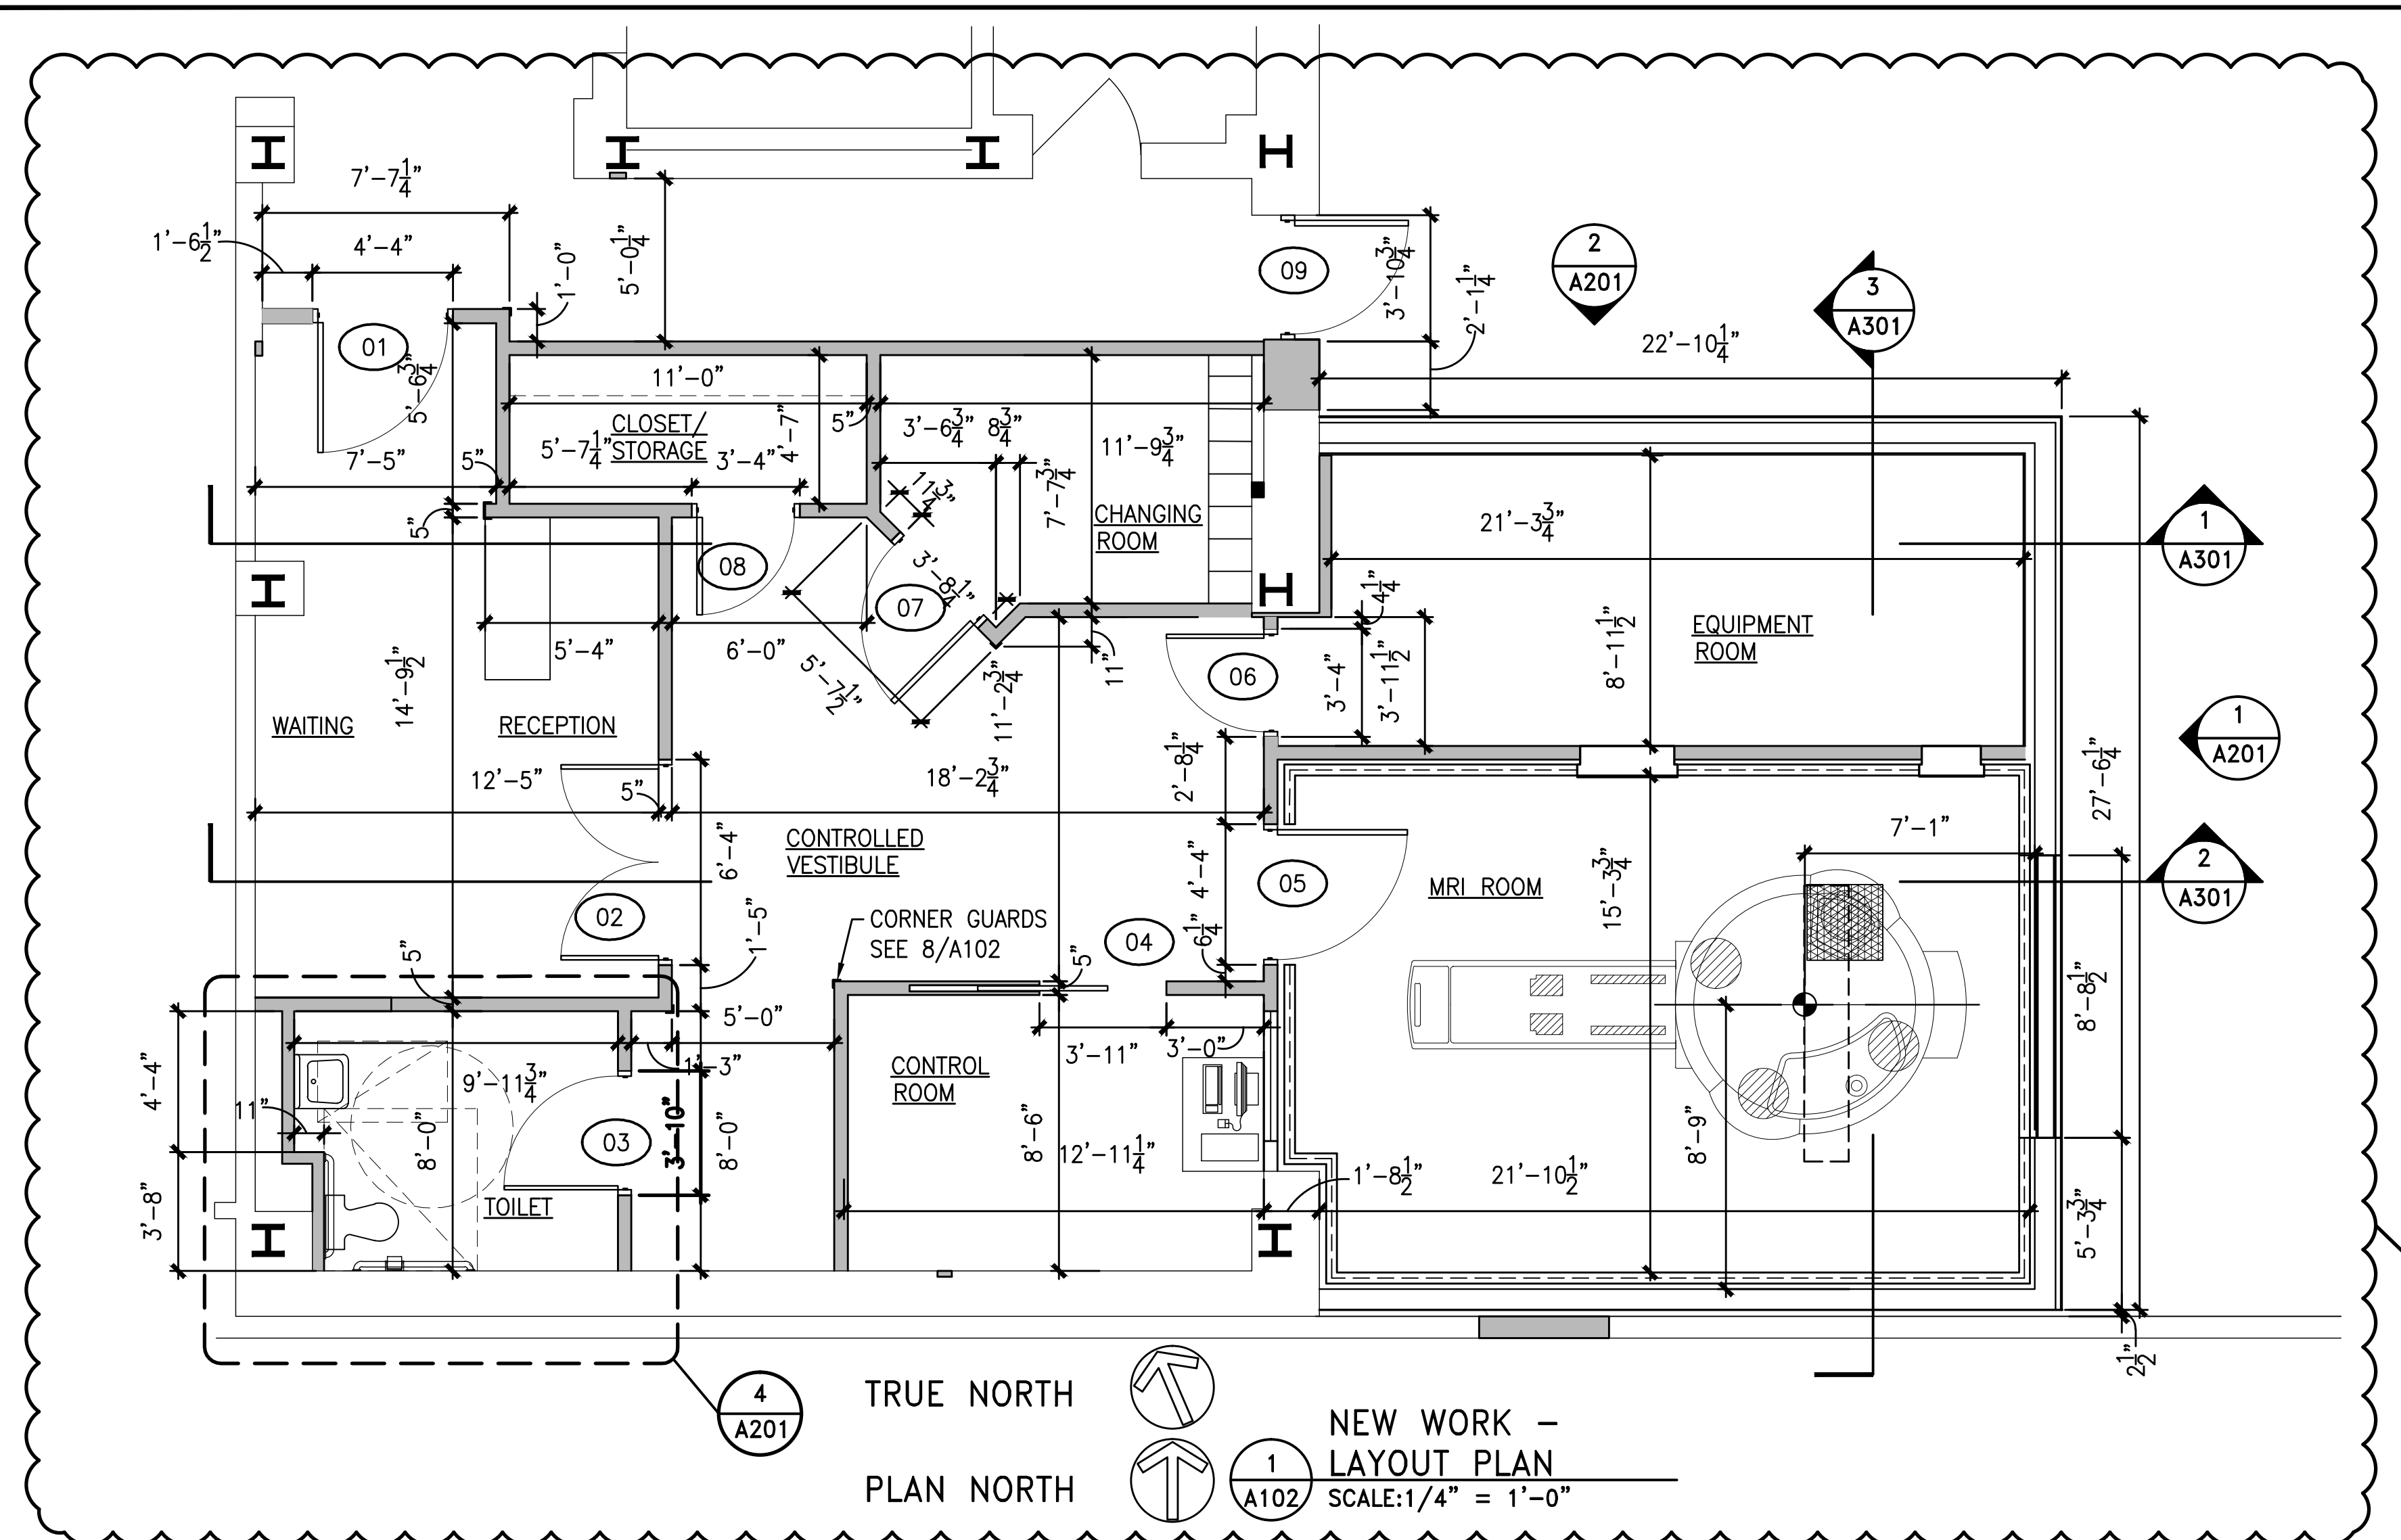
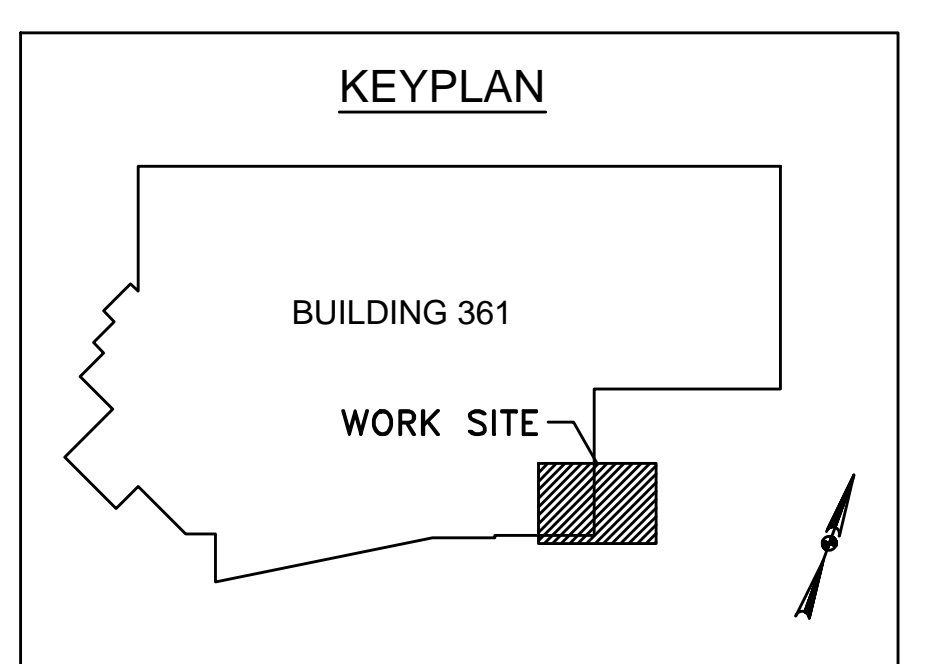
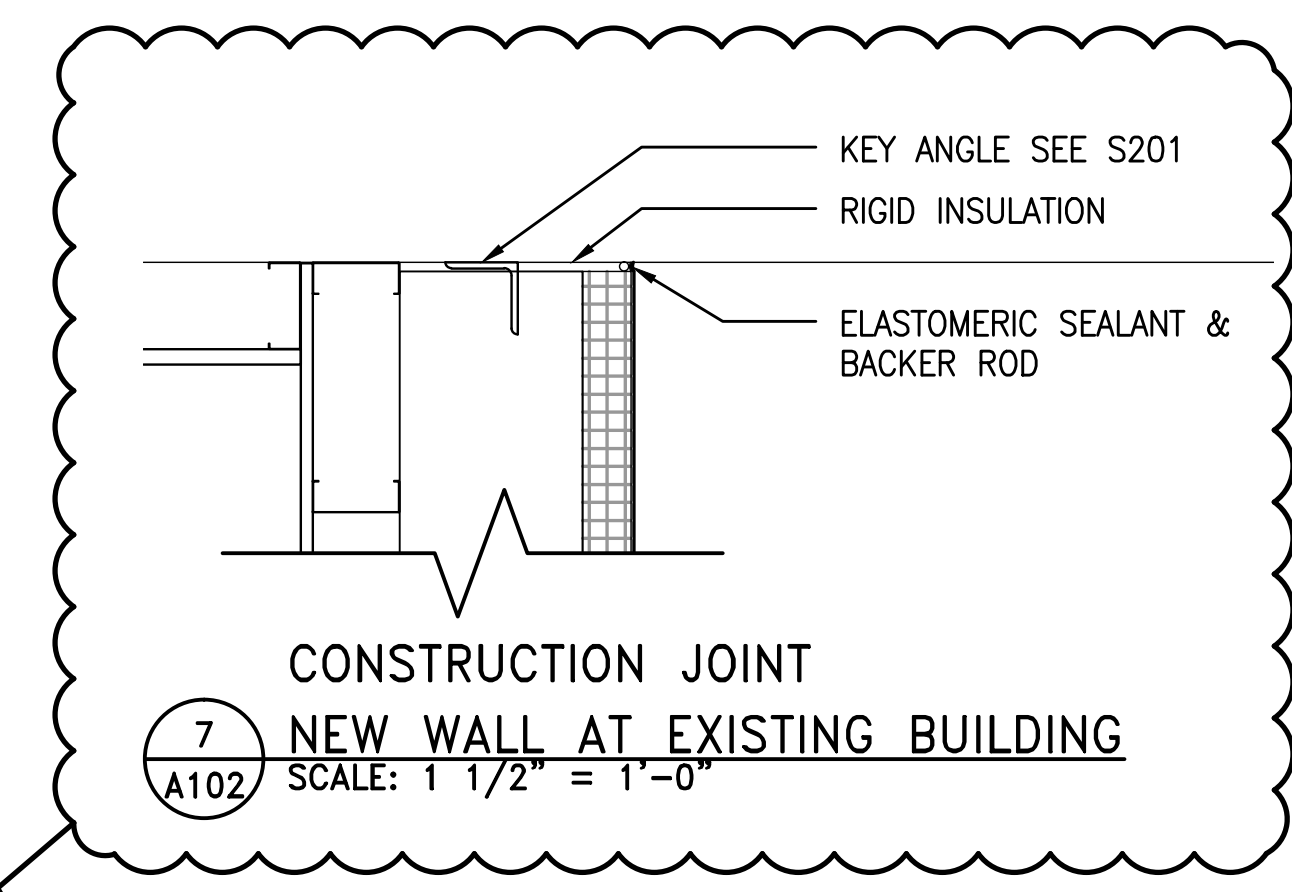
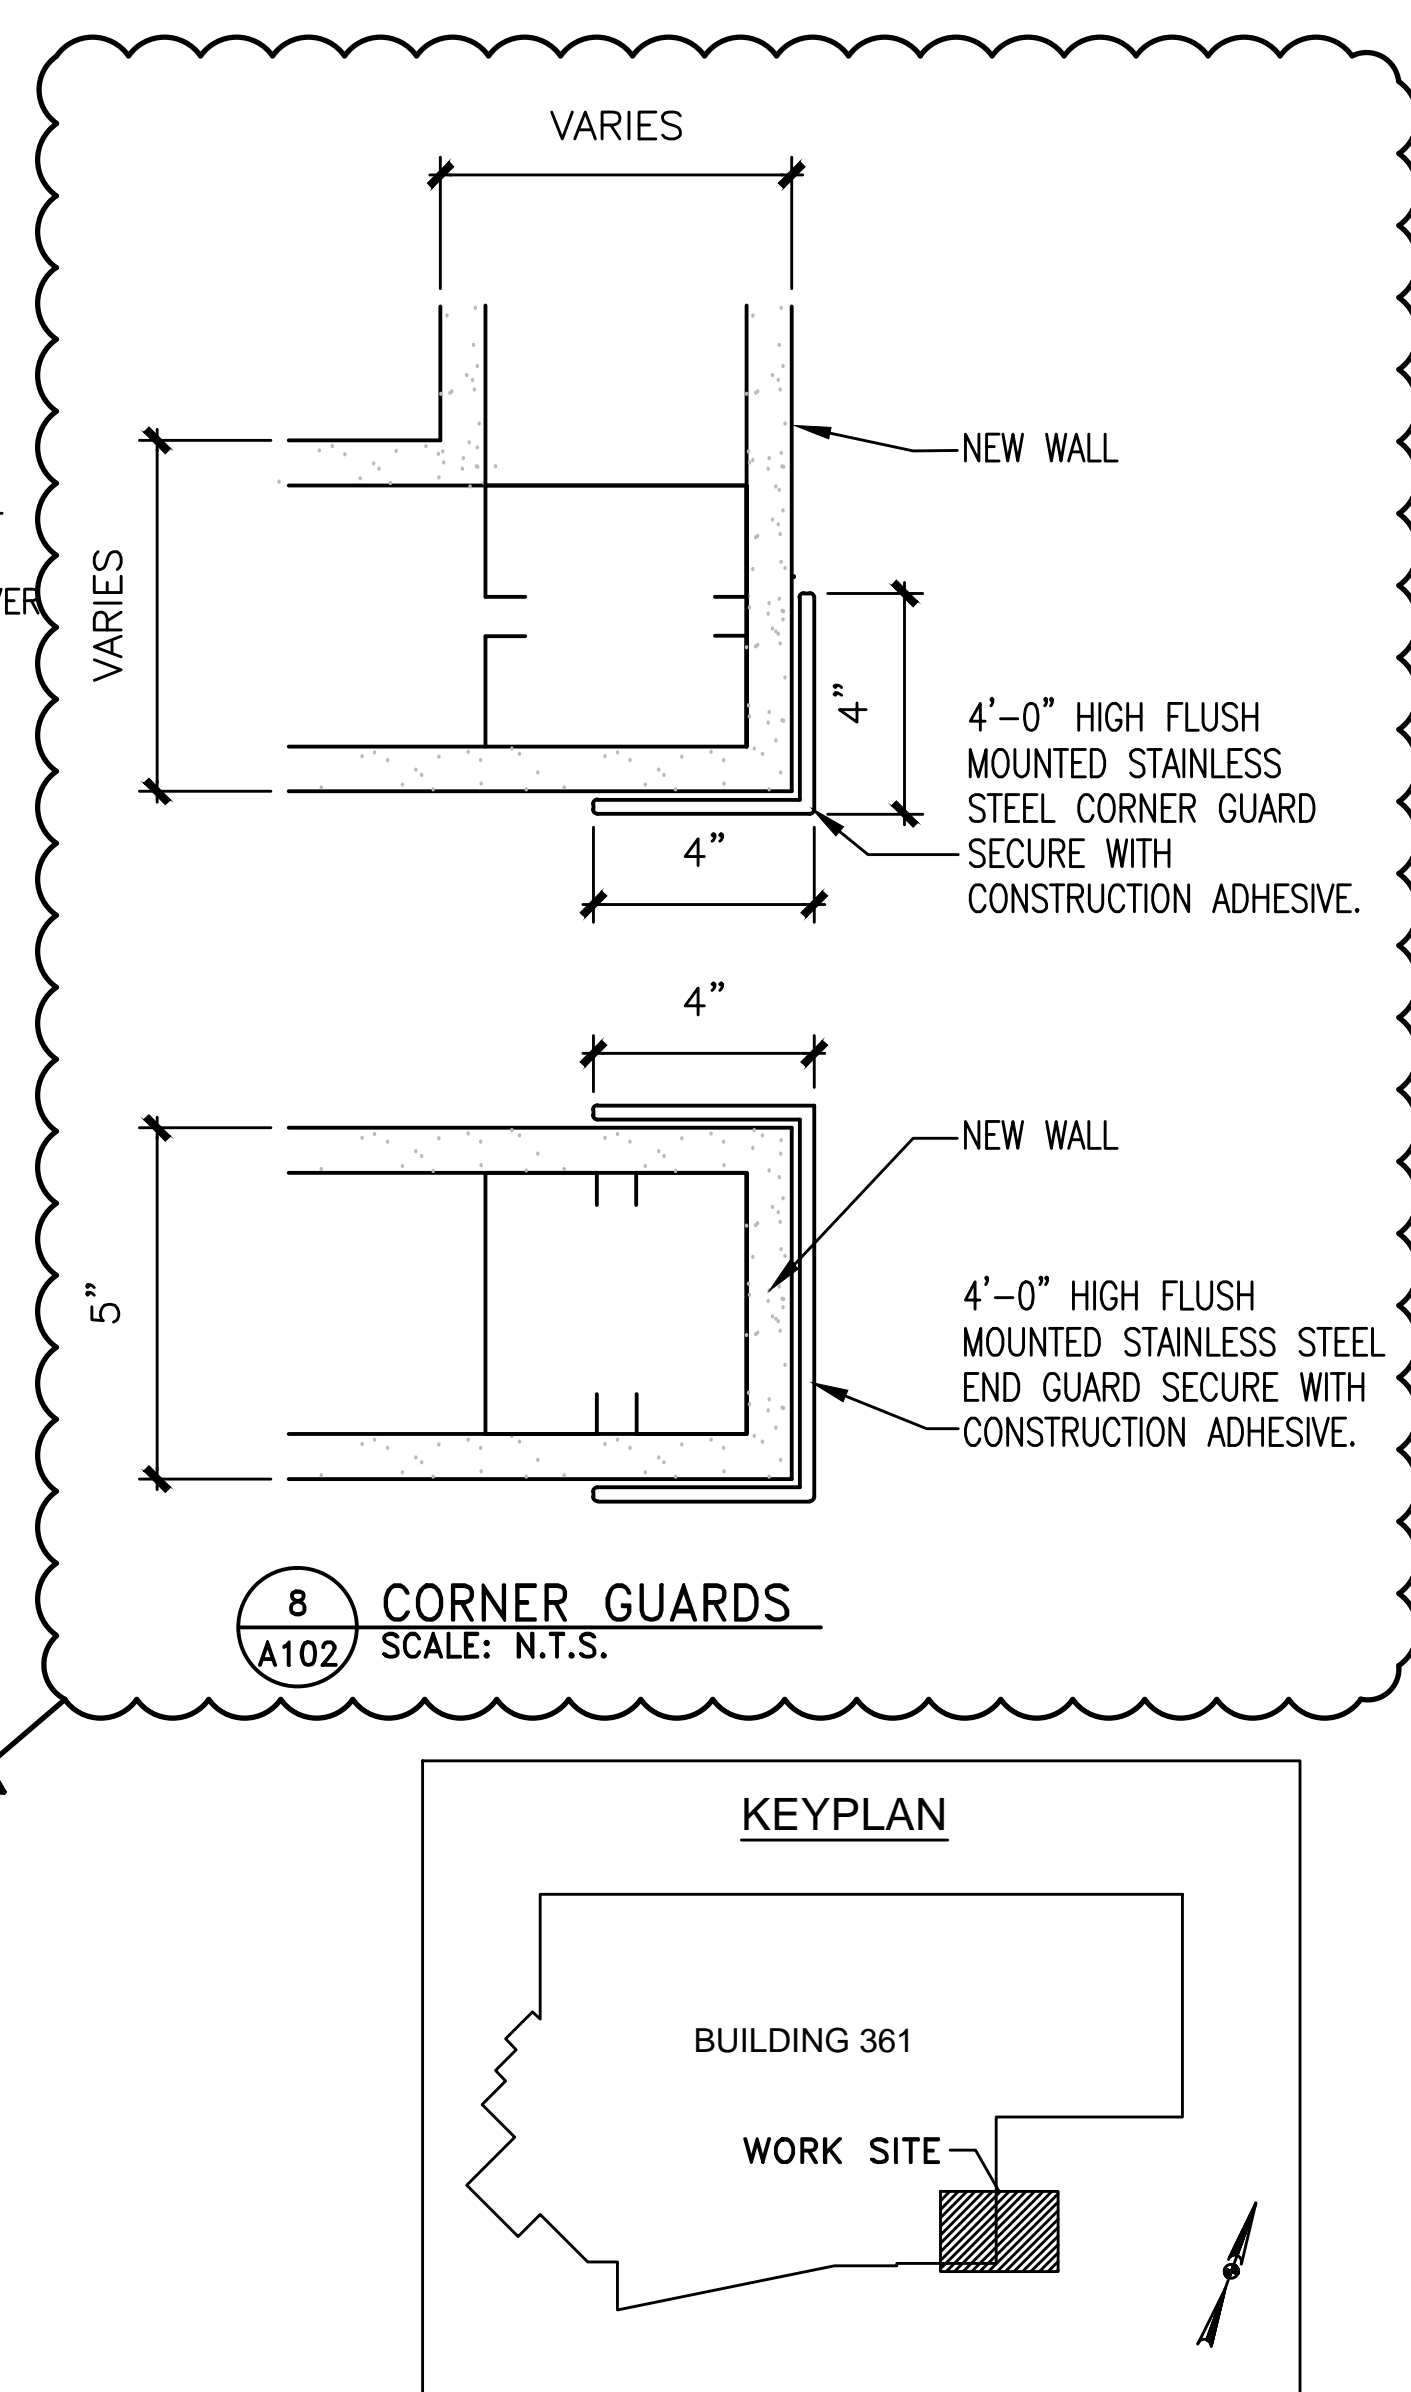
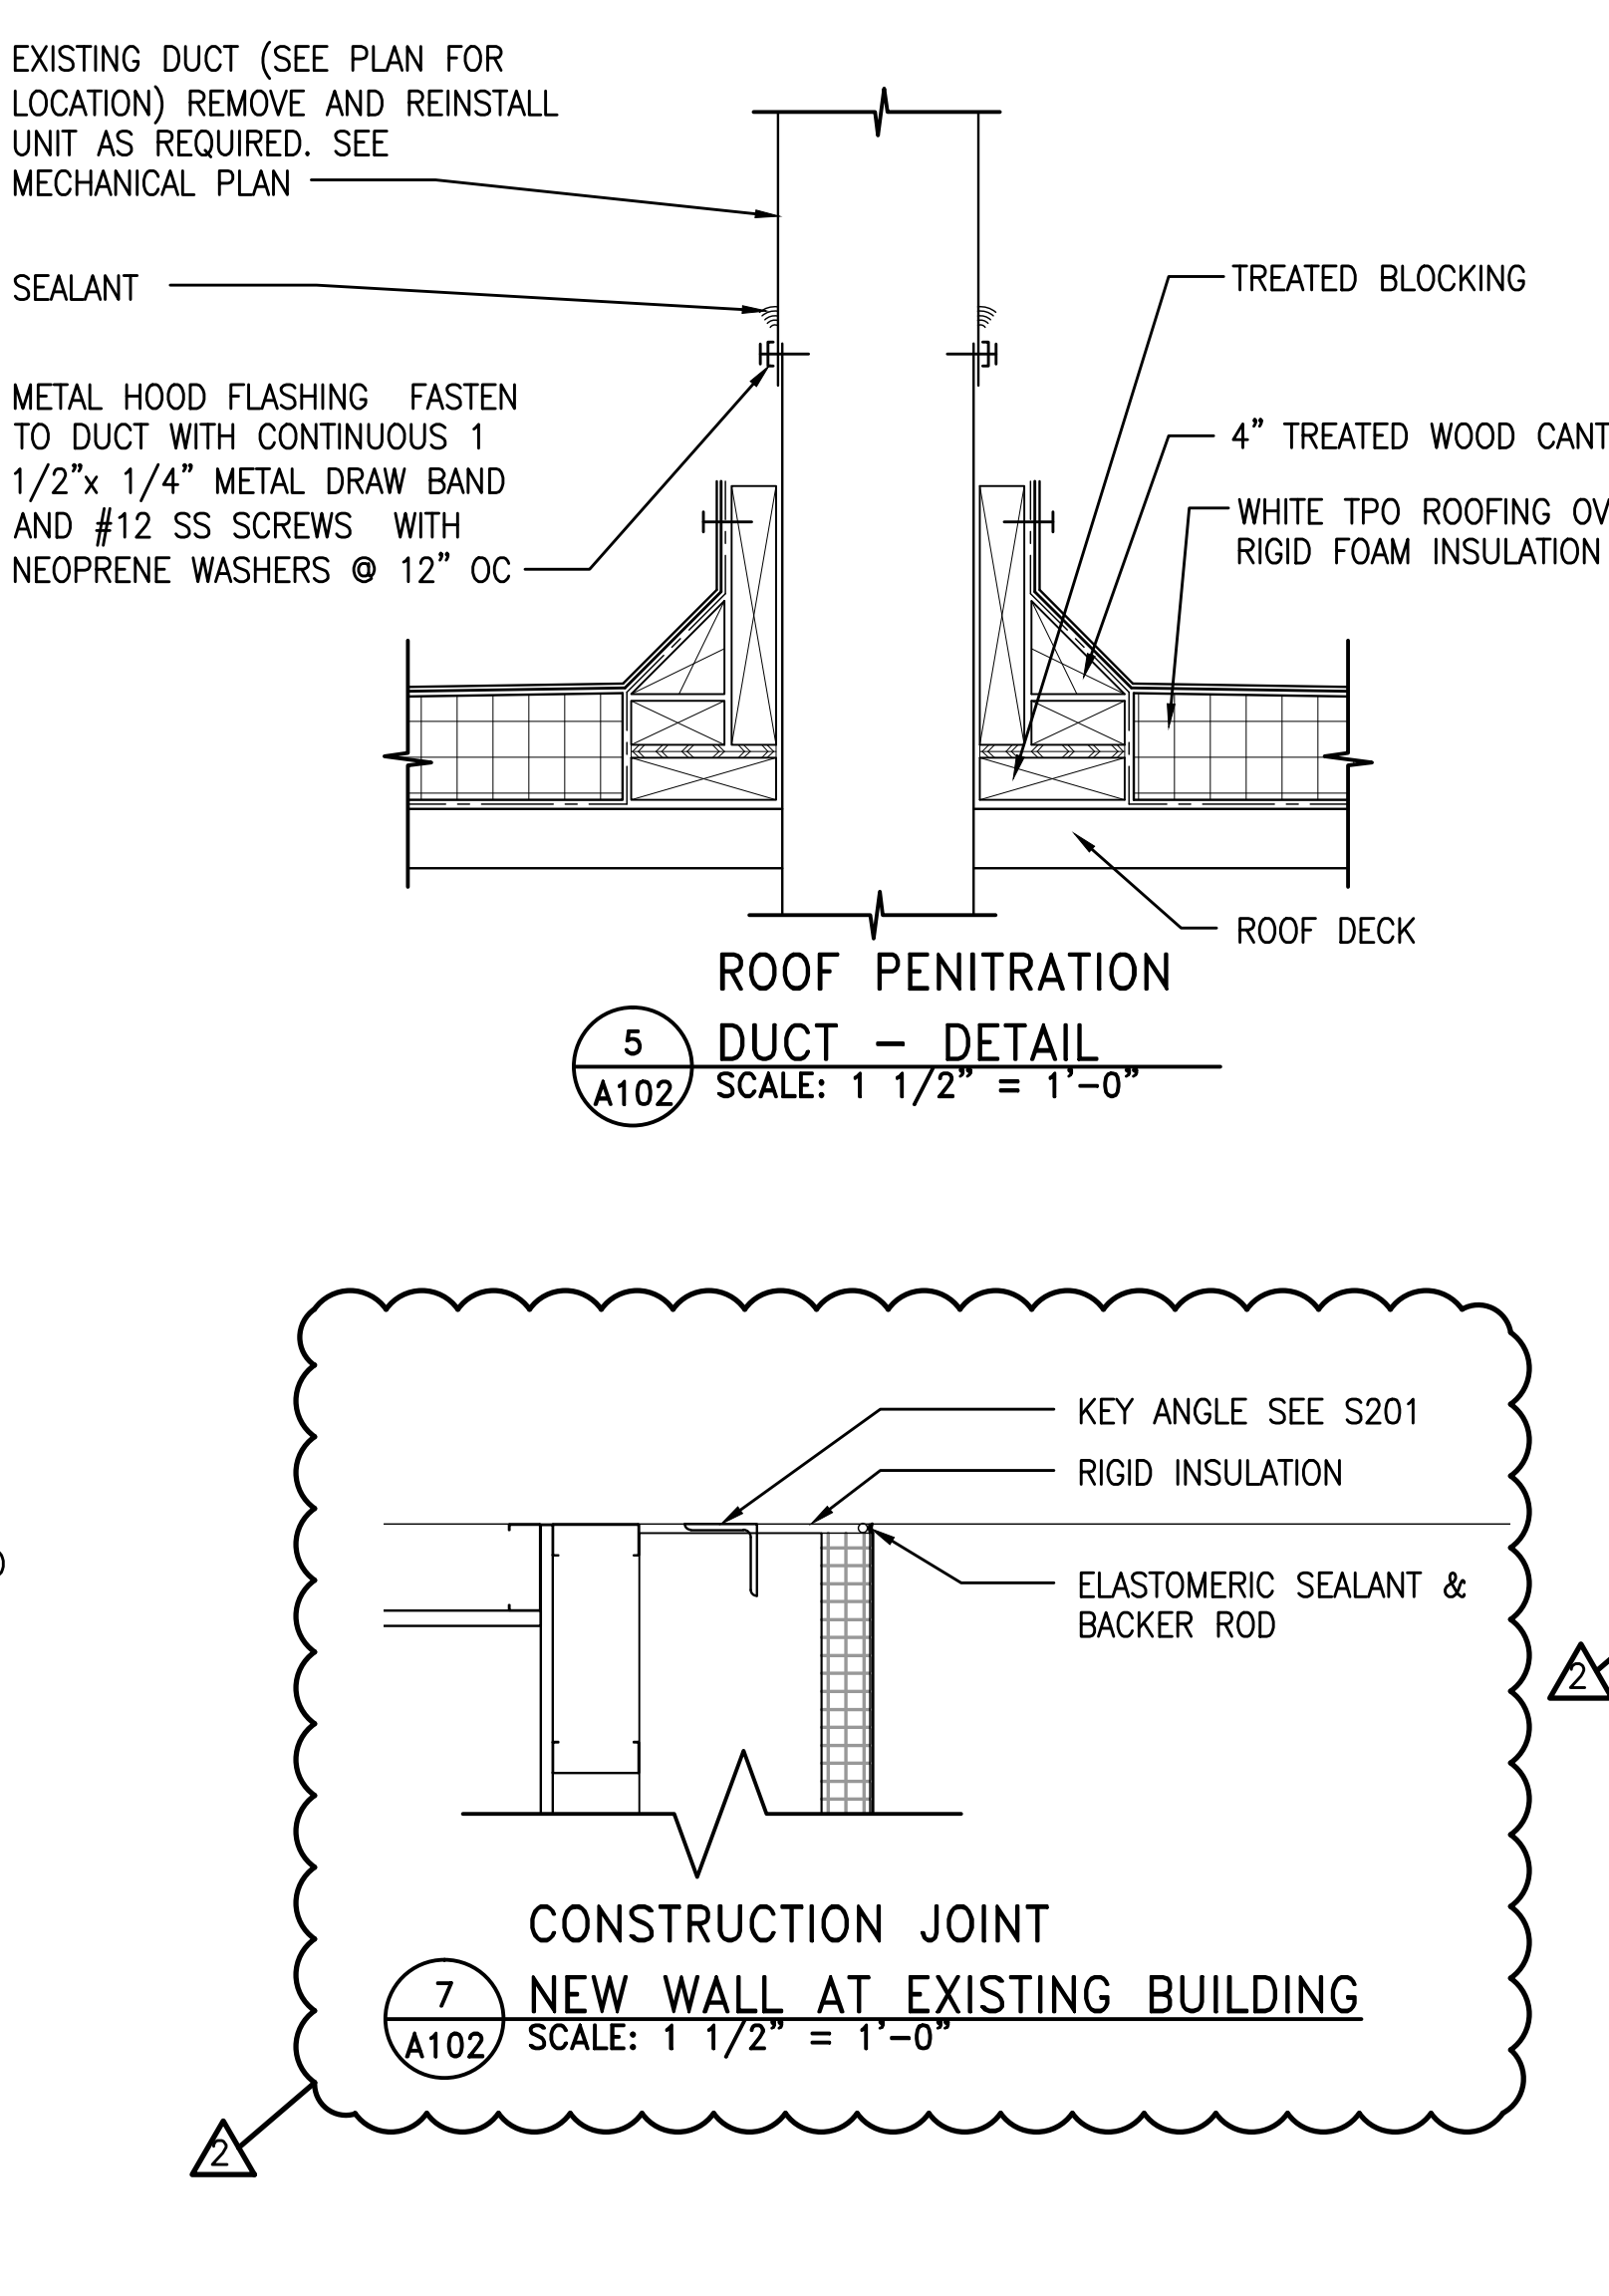


0 1 2 3 4 5 6 7 8 9 10 11 12 13 14 15 16
three inches = one foot
one and one half inch = one foot
one inch = one foot
three-quarters inch = one foot
one-half inch = one foot
three-eighths inch = one foot
one-quarter inch = one foot
one-eighth inch = one foot

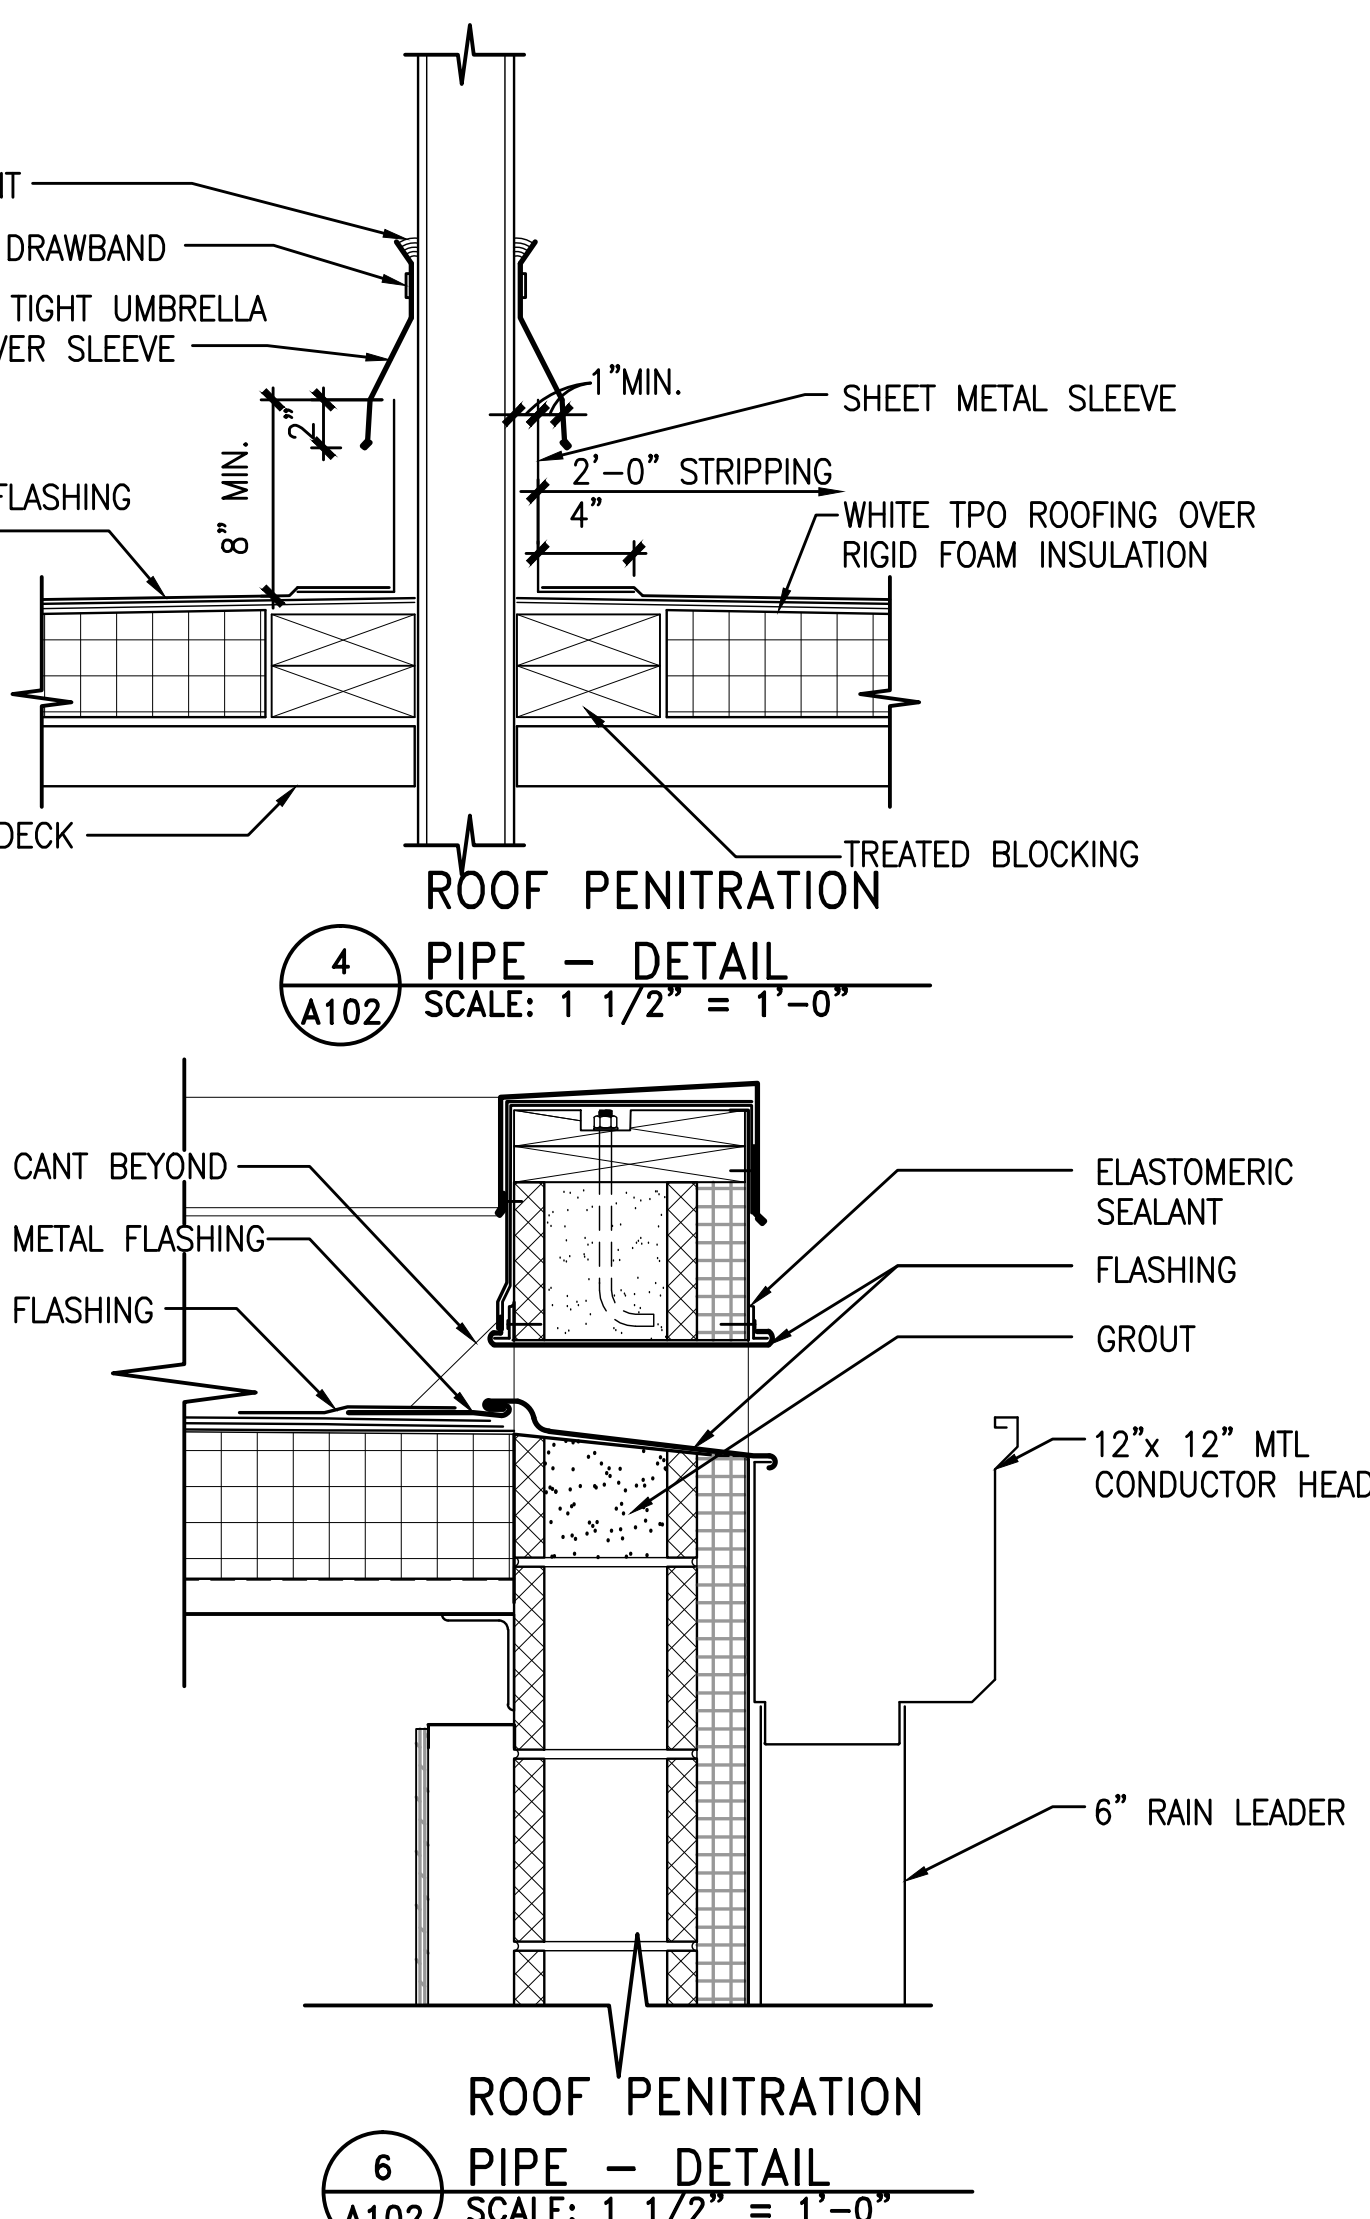

ADDITION AREA: 623 SF
RENOVATION AREA: 929 SF
TOTAL AREA: 1552 SF

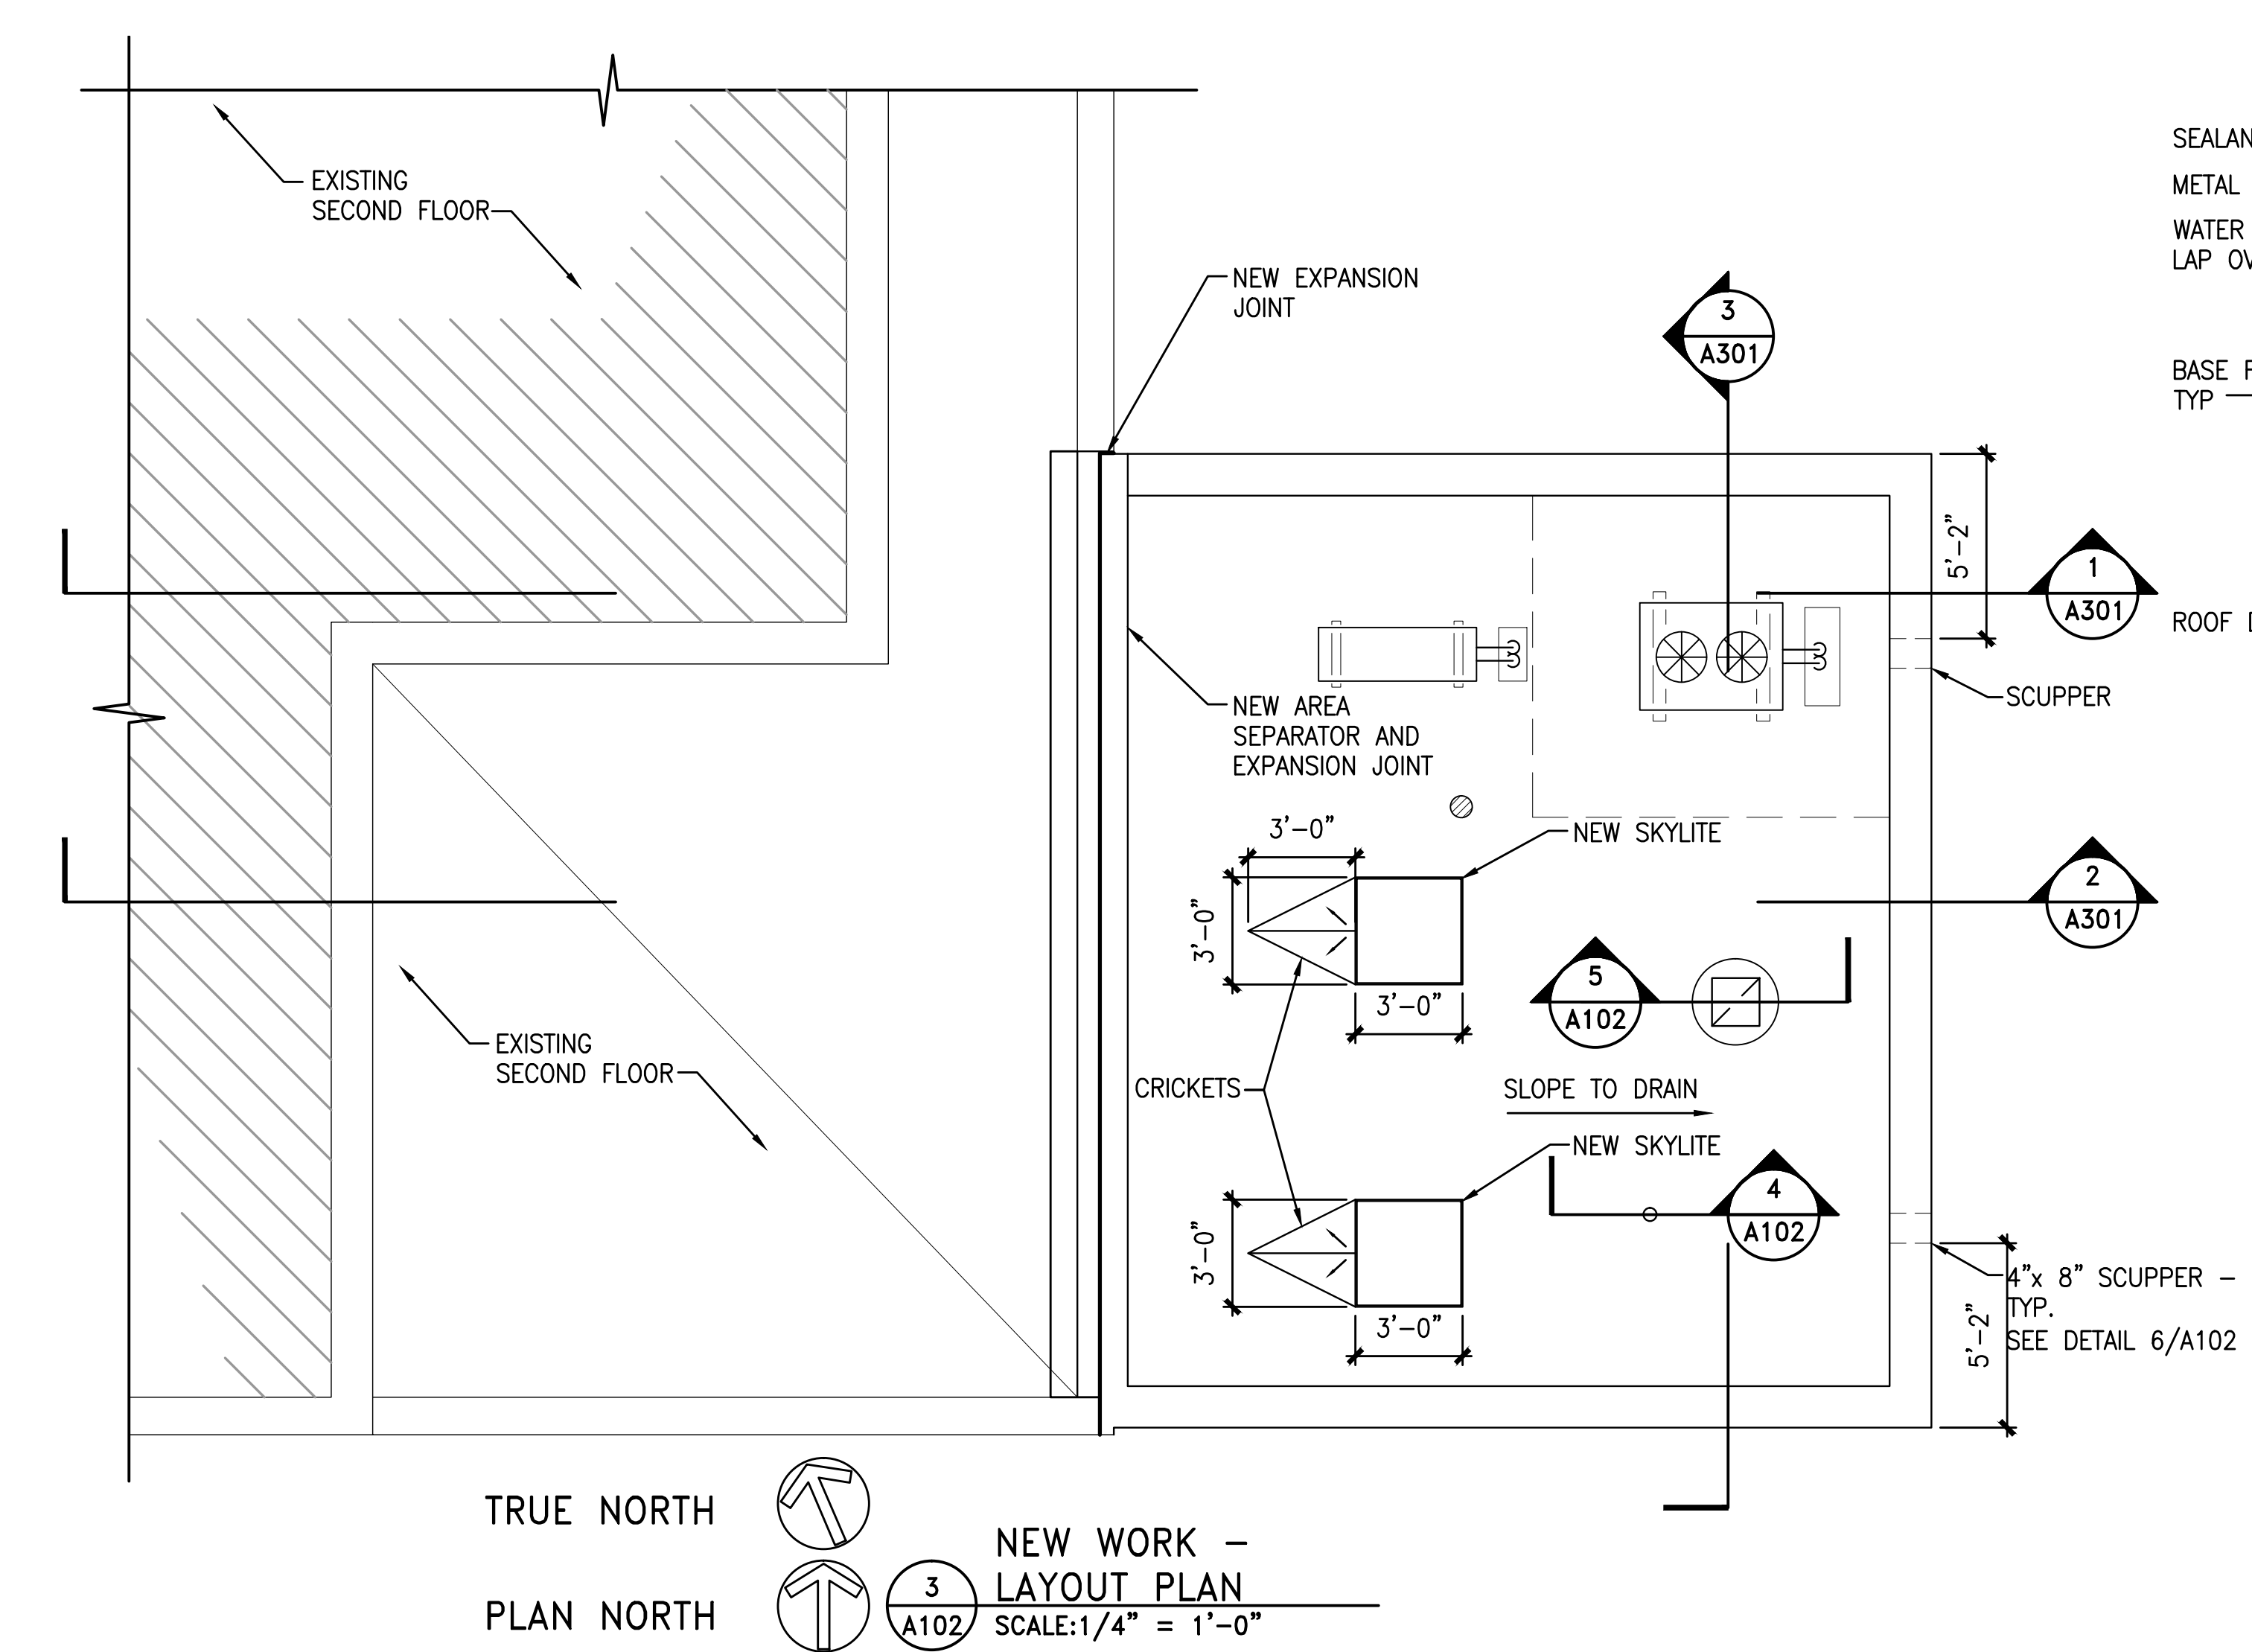

Additions:		Date:		Consultants:		Seal:		Seal:		--	--------------	--

