




1 NEW & EXISTING SPACE - SECTION
 SCALE: 1/4" = 1'-0"

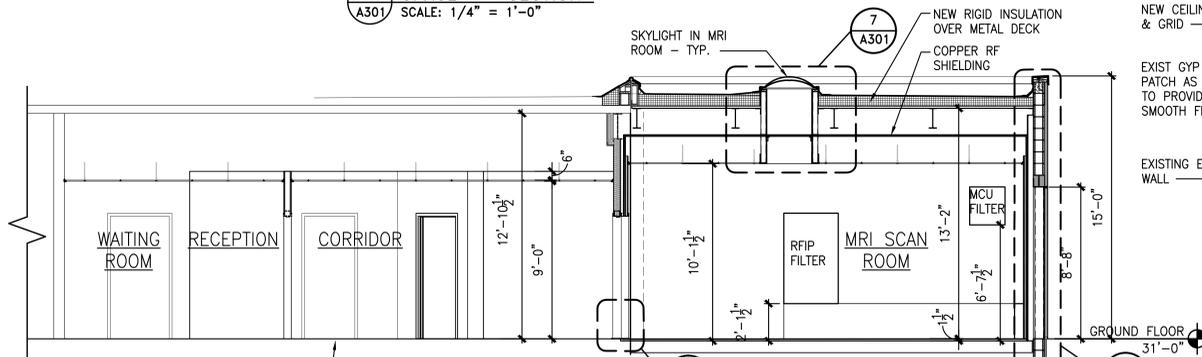

2 NEW & EXISTING SPACE - SECTION
 SCALE: 1/4" = 1'-0"

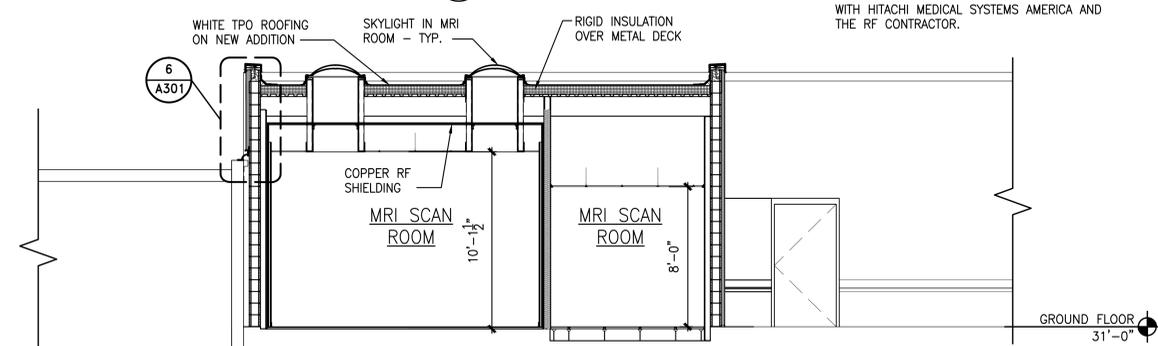


3 MRI ADDITION - SECTION
 SCALE: 1/4" = 1'-0"

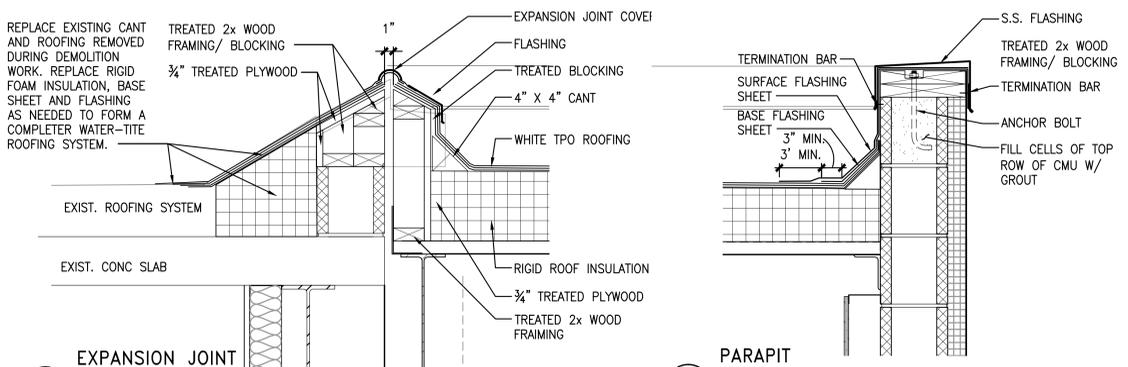


9 EXPANSION JOINT DETAIL
 SCALE: 1 1/2" = 1'-0"


10 PARAPIT DETAIL
 SCALE: 1 1/2" = 1'-0"

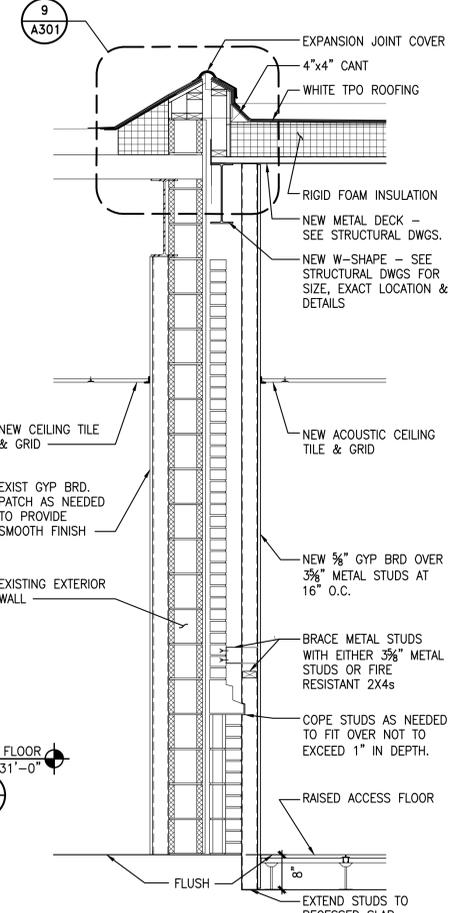


4 WALL - SECTION
 SCALE: 3/4" = 1'-0"

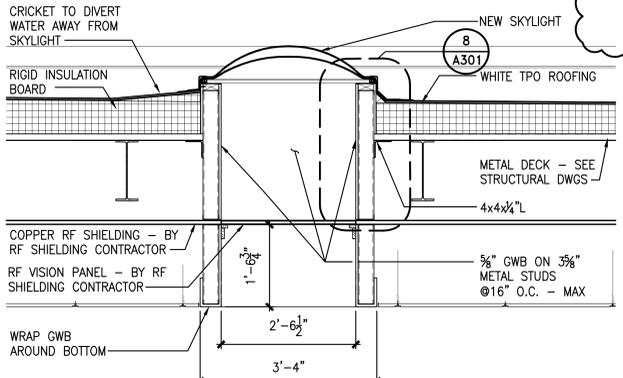


7 SKYLIGHT - SECTION
 SCALE: 3/4" = 1'-0"

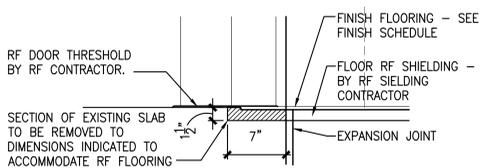


11 RF DOOR THRESHOLD
 SCALE: 1 1/2" = 1'-0"

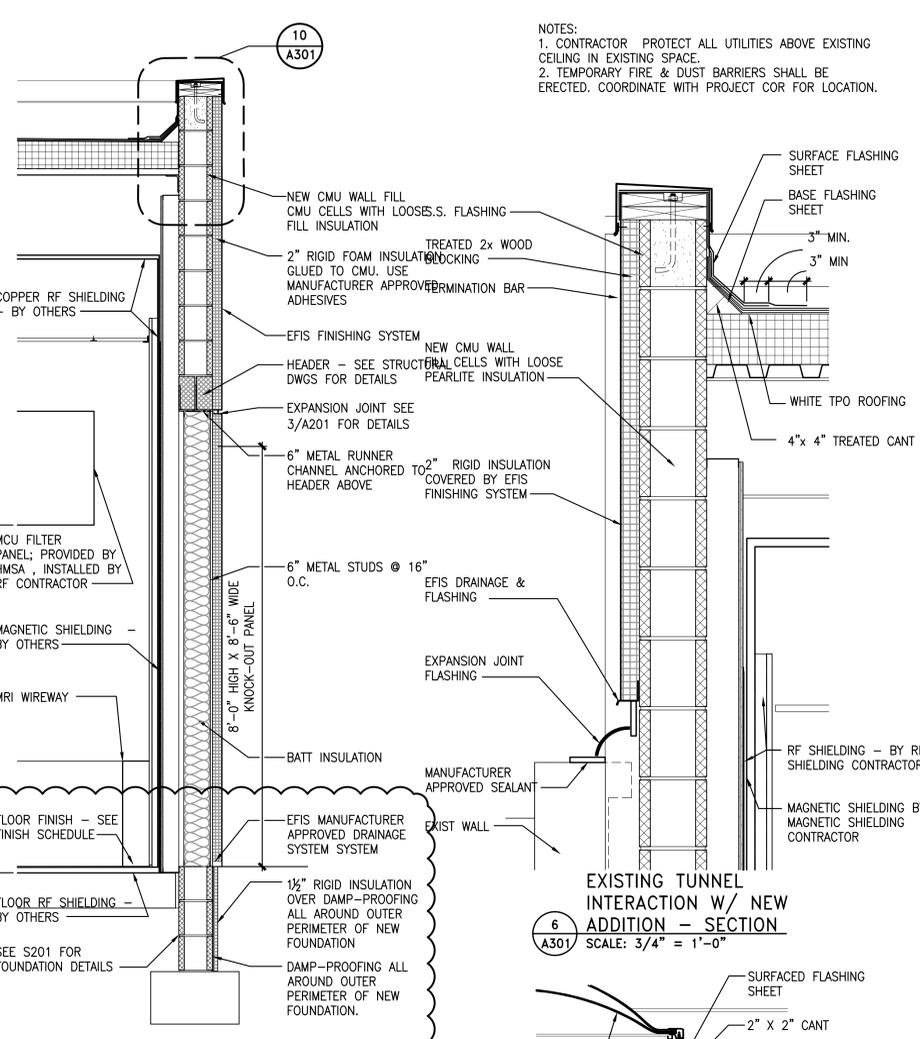


6 EXISTING TUNNEL INTERACTION W/ NEW ADDITION - SECTION
 SCALE: 3/4" = 1'-0"

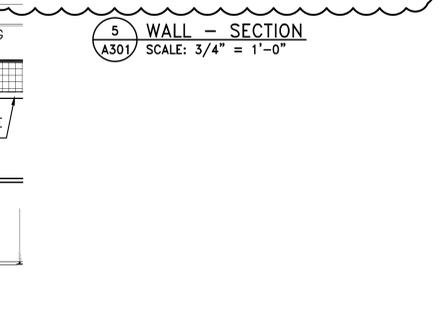

5 WALL - SECTION
 SCALE: 3/4" = 1'-0"

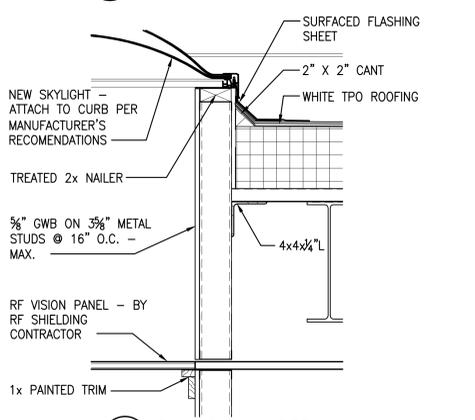

8 SKYLIGHT - DETAIL
 SCALE: 1 1/2" = 1'-0"

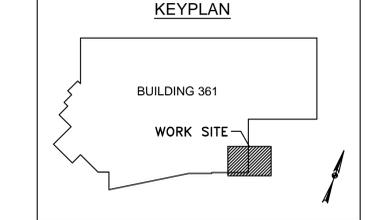

KEYPLAN

Date: 6/30/14	
Project No: 512-09-315	
Building No: 361	Checked: Drawn:
DRAWING NO: A301	
Dwg. 6 Of 29	

NOTES:
 1. CONTRACTOR PROTECT ALL UTILITIES ABOVE EXISTING CEILING IN EXISTING SPACE.
 2. TEMPORARY FIRE & DUST BARRIERS SHALL BE ERECTED. COORDINATE WITH PROJECT COR FOR LOCATION.

Revisions:	Date:
UPDATE SHIELDING NOTES AND MISC. REVISIONS	7-18-14
REVISIONS BASED ON BID RFIS	8-26-14

Consultants:
BURDETTE KOEHLER MURPHY & ASSOCIATES, INC.
 MECHANICAL / ELECTRICAL CONSULTING ENGINEERING
 1416 CLARKVIEW ROAD
 BALTIMORE, MARYLAND 21209
 410.323.0600 - FAX 410.377.2543

RICKERT ENGINEERING, Inc.
 STRUCTURAL ENGINEERING
 8813 WALTHAM WOODS ROAD, SUITE 301
 BALTIMORE, MARYLAND 21234
 410.663.9110 - FAX 410.663.9114

Seal:
BUILDING COST CONSULTANTS
 COST ESTIMATING
 12917 - 30TH AVENUE
 PLATTSMOUTH, NEBRASKA 68048
 402.298.8260 - FAX 402.298.8280

Seal:
POLT DESIGN GROUP
 ARCHITECTURE
 PLANNING
 ENGINEERING
 2215 CONOWINGO RD. 410.803.2141
 Bel Air, Maryland 21015-1436 fax 410.836.6611
 www.polt-design.com

Drawing Scale:
SECTIONS & DETAILS

Drawing Start Date:
 Approved: Associate Director for Operations:

Drawing Finish Date:
 Approved: Chief, Facilities Engineer:

Drawing Approved:
 Approved: Director, Medical Center:

Project Title:
MRI SITE PREPERATION

Building No: 361

Location: **VAMHCS MEDICAL CENTER PERRY POINT, MD**