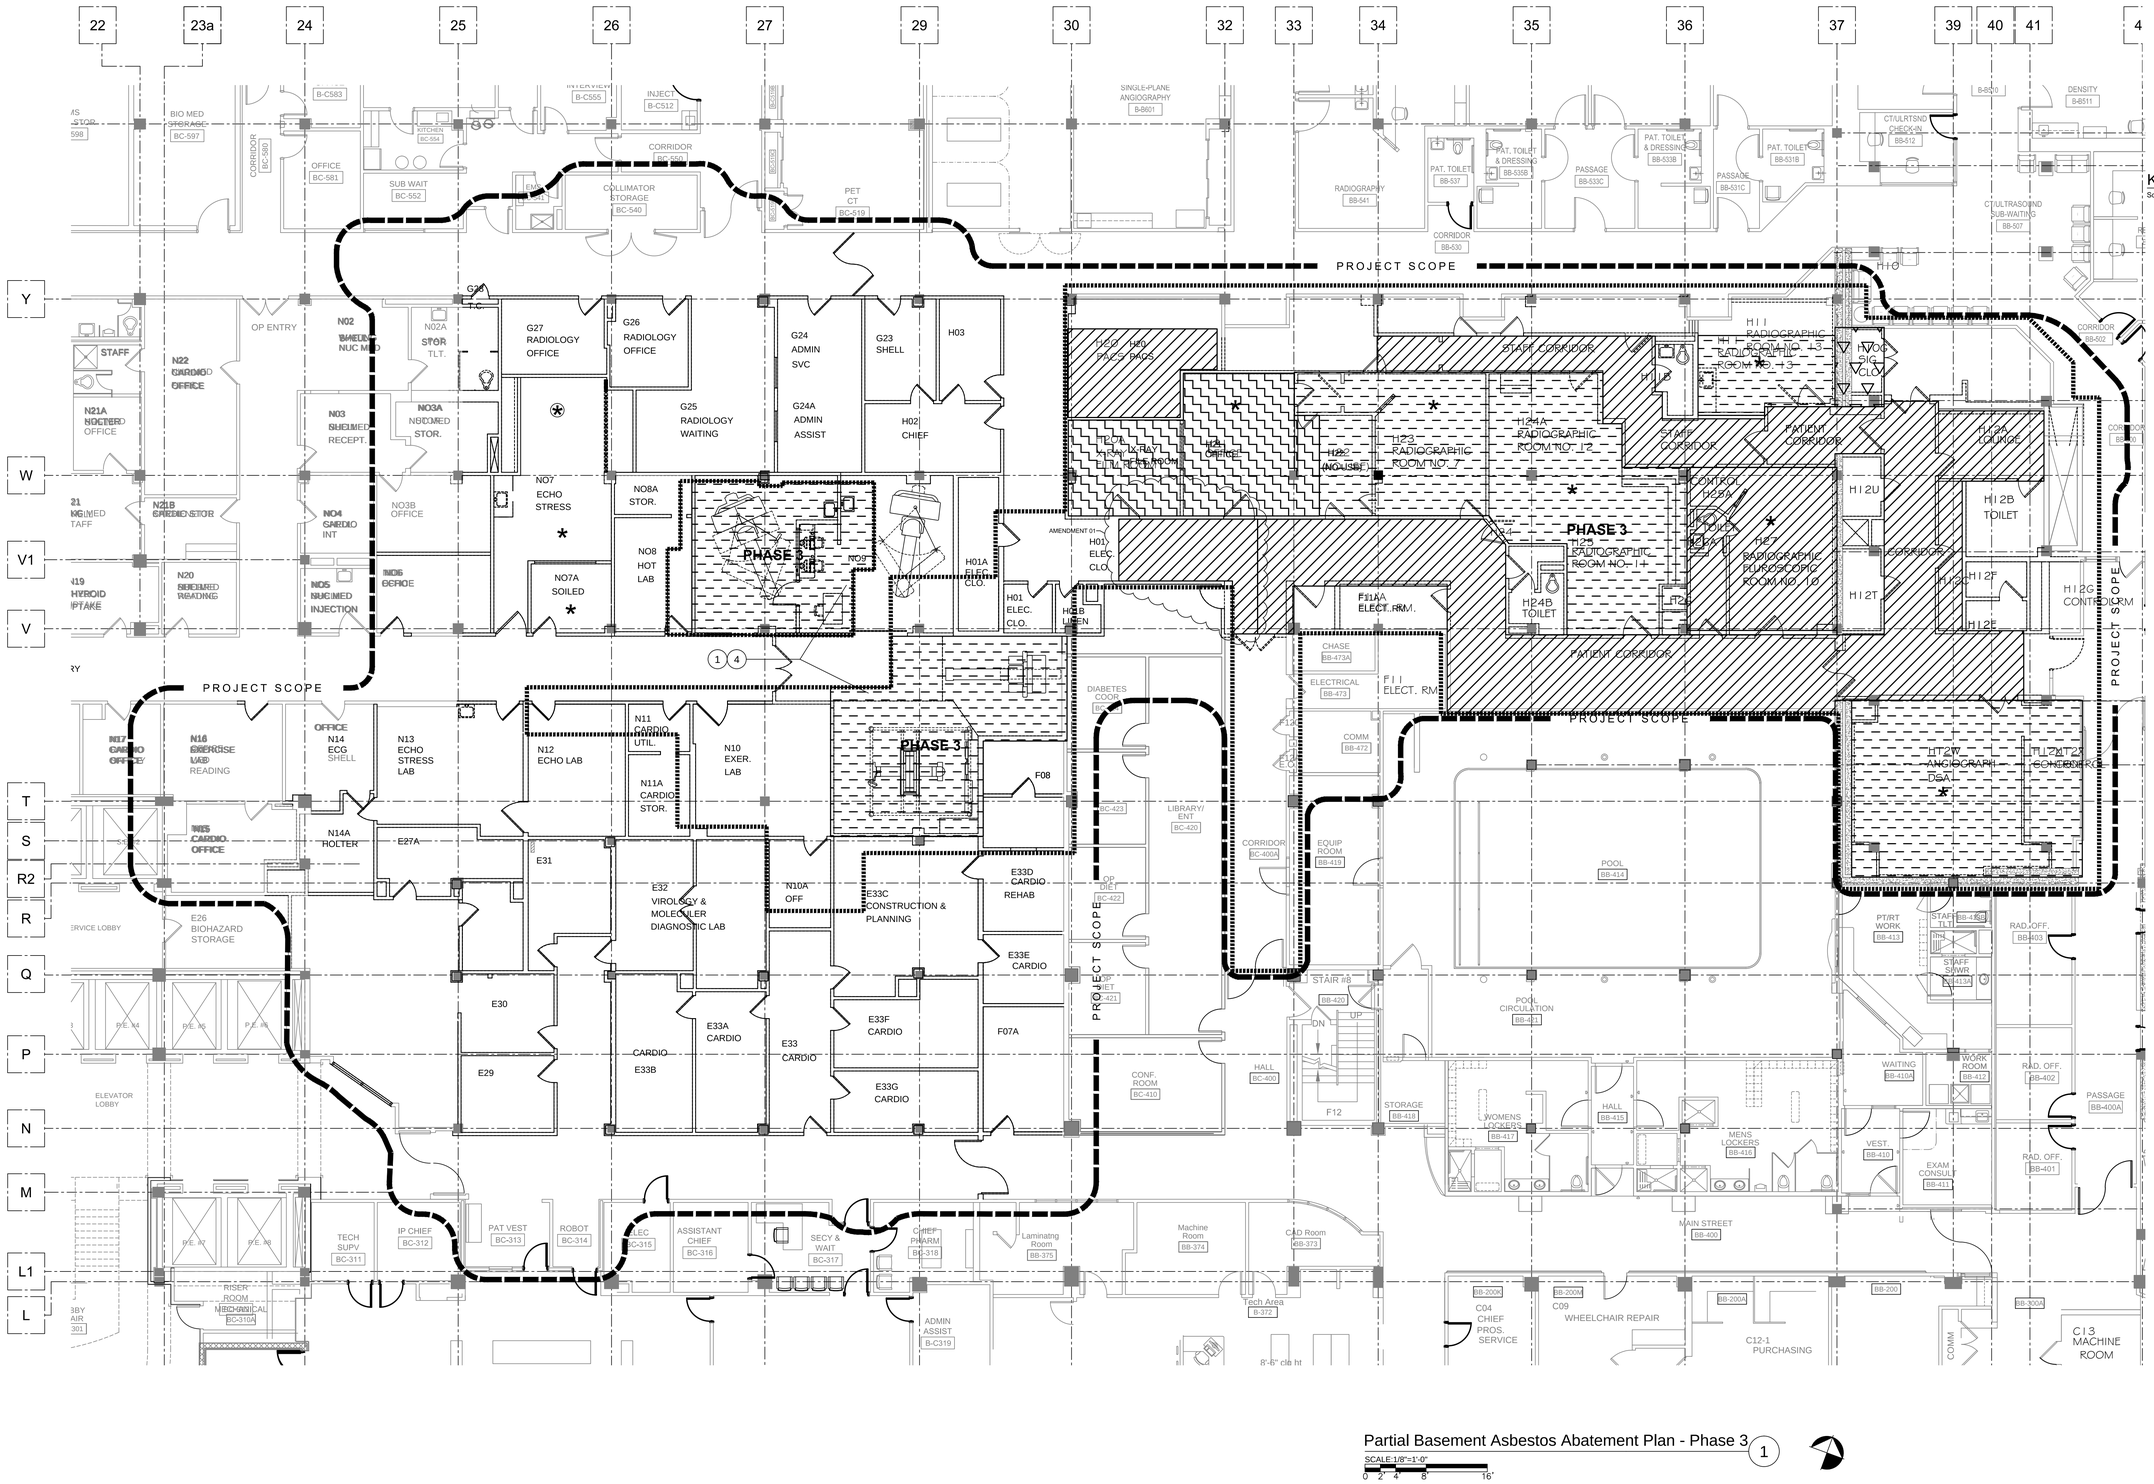

Partial Basement Asbestos Abatement Plan - Phase 3 (1)

SCALE 1/8"=1'-0"

0 2 4 8 16"

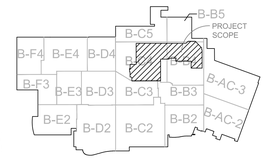

KEY PLAN - BASEMENT

Scale = None

NORTH

NOTES

1. Install critical barriers and warning signs at entrances to each work area within the construction barrier entrances (see detail sheet 1-AA2.1)
2. Install 6 mil polyethylene drop cloth below pipe insulation joints to at least 6 ft horizontal distance from each pipe insulation joint to be removed.
3. Install negative air machines for local exhaust ventilation sufficient to maintain a pressure differential of at least 0.02 inches of water across every barrier separating the work area from the balance of the building or the outside and route exhaust to outside of building through secured outside door (see detail sheet 1-AA2.1)
4. Install three stage decontamination unit within the construction barrier entrances (see detail sheet 1-AA2.1)
5. Contractor shall reference Drawing 1-01.3 for sequencing of work in Phase 3
6. Phase 3

   Remove and dispose of approximately 100 each pipe insulation joints and 0 sq ft of asbestos-containing 9"x9" floor tile and mastic, 2,550 sq ft of asbestos-containing mastic below 12"x12" floor tiles, 3,000 sq ft of mastic below linoleum, 500 sq ft of mastic below carpeting and 70 sq ft of mastic below laminate
7. Remove and dispose of approximately 4,100 sq ft of lead lining presumed inside walls and windows as indicated.

LEGEND:

- ACM MASTIC BELOW LINOLEUM
- ASBESTOS-CONTAINING MASTIC BELOW 12"x12" FLOOR TILE
- ACM FLOOR TILE AND/OR MASTIC BELOW CARPET
- ASBESTOS-CONTAINING MASTIC BELOW LAMINATE
- LEAD LINED WALLS
- LEAD LINED CEILINGS
- LIMIT OF ABATEMENT DURING THIS PHASE

FULLY SPRINKLERED

Amendment 01	08/29/14
Bid Issue	01/17/14
Revisions:	**Date**

CONSULTANTS:

STEPHEN J. SEBESTA & ASSOCIATES, INC.

CONSULTING ENVIRONMENTAL HEALTH ENGINEERS

17830 ENGLEWOOD DRIVE, SUITE 16, CLEVELAND, OHIO 44130 (216) 781-0060

STATE OF OHIO · STEPHEN J. SEBESTA · 29515 · REGISTERED PROFESSIONAL ENGINEER

ARCHITECT:

Perspectus architecture

13212 Shaker Square Suite 204 Cleveland, Ohio 44120

P. 216.752.1800 F.216.752.3833

DESIGN AND CONSTRUCTION DOCUMENTS AS INSTRUMENTS OF SERVICE ARE GIVEN IN CONFIDENCE AND REMAIN THE PROPERTY OF PERSPECTUS ARCHITECTURE. THE USE OF THIS DESIGN AND THESE CONSTRUCTION DOCUMENTS FOR PURPOSES OTHER THAN THE SPECIFIC PROJECT NAMED HEREIN IS STRICTLY PROHIBITED WITHOUT THE EXPRESSED WRITTEN CONSENT OF PERSPECTUS ARCHITECTURE.

Drawing Title	**PARTIAL BASEMENT ASBESTOS ABATEMENT PLAN - PHASE 3**
Approved: Project Director	
Project Title	**EXPAND AND RENOVATE NUCLEAR MEDICINE AND RADIOLOGY**
Location	**VAMC - WADE PARK**
Date	1-17-2014
Checked	EMO
Drawn	CAJ
Project Number	541-14-101
Building Number	1
Drawing Number	**1-AA1.3**
Dwg.	3 of 5

Office of Facilities Management

Department of Veterans Affairs

VA FORM 08-6231, OCT 1978