

three inches = one foot

one and one half inches = one foot

one inch = one foot
6"

three quarters inch = one foot

one half inch = one foot

three eighths inch = one foot

one quarter inch = one foot

one eighth inch = one foot

0 4 8 16

GENERAL NOTES

A REFER TO SHEET H0.1 FOR LEGEND, ABBREVIATIONS AND ADDITIONAL GENERAL NOTES.

B RUNOUT PIPING TO TERMINAL UNITS SHALL BE 0.75" SIZE UNLESS OTHERWISE NOTED.

NOTES

1. EXISTING STEAM CONVEYCTOR TO REMAIN. REMOVE SELF-CONTAINED STEAM CONTROL VALVE AND REPLACE WITH DDC. REFER TO DETAIL ON SHEET H0.6 AND CONTROL DIAGRAM ON SHEET H0.10.
2. FISH THERMOSTAT WIRES THROUGH EXISTING WALL.
3. 2.5" HEATING HOT WATER SUPPLY AND RETURN PIPES DOWN. REFER TO SHEET H3.2 FOR CONTINUATION. 2" HEATING HOT WATER SUPPLY AND RETURN PIPES UP. REFER TO SHEET H3.2 FOR CONTINUATION.
4. 1" CHILLED WATER SUPPLY AND RETURN PIPES UP AND DOWN. REFER TO SHEETS H3.1-1 AND H4.1-FOR CONTINUATION.
5. PROVIDE REFRIGERANT PIPING AND ACCESSORIES PER MANUFACTURER'S RECOMMENDATIONS. APPROXIMATE ROUTE SHOWN.
6. EXISTING 2" STEAM SUPPLY AND 1.25" STEAM CONDENSATE RETURN PIPES UP TO FLOOR. ABOVE AND DOWN TO FLOOR. REFER TO SHEETS H3.2 AND H4.1-FOR CONTINUATION.
7. EXTEND FULL SIZE VENT PIPING FROM BASEMENT UP THRU ROOF. REFER TO SHEETS

2 THIRD FLOOR PLAN - PIPING
1/8" = 1'-0" F.F.E.; 123'-10"

1 THIRD FLOOR PLAN - PIPING
1/8" = 1'-0" F.F.E.: 123'-10" 

3023 01

1. ADDENDUM

Revisions


8/27/14

Date _____

App Architecture
creative focused design

615 Woodside Drive, Englewood, Ohio 45322
T 937.836.8898 F 937.832.3696

www.app-arch.com

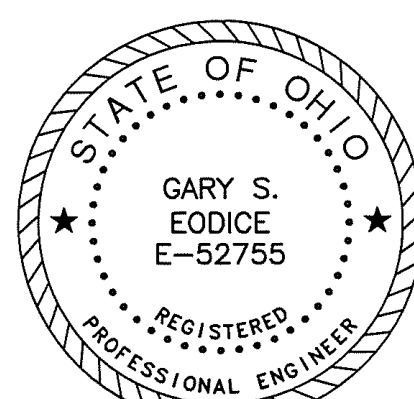

Revised By:

Drawing Title

THIRD FLOOR PLAN - PIPING

Approved: Project Manager
CHRIS MOORHEAD

Approved: Service Chief
PHILIP KIRK

Project Title

MODERNIZE MENTAL HEALTH
SERVICES

Building Number	302
-----------------	-----

Checked
DLE

Drawn
WJ


Location	4100 WEST THIRD STREET DAYTON, OH 45428
----------	--

Date	05/29/2014
------	------------

Project No.
552-14-103

Drawing No.

H3.1-3

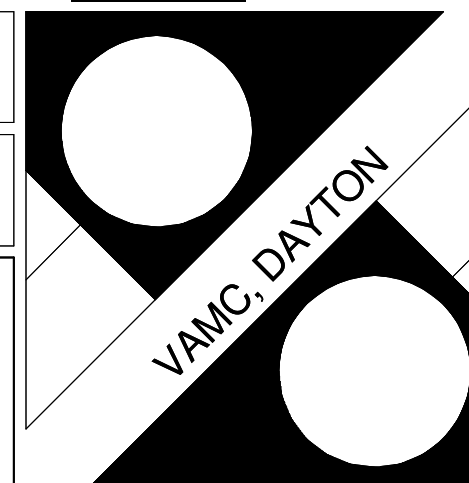VA
Department of
Veterans Affairs