








three inches = one foot  
one and one half inches = one foot  
one inch = one foot  
three quarters inch = one foot  
one half inch = one foot  
three eighths inch = one foot  
one eighth inch = one foot  
one quarter inch = one foot  
one eighth inch = one foot

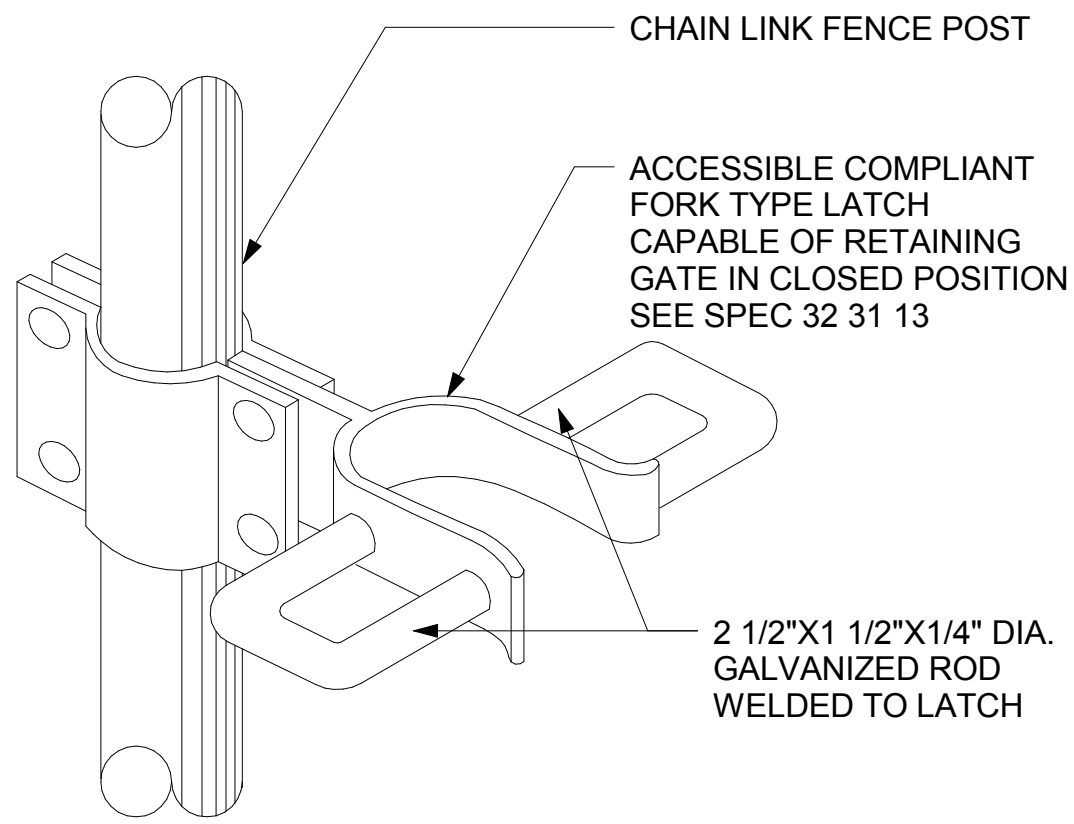


13 LOCKING FORK  
1/2" = 1'-0"

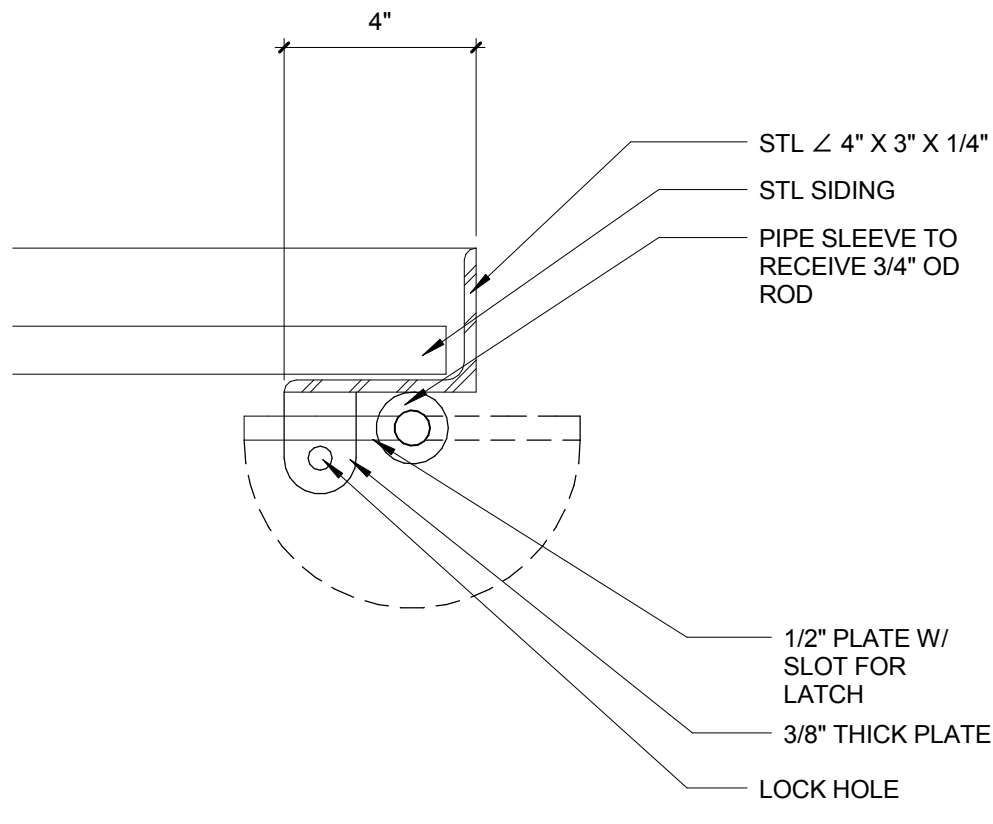


13A CANE BOLT SECTION  
3" = 1'-0"

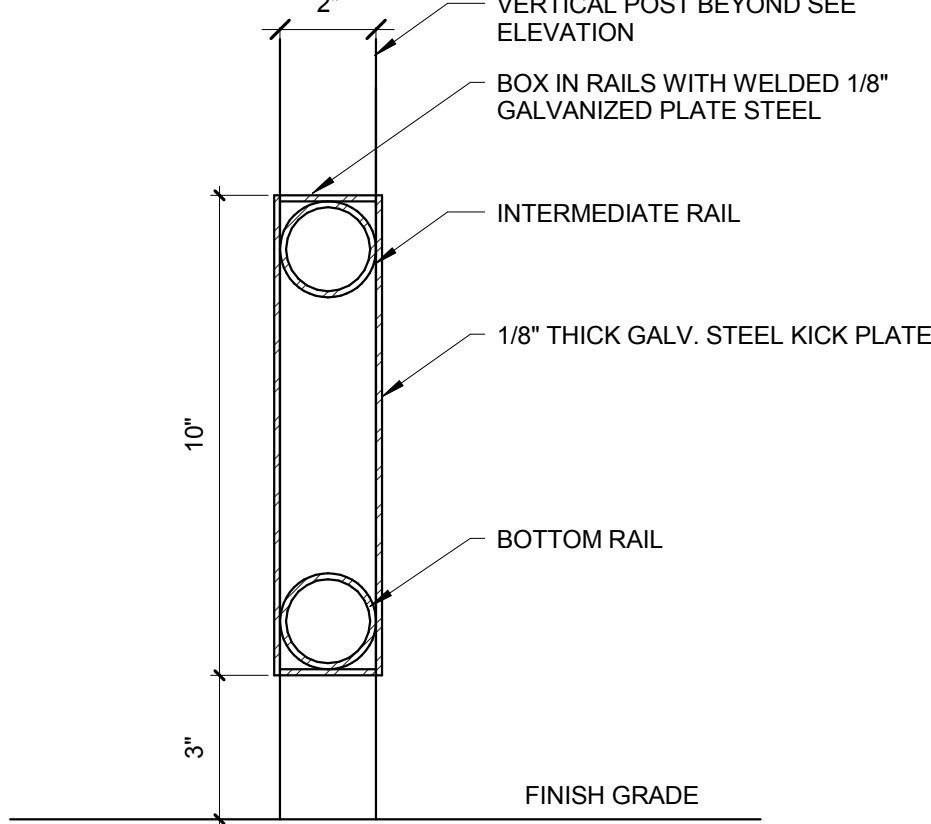


12 KICK PLATE AT GATE  
3" = 1'-0"

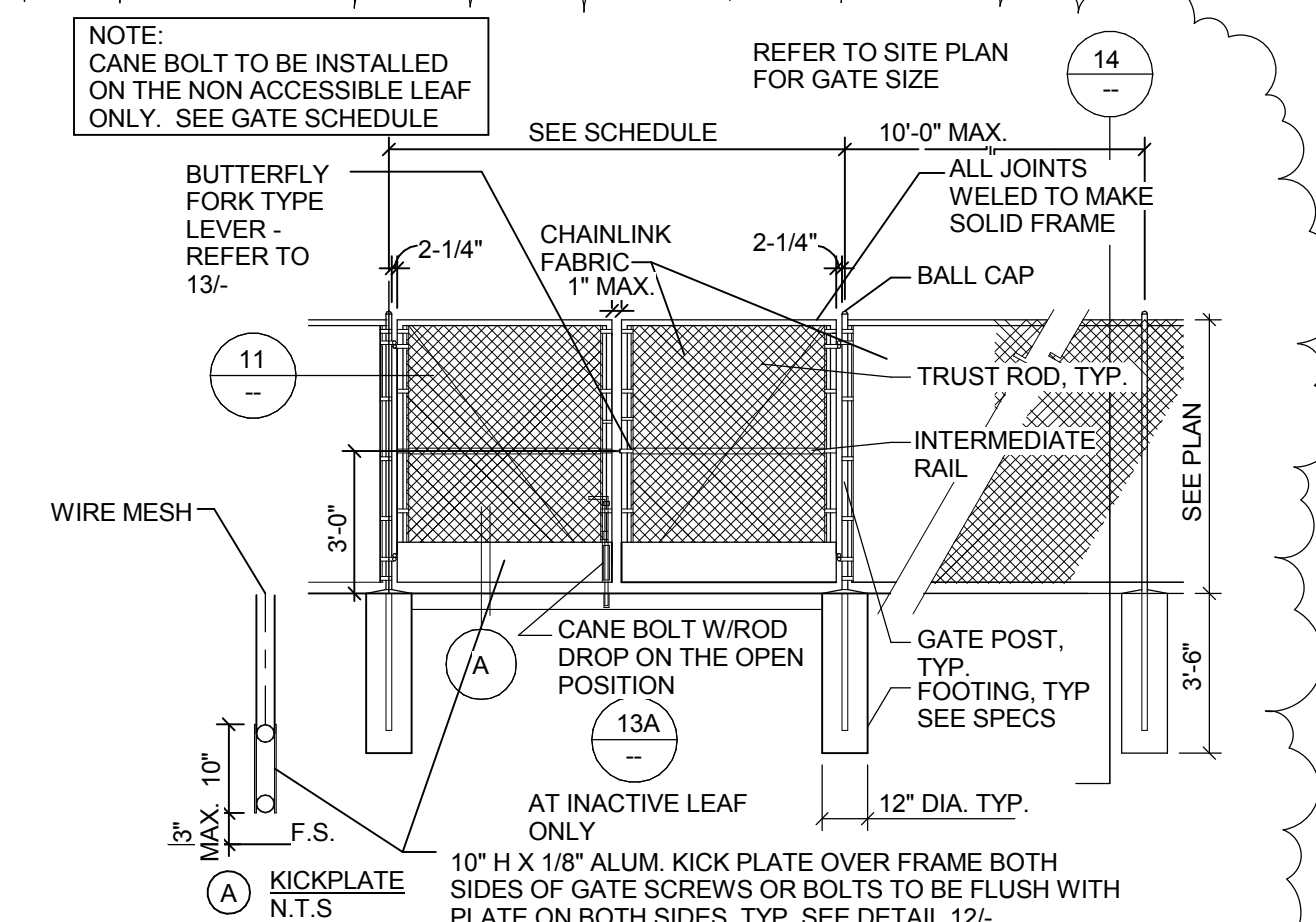


8 DOUBLE CHAIN LINK GATE  
1/4" = 1'-0"

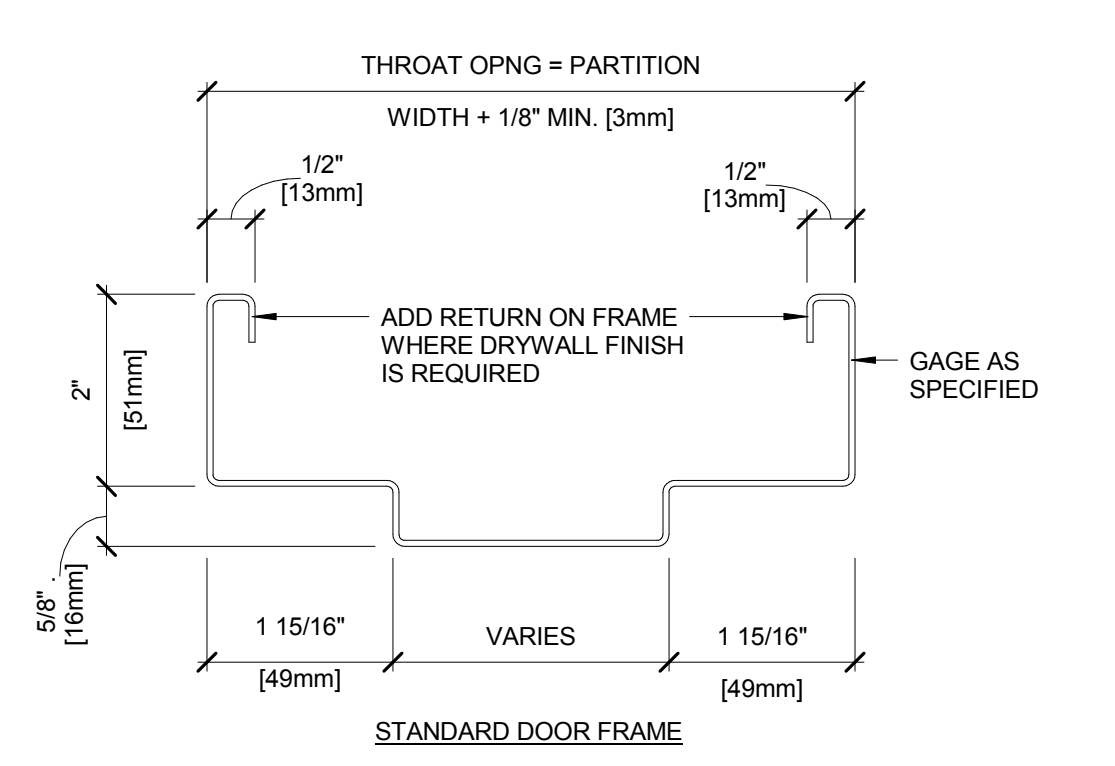


4 TYPICAL HOLLOW METAL FRAME  
6" = 1'-0"

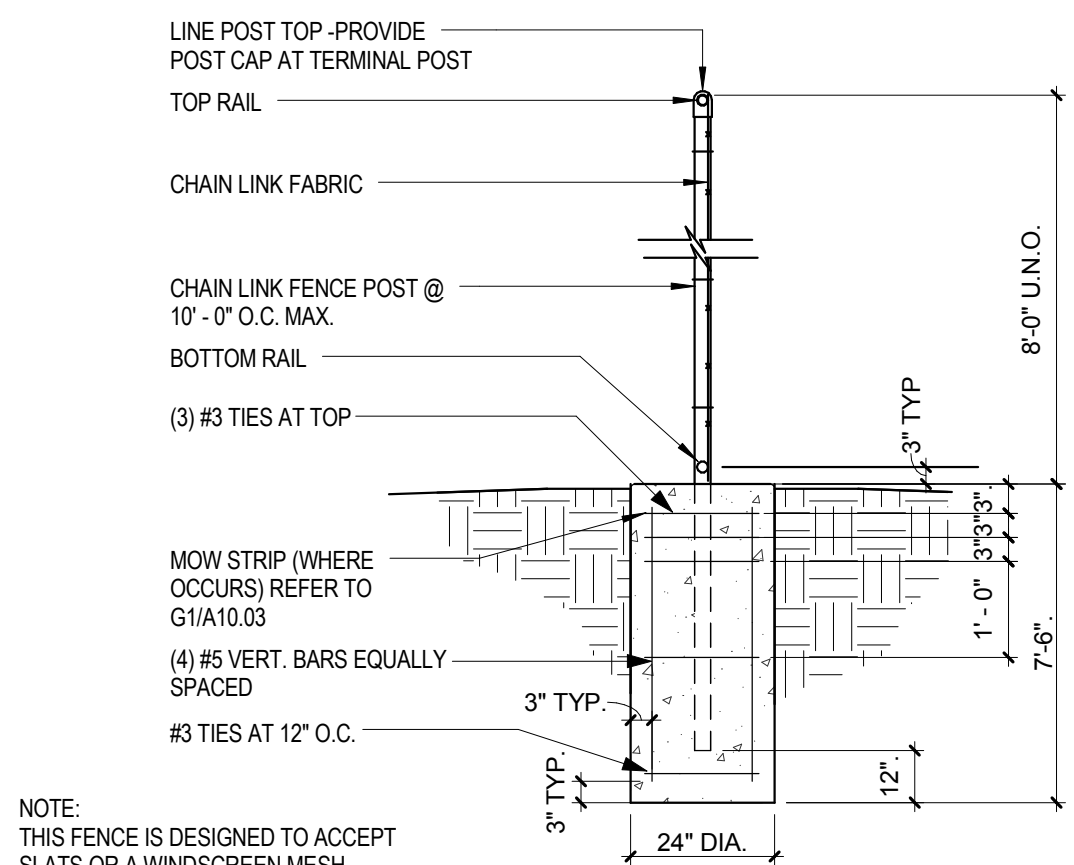


14 C.L. FENCE DETAIL - MESH OR SLATS  
1/2" = 1'-0"

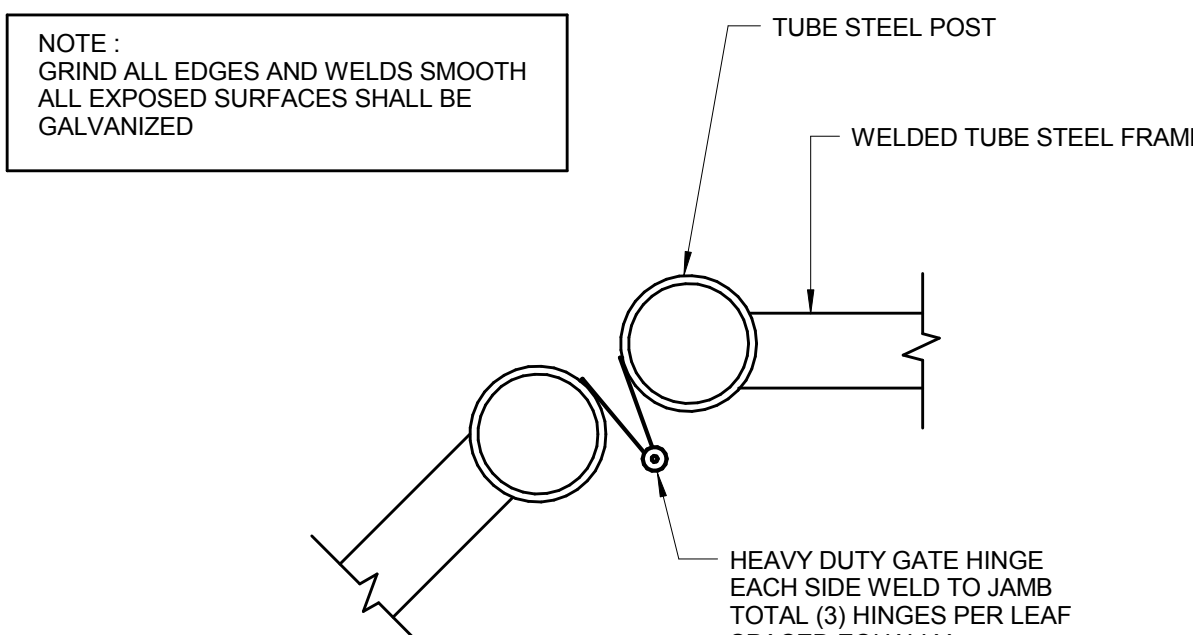


11 CHAIN LINK GATE DETAIL  
1/4" = 1'-0"

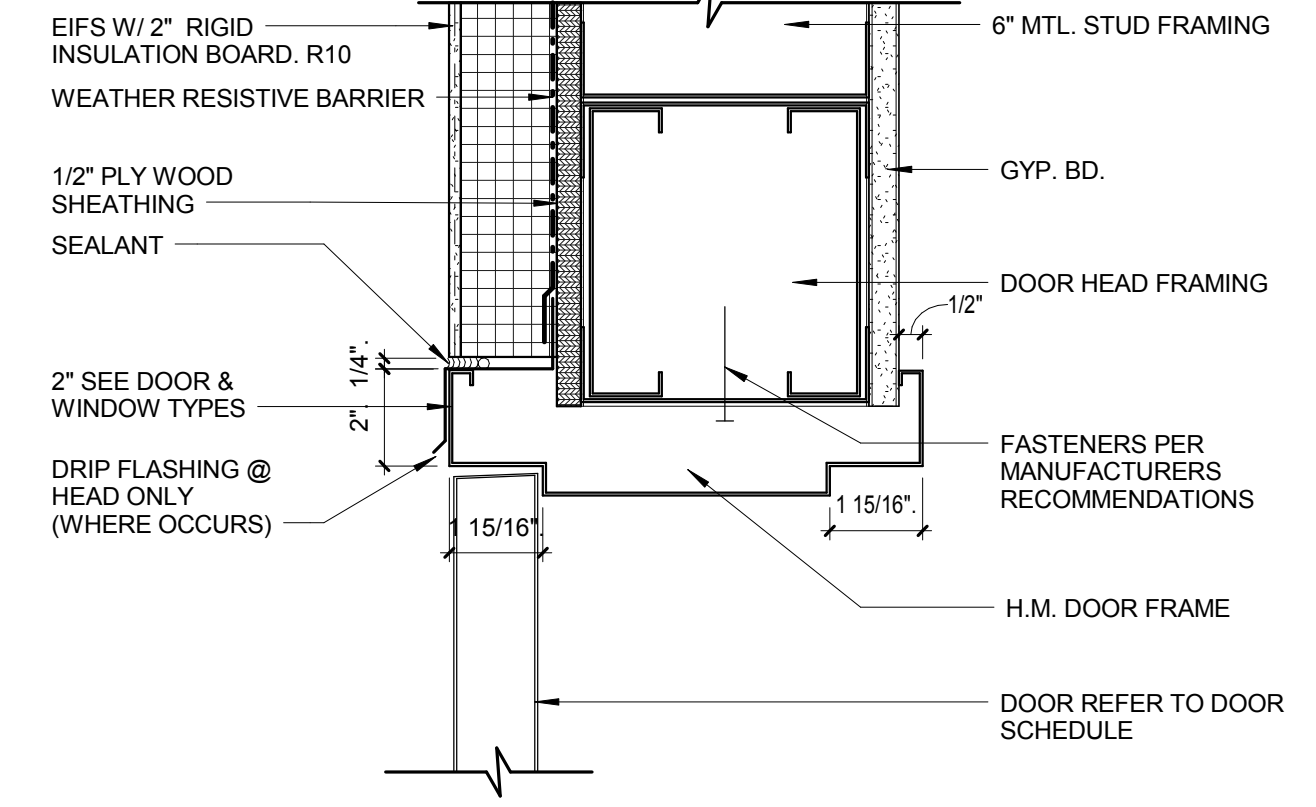


7 EXTERIOR DOOR HEAD - JAMB SIMILAR  
3" = 1'-0"

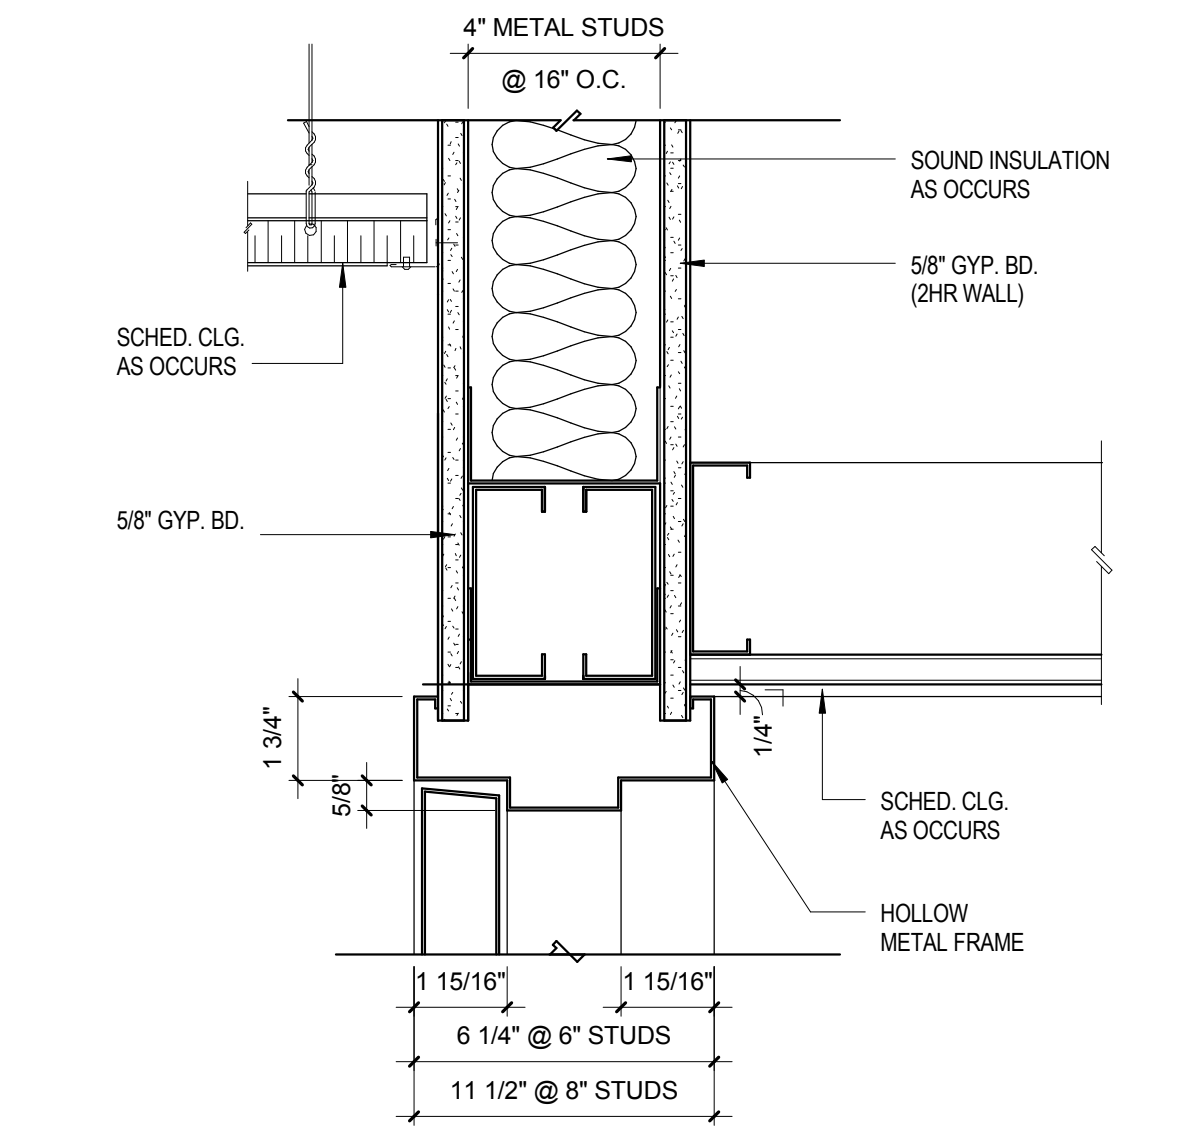


3 STEEL FRAME INTERIOR DOOR HEAD  
3" = 1'-0"

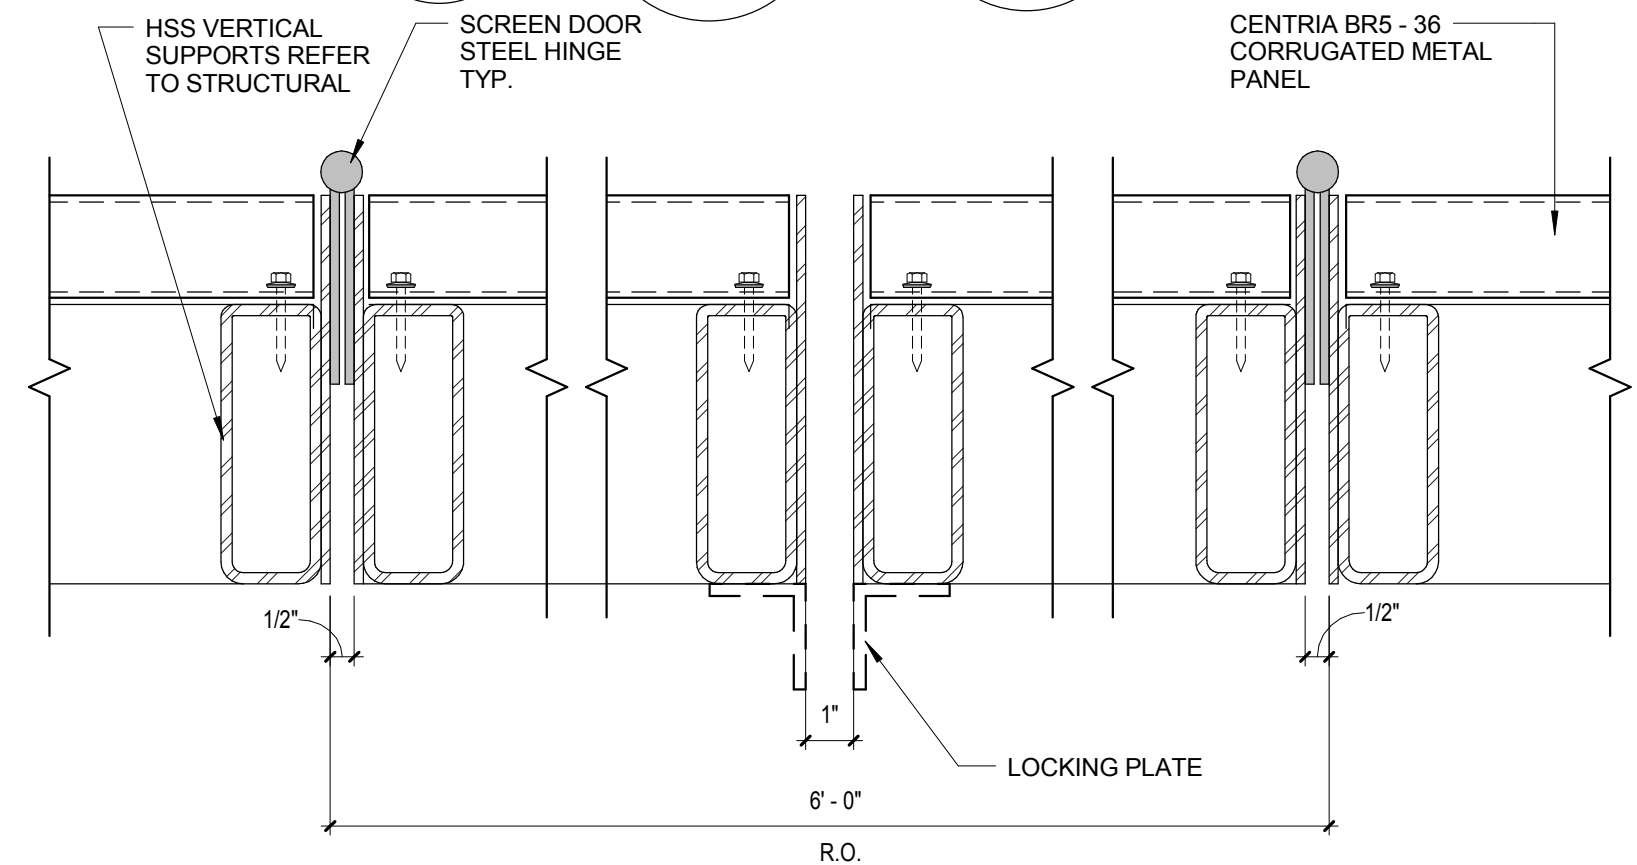


15 HOLLOW METAL GATE - JAMB  
3" = 1'-0"

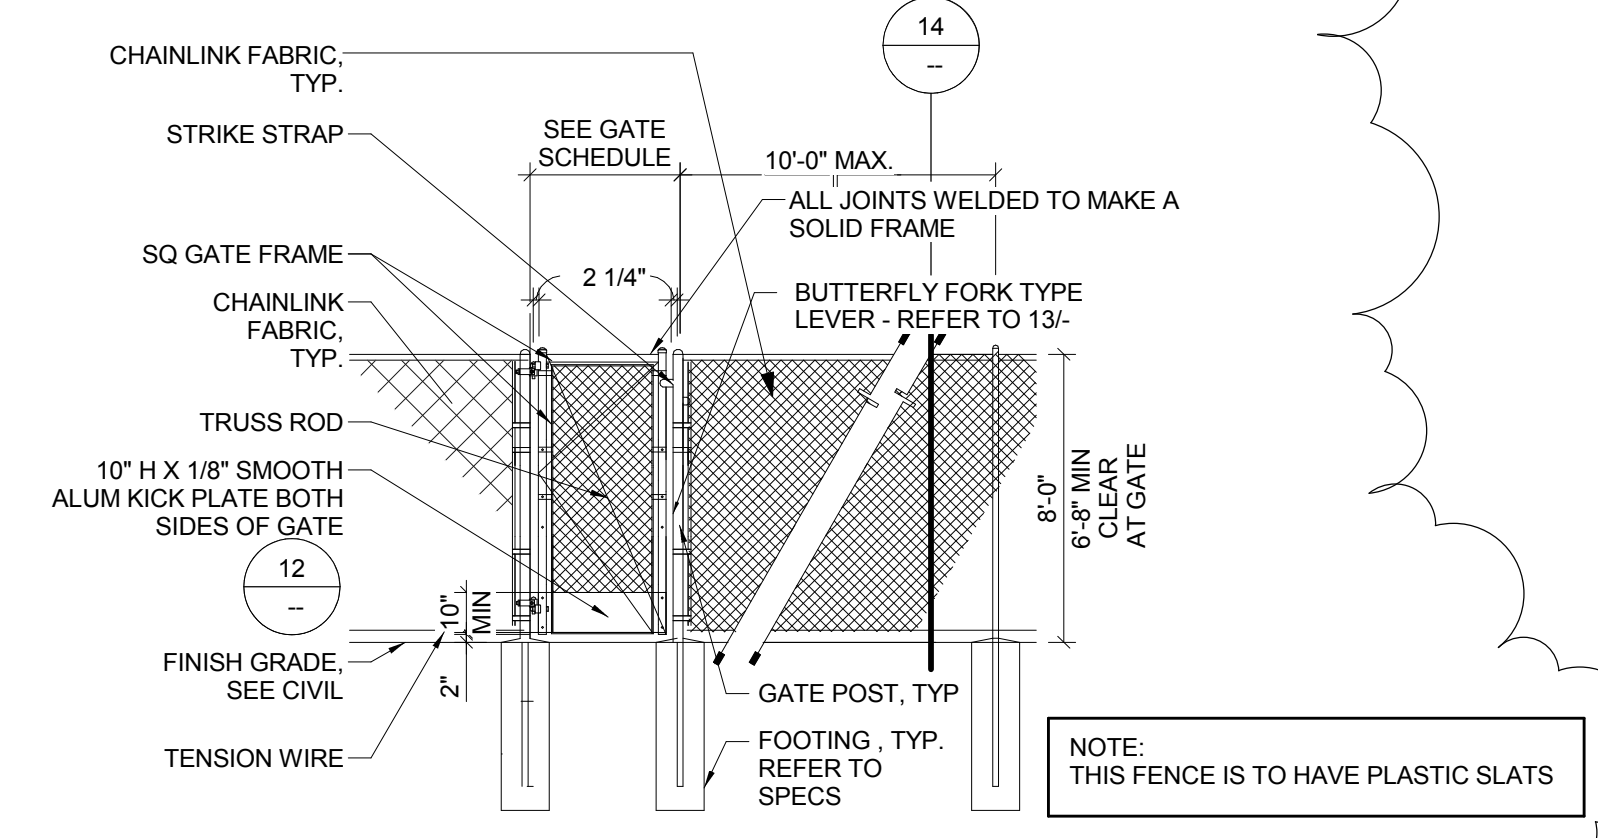


9 SINGLE CHAIN LINK GATE  
1/4" = 1'-0"

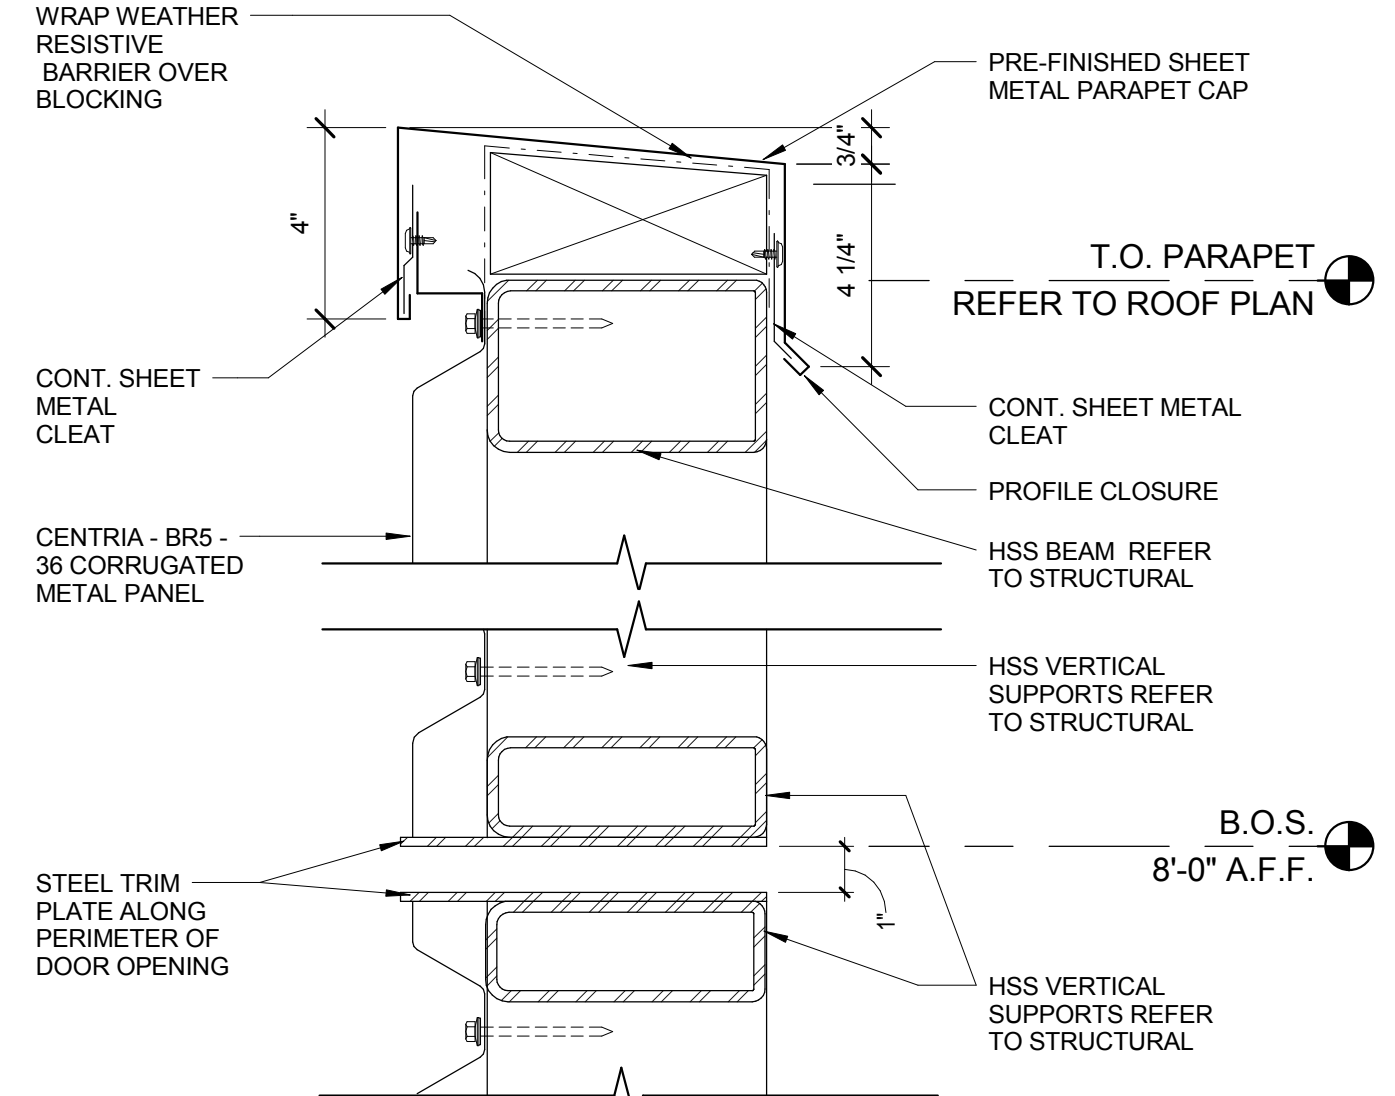


16 HOLLOW METAL GATE - HEAD  
3" = 1'-0"

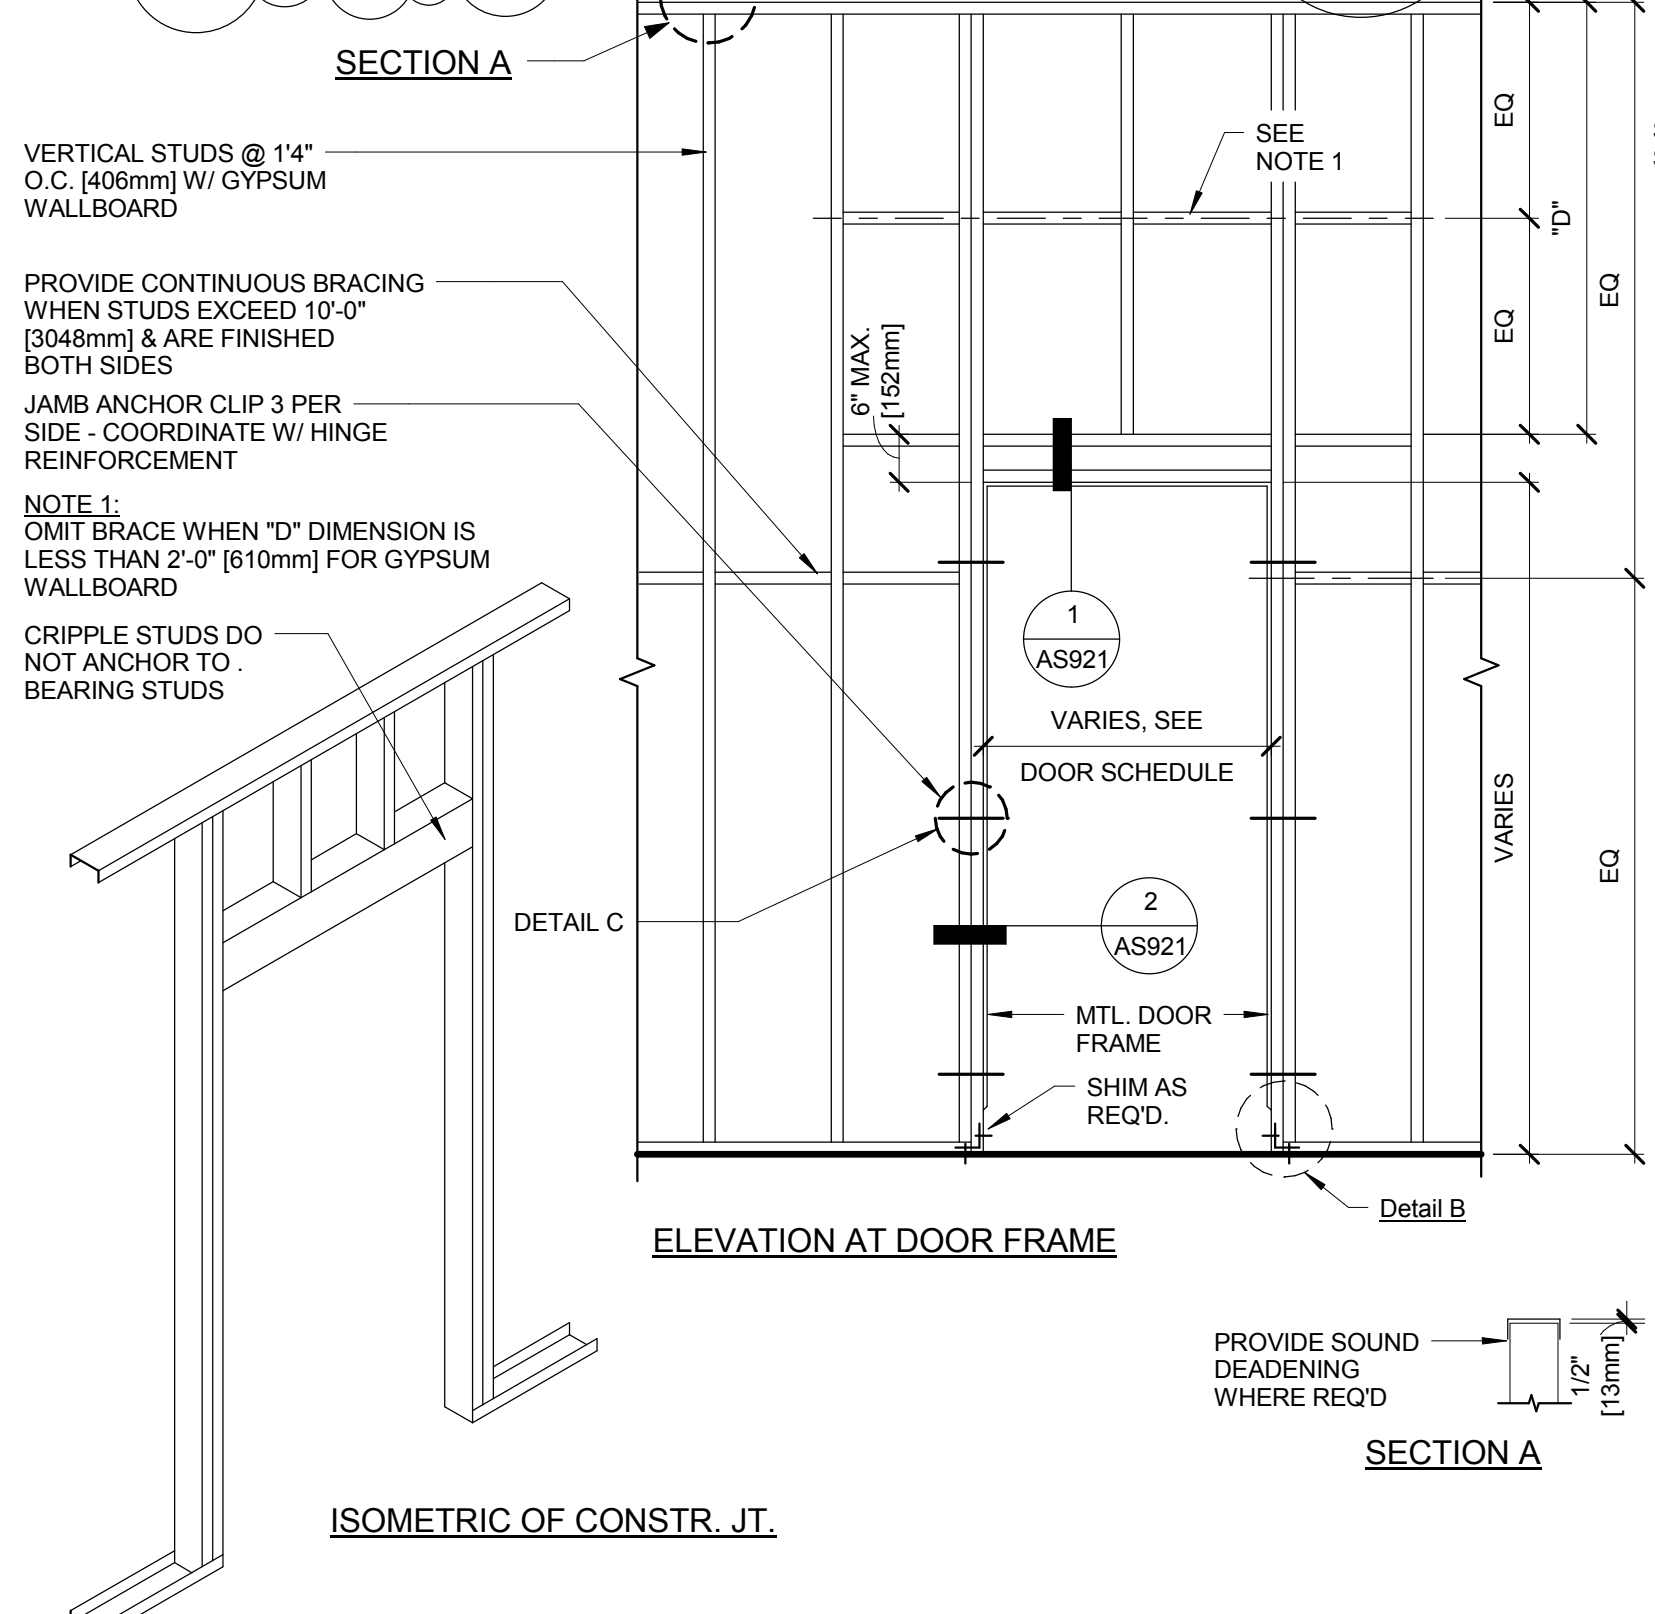


10 TYPICAL PARTITION FRAMING FOR DOORS  
1/2" = 1'-0"

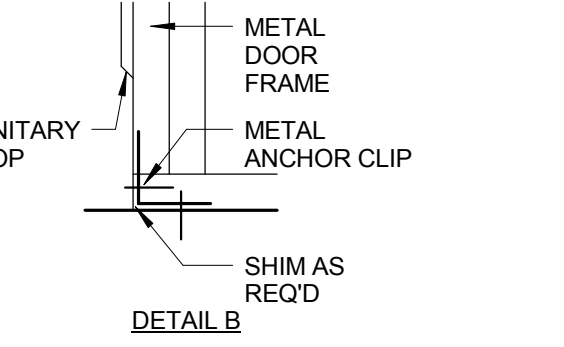

6 DOOR - TYPICAL DOOR FRAME JOINT DETAIL  
1 1/2" = 1'-0"

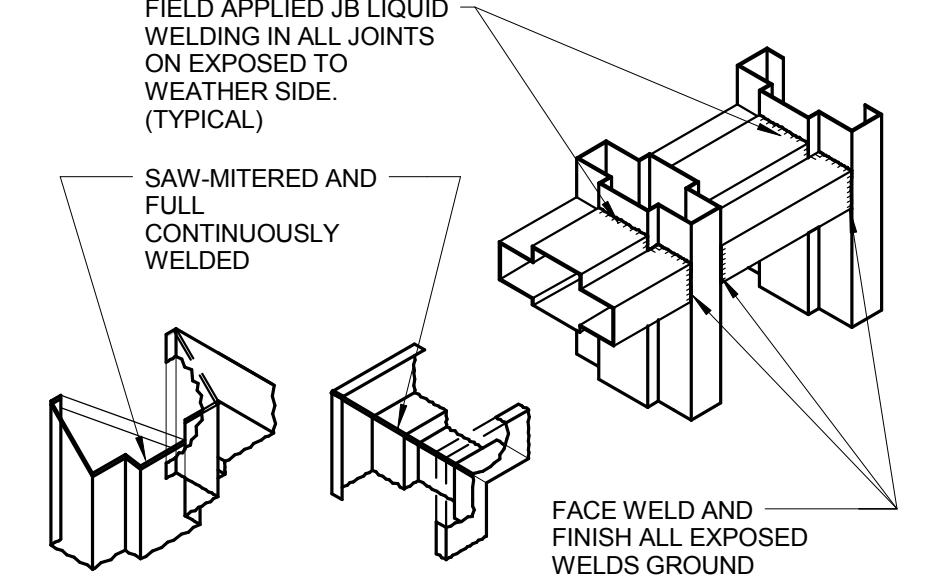

5 TYP. DOOR / WINDOW FRAME ANCHOR  
6" = 1'-0"

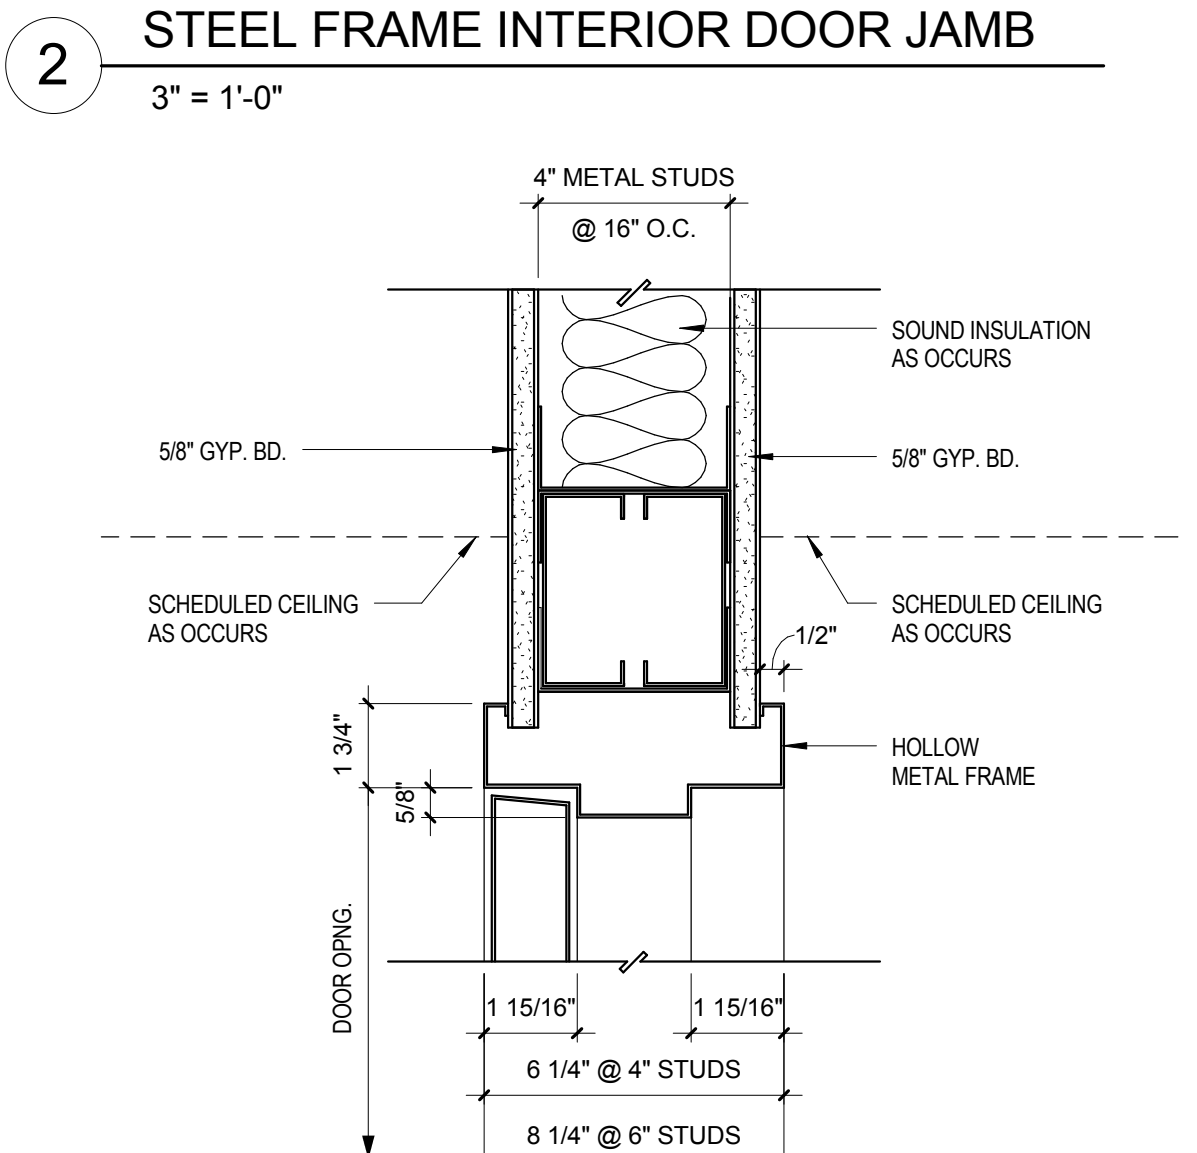

2 STEEL FRAME INTERIOR DOOR JAMB  
3" = 1'-0"

1 STEEL FRAME INTERIOR DOOR HEAD  
3" = 1'-0"

Revision No.	Description	Date
2	ADDENDUM #2	8/28/2014

CONSULTANTS:



ARCHITECT/ENGINEERS:

**HMC Architects**  
1827 E. Fir Avenue / Studio 103 / Fresno, CA 93720  
T 559 322 2444 / www.hmcarchitects.com  
HMC PROJECT #1393002-000

Drawing Title  
**GATE AND HOLLOW METAL DOOR DETAILS**

Approved: Project Director

Project Title  
**Mental Health Psychosocial Rehab Recovery and Health Care for Homeless Veteran Center**

Location  
**2615 E. CLINTON AVE, FRESNO, CA 93703**

Date  
**08/11/2014**

Checked  
**ME**

Drawn  
**JM SK**

Project Number  
**570-217**  
Building Number  
**37**  
Drawing Number  
**AS921**  
Dwg. 88 of 197

Office of Construction and Facilities Management  
Department of Veterans Affairs