



0 1 2 3 4 5 6 7 8 9 10
A B C D E F
three inches = one foot
one and one half inches = one foot
one inch = one foot
three quarters inch = one foot
one half inch = one foot
three eighths inch = one foot
one quarter inch = one foot
one eighth inch = one foot

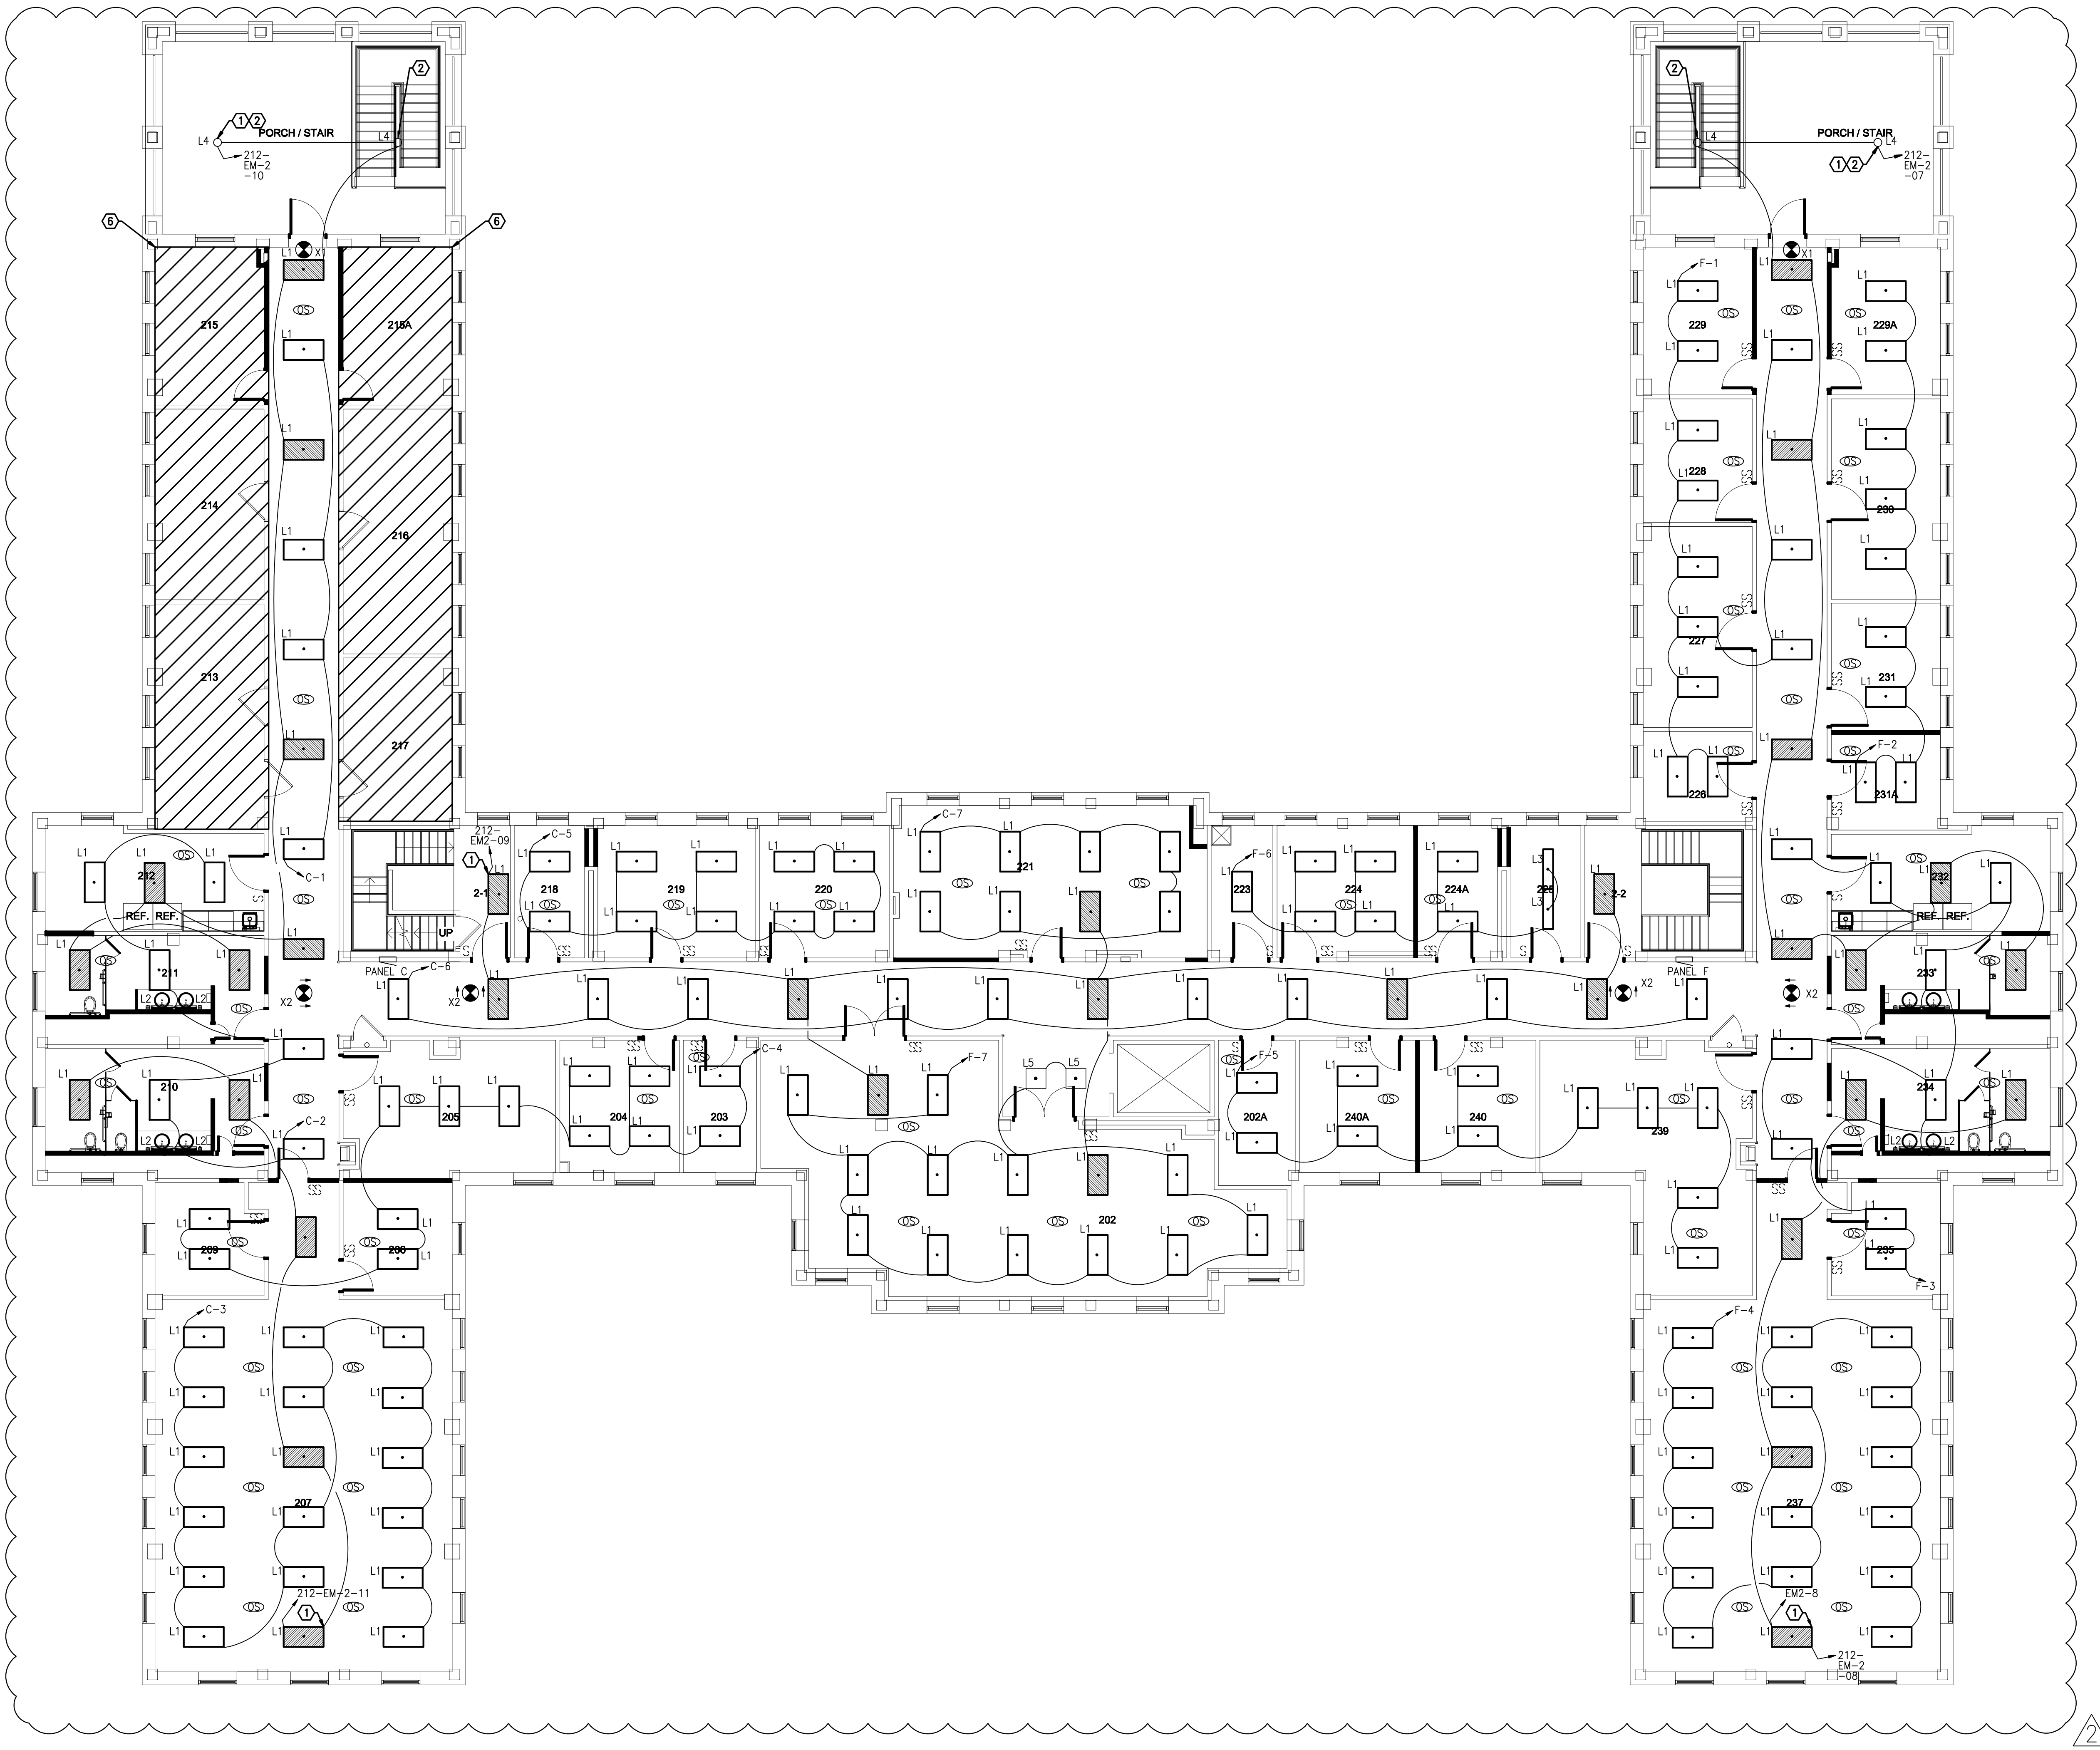


SECOND FLOOR LIGHTING PLAN - NEW WORK
SCALE: 1/8" = 1 FOOT

- ELECTRICAL GENERAL NOTES**
- UPDATE ALL PANEL INDEX CARDS UPON COMPLETION OF THE PROJECT - CARDS SHALL BE TYPED AND INSTALLED IN PANEL SLOTS, WITH ELECTRONIC COPIES PROVIDED TO COTR.
 - WIRE ALL EXIT SIGNS AHEAD OF LOCAL SWITCHING.
 - THE DIVISION 26 ELECTRICAL CONTRACTOR IS RESPONSIBLE FOR ALL SWITCH LEGS (WHICH MAY NOT BE SHOWN ON THE DRAWINGS TO ENHANCE CLARITY) AS REQUIRED FOR A COMPLETE, FUNCTIONAL LIGHTING SYSTEM.
 - PROVIDE STEP DIMMING BALLASTS WHERE TWO SWITCHES ARE SHOWN.
 - COORDINATE ALL LIGHTING FIXTURE LOCATIONS WITH THE ARCHITECTURAL REFLECTED CEILING PLAN AND ANY CEILING EQUIPMENT LOCATED BY OTHER TRADES.
 - (1) BRANCH CIRCUIT HOME RUN SHALL HAVE NO MORE THAN THREE (3) CIRCUITS.
 - EACH BRANCH CIRCUIT HOME RUN SHALL HAVE A SEPARATE NEUTRAL AND GREEN INSULATED EQUIPMENT GROUNDING CONDUCTOR.
 - WHERE SWITCHES ARE SHOWN IN SPACES CONTROLLED BY OCCUPANCY SENSORS, WIRE THE SENSOR RELAY PACK AHEAD OF THE LOCAL SWITCHING.
 - WHERE MULTIPLE OCCUPANCY SENSORS ARE SHOWN IN A COMMON ROOM OR CORRIDOR, WIRE SENSORS IN PARALLEL FOR COMMON ZONE CONTROL.

- ELECTRICAL DRAWING NOTES**
- CONNECT TO EMERGENCY PANEL EM-2 INSTALLED ON FIRST FLOOR IN ROOM 139.
 - INSTALL NEW PORCH LIGHT FIXTURES IN LOCATIONS PREVIOUSLY OCCUPIED BY EXISTING FIXTURES, UTILIZE EXISTING ROUGH-IN.
 - NEW FIRST FLOOR PORCH LIGHT FIXTURE - SECURED TO CEILING OF FIRST FLOOR PORCH.
 - CONNECT NEW FIXTURES TO EXISTING CIRCUITRY WHICH SERVED PREVIOUSLY DEMOLISHED EXISTING PORCH FIXTURES.
 - EXISTING FIXTURE IN THE NORTH PORCH TO BE REINSTALLED, REUSE FIXTURE REMOVED DURING DEMOLITION OF THIS AREA.
 - NO NEW LIGHTING WORK IN THESE AREAS.
 - FIXTURE IS EXISTING TO REMAIN. PROTECT FIXTURE DURING CONSTRUCTION.
 - APPROXIMATE OUTLINE OF STAIRWELL STRUCTURE.

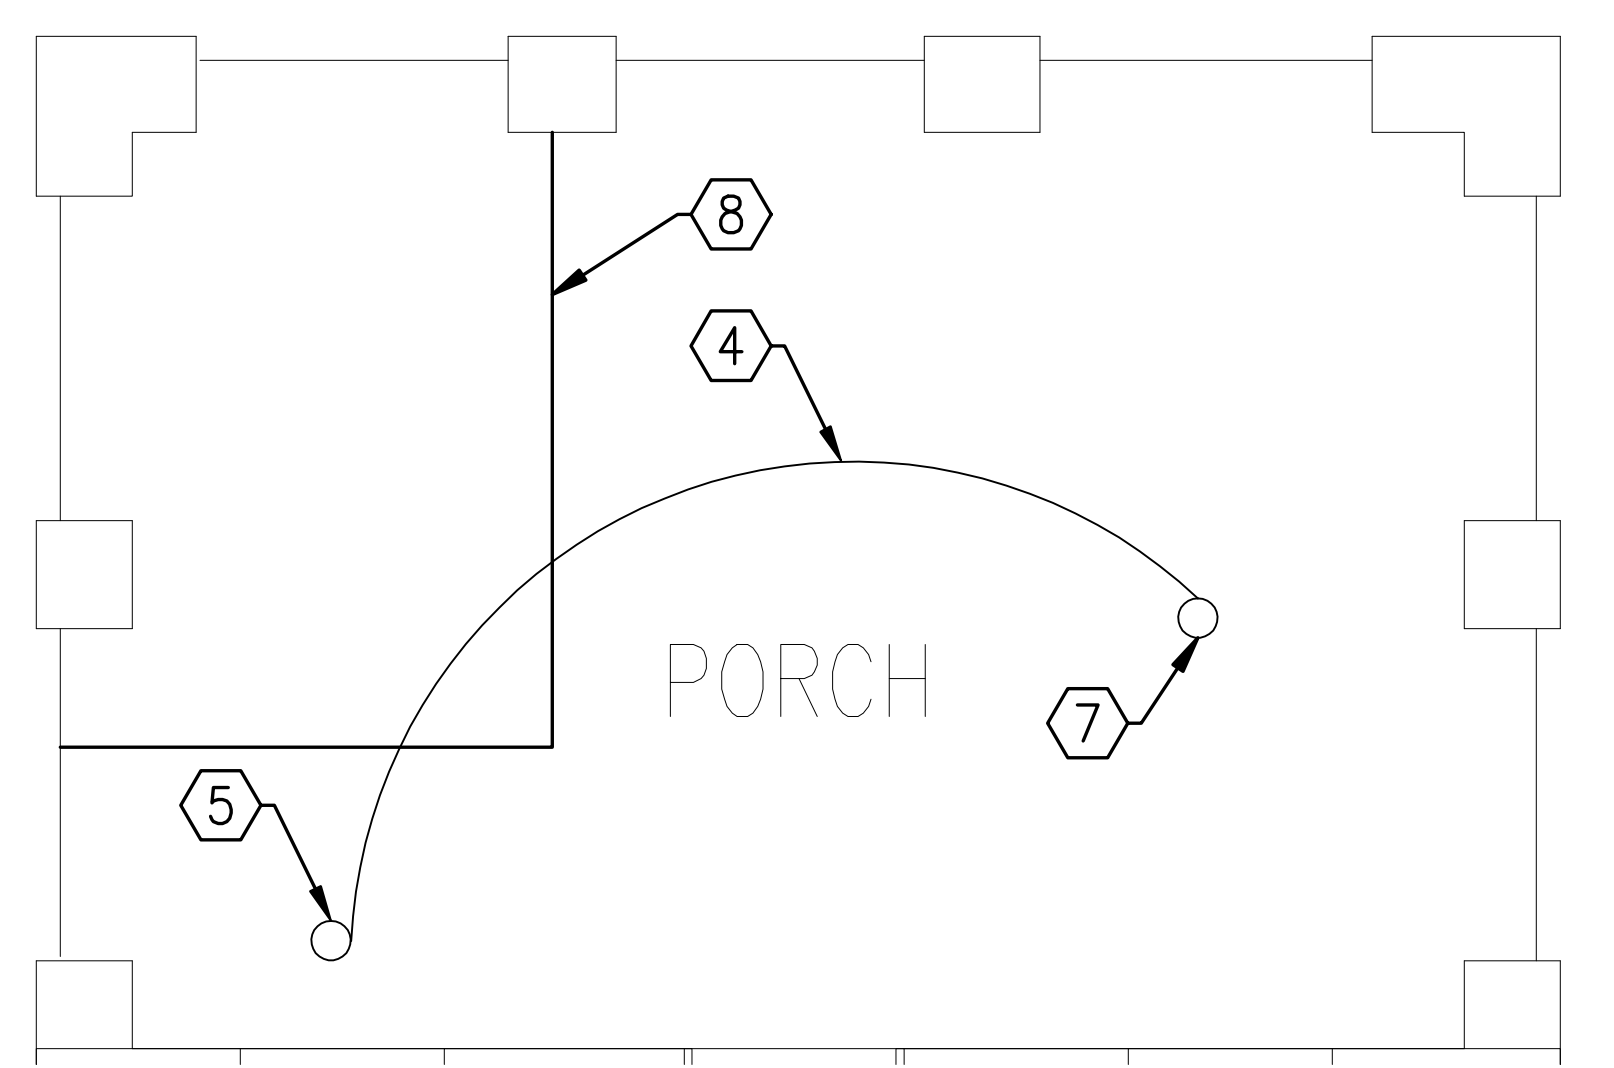

FIRST FLOOR NORTH PORCH LIGHTING PLAN - NEW WORK
SCALE: 1/4" = 1 FOOT

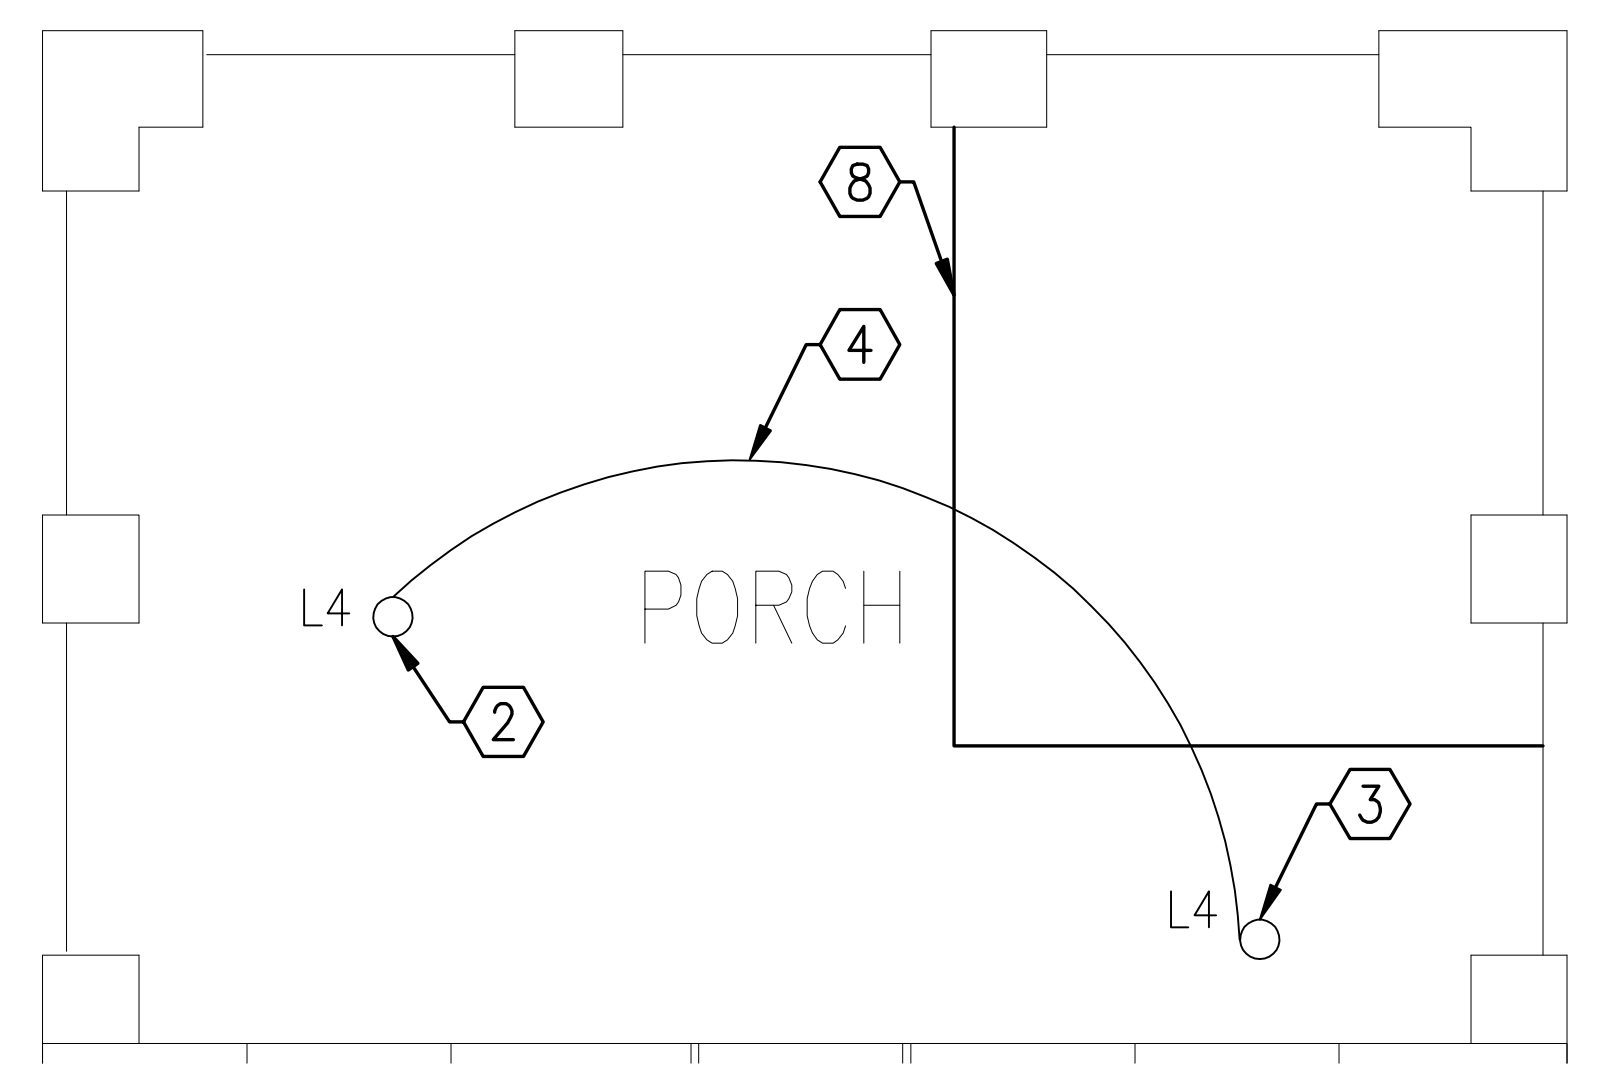

FIRST FLOOR SOUTH PORCH LIGHTING PLAN - NEW WORK
SCALE: 1/4" = 1 FOOT

3134.00 ISSUED FOR BIDDING & CONSTRUCTION REVISION 02 2/7/2014 07/21/2014	CONSULTANTS: CONTECH DESIGN, INCORPORATED Consulting Professional Engineers 519 Windsor Park Dr., Centerville, Ohio 45459 Phone: (937) 435-3722 Fax: (937) 435-4685 Email: engineers@contechdesign.com Engineer Project # 13003	 ARCHITECT / ENGINEERS: App Architecture creative focused design 615 Woodside Drive, Englewood, Ohio 45322 T 937.836.8898 F 937.832.3696 www.app-arch.com	Drawing Title ELECTRICAL NEW WORK SECOND FLOOR PLAN - LIGHTING FIRST FLOOR PORCH PLAN - LIGHTING Approved: Project Director -	Project Title CONSOLIDATE ADMIN SPACE & RESOLVE ENVIRONMENTAL CONDITIONS Location 17273 STATE ROUTE 104 CHILLICOTHE, OH 45601 Date 02/07/2014 Checked PNS Drawn CDI	Project No. 538-14-100 Building Number 212 Drawing No. 212- ES 3.0	 Office of Construction and Facilities Management Department of Veterans Affairs
---	---	--	---	---	--	--