

CONSTRUCTION NOTES

KEYNOTES

1	RELOCATE OMNI-CELL UNITS TO TEMPORARY CLEAN SUPPLY ROOM. DO NOT PROCEED WITH RELOCATION WORK PRIOR TO THE PHASE 1 CLEAN SUPPLY ROOM WORK AND AS DIRECTED BY COR.
2	RELOCATE WIRE RACK SHELVING TO TEMPORARY CLEAN SUPPLY ROOM. DO NOT PROCEED WITH RELOCATION WORK PRIOR TO THE PHASE 1 CLEAN SUPPLY ROOM WORK AND AS DIRECTED BY COR.
3	RELOCATE SUPPLY STORAGE CABINET DETEL TO TEMPORARY CLEAN SUPPLY ROOM. DO NOT PROCEED WITH RELOCATION WORK PRIOR TO THE PHASE 1 CLEAN SUPPLY ROOM WORK AND AS DIRECTED BY COR.
4	(E) DATA OUTLETS IN TEMP. CLEAN SUPPLY ROOM TO REMAIN. VERIFY LOCATIONS.
5	(N) PARTITION WALL FINISH ON (E) OFFICE SIDE TO MATCH EXISTING OFFICE FINISH

FINISH LEGEND - PHASE 1



TYPE	MARK	FINISH ITEM	MANUFACTURER	COLOR	NOTES
FLOORS	RF-1	RUBBER SHEET FLOORING (3mm)	NORA (OR APPROVED EQUAL)	2944 LOTUS FLOWER & BASE	PER VA; WELDED
	RB-1	6" RESILIENT BASE	JOHNSONITE (OR APPROVED EQUAL)	[SELECT 1: SILVER GREY OR ZEPHYR]	PER VA
	IB-1	INTEGRAL BASE	SEE FLOOR MATL	SEE FLOOR MATL	COVERED BASE
CEILINGS	GWB-1	GYP. WALL BOARD (SPECIAL COATING)			PER VA
PAINT	P-1	PAINT (SPECIAL COATING)			PER VA

FINISH SCHEDULE - PHASE 1

ROOM NUMBER	ROOM NAME	WALLS			CEILING		FLOOR		
		NORTH	EAST	WEST	MATERIAL	FINISH	MATERIAL	BASE	
E2-455	TEMPORARY CLEAN SUPPLY ROOM	P-1	P-1	P-1	P-1	GWB-1	SPECIAL	RF-1	IB-1
E2-457	(E) OFFICE	MATCH (E) FINISH	N/A	N/A	N/A	N/A	N/A	N/A	MATCH (E) FINISH

- 2'X2' SUSPENDED CEILING
- 2'X4' SUSPENDED CEILING
- 5/8" TYPE X GYP. BD CEILING
- (N) 2'X4' RECESSED TROFFER
- (E) 2'X4' RECESSED TROFFER, RE-INSTALLED
- (E) 2'X4' RECESSED TROFFER TO REMAIN
- (N) 2'X2' RECESSED TROFFER, UON AS (E)
- RECESSED DOWNLIGHT
- (N) LIGHT FIXTURE UON AS (E)
- PATIENT BED LIGHT
- EXIT SIGN
- SMOKE DETECTOR
- (N) CEILING SUPPLY DIFFUSER, UON AS (E)
- (N) CEILING RETURN REGISTER, UON AS (E)
- (N) CEILING EXHAUST, UON AS (E)
- NURSE CALL DOME LIGHT

FINAL BID DOCUMENTS

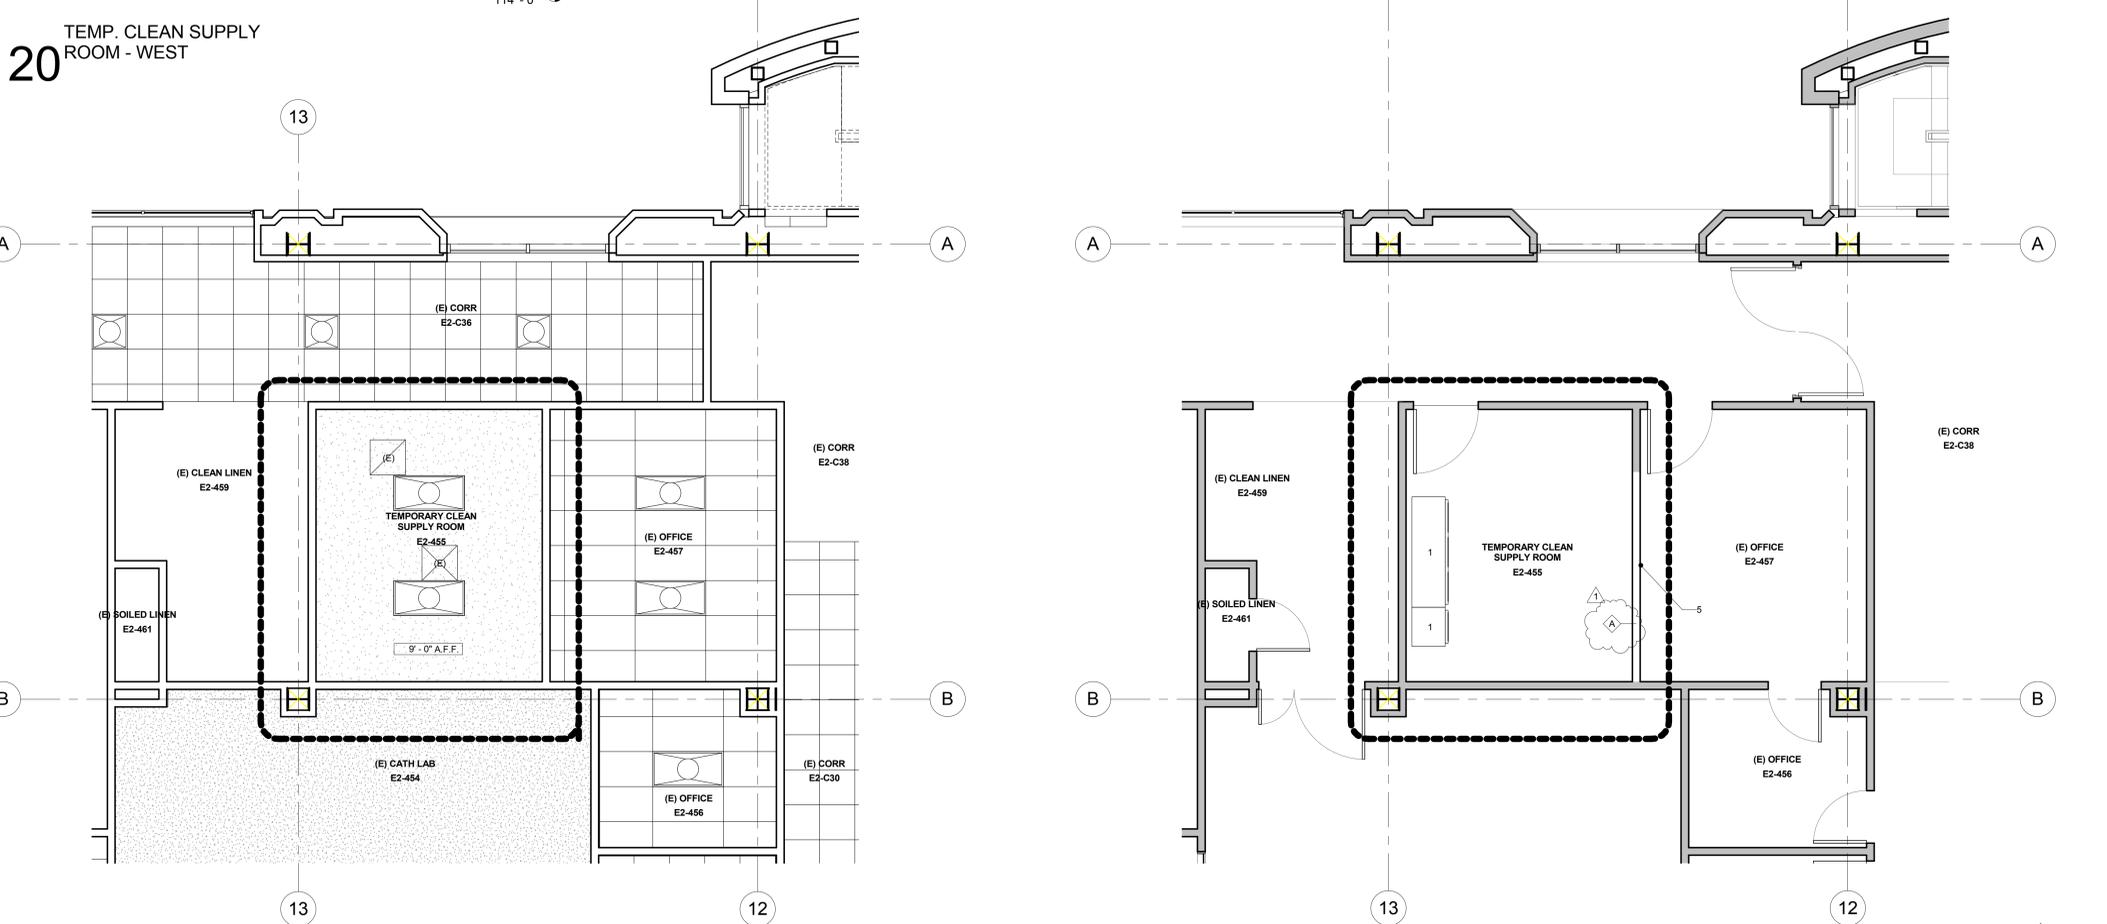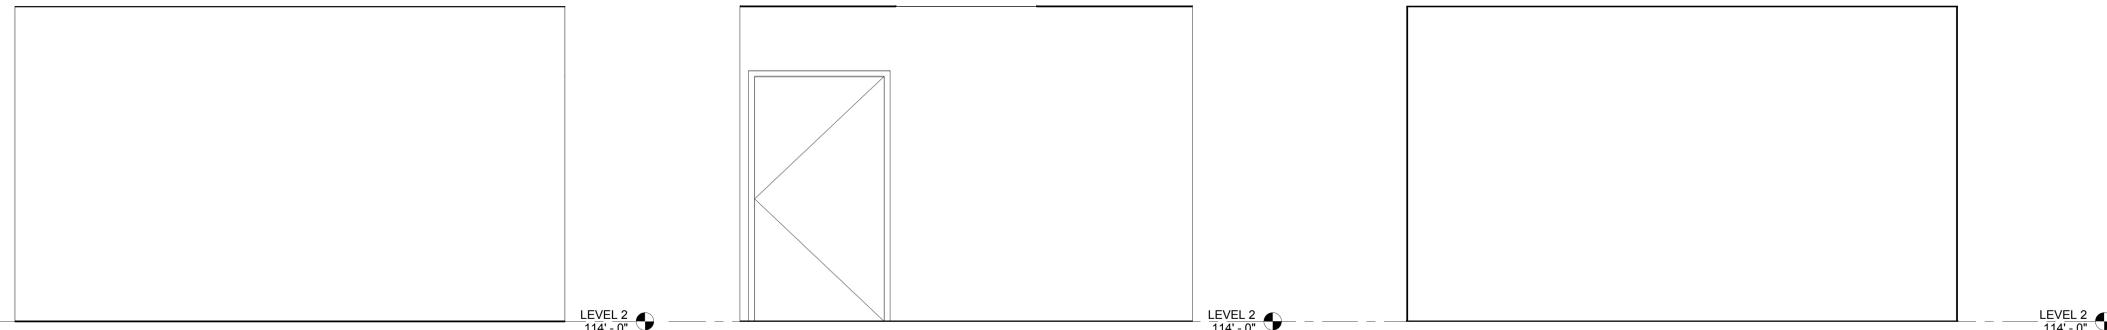

HILLIARD ARCHITECTS INC. COPYRIGHT


9/8/2014 2:48:37 PM

AMENDMENT 1	09.05.2014
Revisions:	Date

CONSULTANTS:

ARCHITECT/ENGINEERS:

251 Post Street, Suite 620
San Francisco, CA 94108
Tel 415 989 6400
www.HilliardArchitects.com

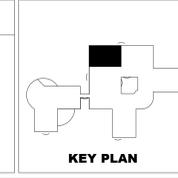

Drawing Title
PHASE 1 - TEMP. CLEAN SUPPLY ROOM ENLARGED PLANS & ELEV

Approved: Project Director

Project Title VA PALO ALTO B-100 CATH LAB RENOVATION & HYBRID OR			Project Number 640-13-134
Location VAPAHCS - PALO ALTO CAMPUS 3801 MIRANDA AVE, PALO ALTO, CA 94304			Building Number 100
Date 08.22.2014	Checked	Drawn	Drawing Number AS4-11
			Dwg. of

Office of Construction and Facilities Management

Department of Veterans Affairs