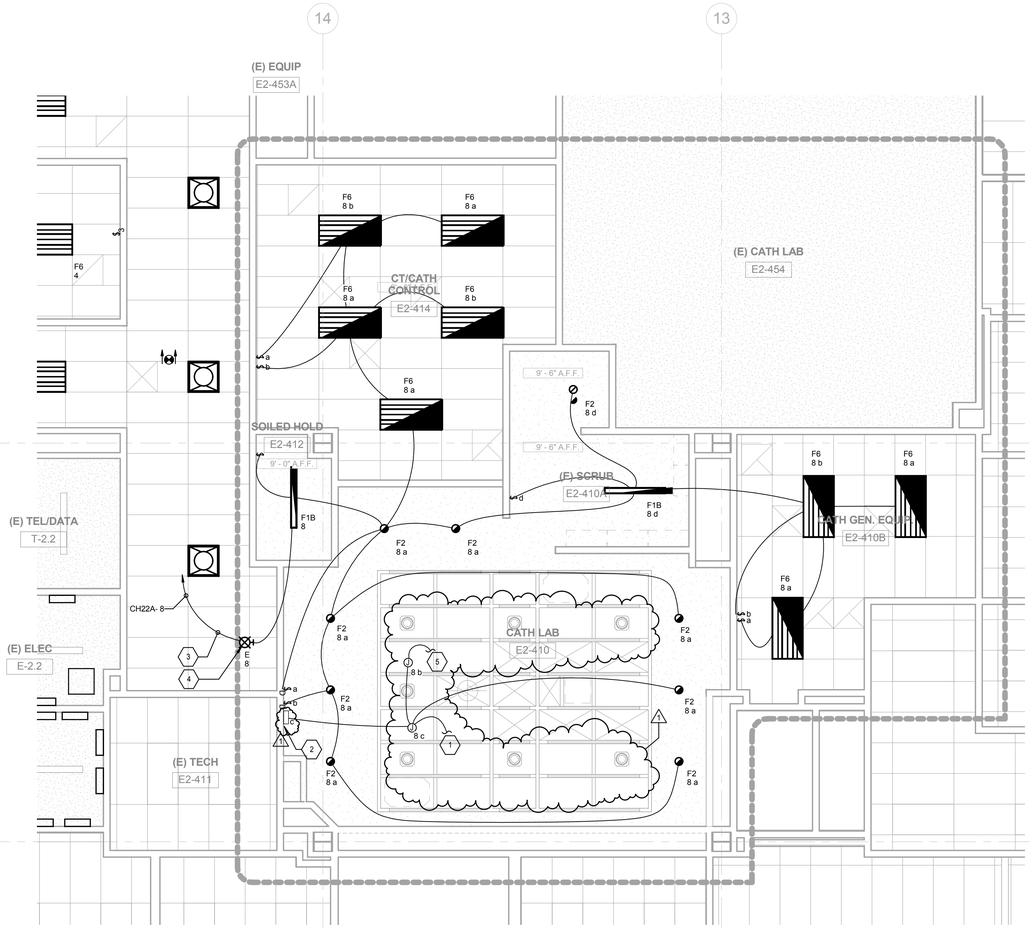

KEY NOTES:

1. JUNCTION BOX FROM CONNECTION TO LINEAR LIGHT FIXTURES IN HUNT AIR CEILING SYSTEM. REFER TO SHOPE DRAWINGS FROM CEILING SYSTEM MANUFACTURER AND COORDINATE INSTALLATION WITH INSTALLER. COORDINATE JUNCTION BOX LOCATIONS WITH CEILING ACCESS POINTS.
2. INTEGRATED LIGHTING CONTROL PANEL FOR SURGICAL LIGHTING SYSTEMS.
3. EXISTING HOMERUN AND CIRCUIT TO REMAIN. FIELD VERIFY LOCATION.
4. EXISTING WARNING LIGHT AND 120V CIRCUIT CONNECTION TO REMAIN . RECONNECT CONTROL WIRING TO NEW X-RAY MACHINE.
5. JUNCTION BOX FOR CONNECTION TO DOWNLIGHTS IN HUNT AIR CEILING SYSTEM. REFER TO SHOP DRAWINGS FROM CEILING SYSTEM MANUFACTURER AND COORDINATE INSTALLATION WITH INSTALLER. COORDINATE JUNCTION BOX LOCATIONS WITH CEILING ACCESS POINTS.

SHEET NOTES:

HILLIARD ARCHITECTS INC. COPYRIGHT

FINAL BID DOCUMENTS

Revisions:	Date
AMENDMENT 1	09.05.2014

CONSULTANTS:

SYSKA HENNESSY GROUP
A member company of SH Group, Inc.

Syska Hennessy Group, Inc.
425 California Street
Suite 700
San Francisco, CA 94104
Tel: 415.288.9060
Fax: 415.835.0385
www.syska.com

REGISTERED PROFESSIONAL ENGINEER — VICTOR G. STEFFEN — No. 11872 — Exp. 12/31/14 — ELECTRICAL — STATE OF CALIFORNIA

ARCHITECT/ENGINEERS:

ESTABLISHED 1988 HILLIARD ARCHITECTS GOING GREEN

HILLIARD ARCHITECTS, INC
251 Post Street, Suite 620
San Francisco, CA 94108-5017
Tel 415 989 6400, Fax 415 989 3056
www.HilliardArchitects.com

Drawing Title: **PHASE 3 - CATH LAB LIGHITNG PLAN**

Approved: Project Director

Project Title: **VA PALO ALTO B-100 CATH LAB RENOVATION AND HYBRID OR**

Location: **VAPAHCS - PALO ALTO CAMPUS**
3801 MIRANDA AVE, PALO ALTO, CA 94304

Date: **08.22.2014** | Checked: **Checker** | Drawn: **LTA**

Project Number: **640-13-134**

Building Number: **100**

Drawing Number: **EL-103**

Dwg. of

Office of Construction and Facilities Management

Department of Veterans Affairs

VA FORM 08-6231