


SUPPLY AIR IN LOCATION
12x36 VEL@ 611fpm

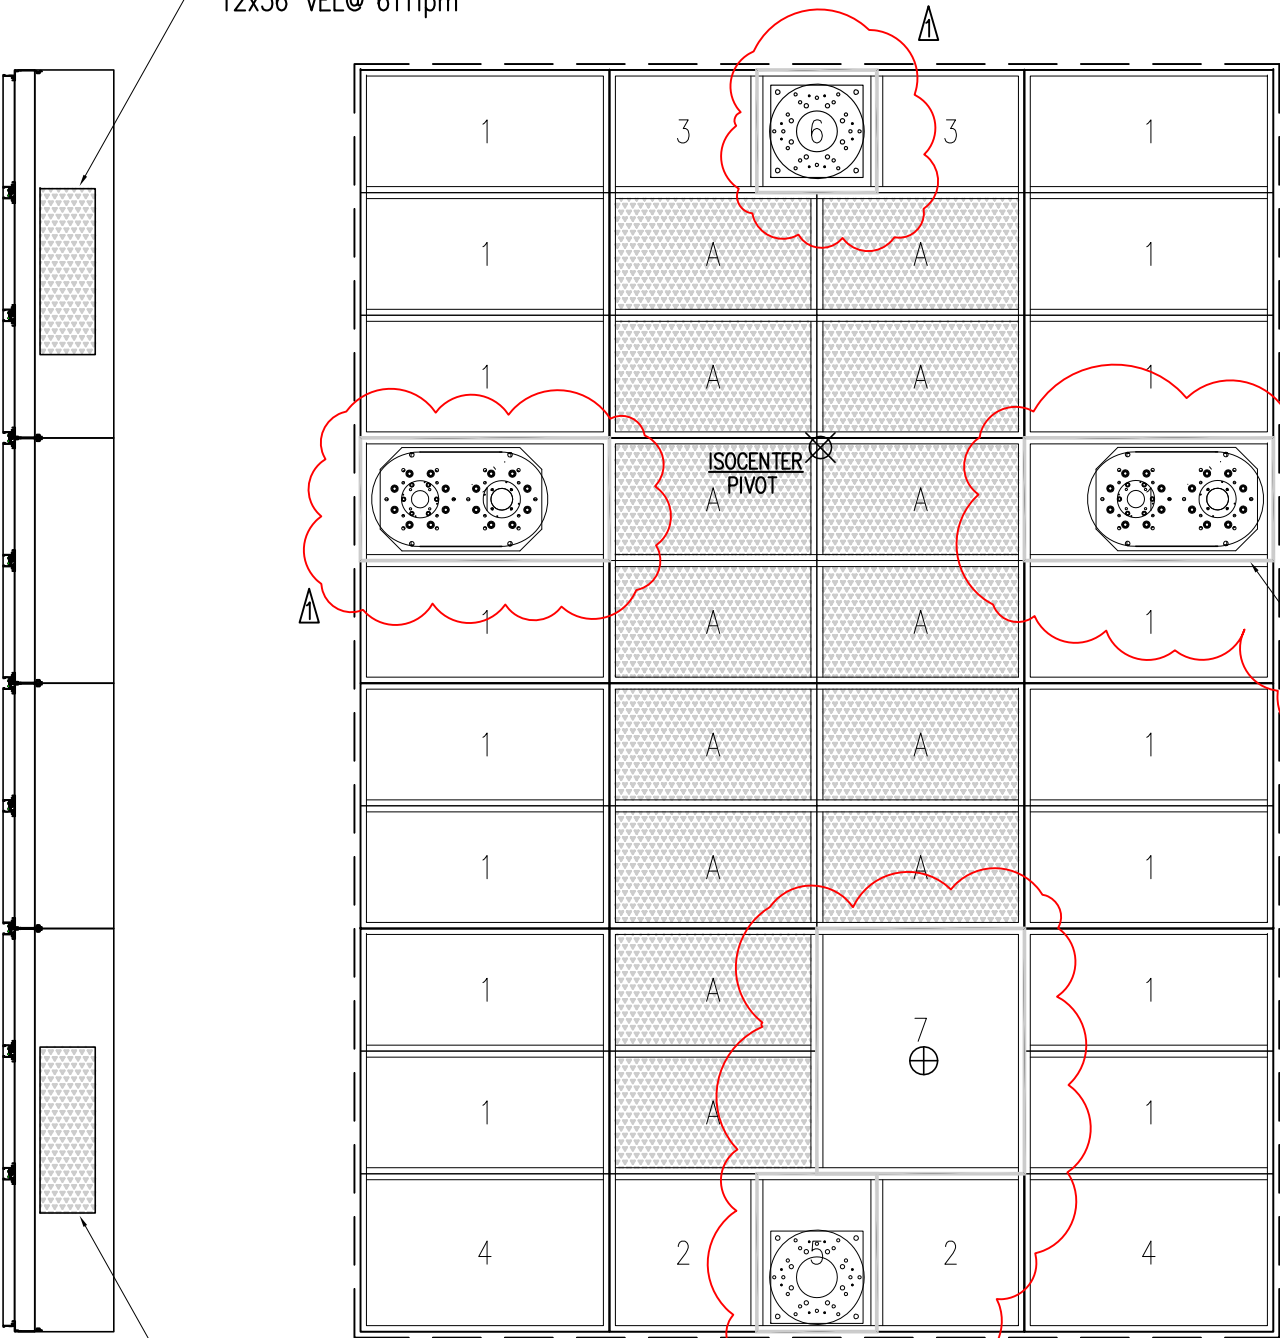

SUPPLY AIR IN LOCATION
12x36 VEL@ 611fpm

--- SUPPLY OPENINGS ---		
TAG	SIZE	QTY
A	26.600 x 45.000	14

--- BLANK OPENINGS ---		
TAG	SIZE	QTY
1	26.600 x 54.000	18
2	32.000 x 34.250	2
3	26.600 x 32.000	2
4	34.250 x 54.000	2
5	26.000 x 34.250	1
6	26.000 x 26.600	1
7	45.000 x 53.200	1

BLANK OFF ALL EQUIPMENT LOCATIONS
FROM SUPPLY AIR AND PROVIDE INTERNAL
ACCESS LOCATIONS - BY HUNTAIR

SYSTEM SIZING

DIFFUSER AREA: 116SF
ACH: 24 VELOCITY: 31fpm CFM: 3670

KEY:
= SUPPLY AIR

FILE NAME: 14-6019_VA_HYBR_Layout_rev07.dwg			
REV:	DATE:	BY:	DESCRIPTION
THIS DRAWING, SPECIFICATIONS, AND CONCEPTS CONTAINED HEREIN ARE THE SOLE PROPERTY OF HUNTAIR, AND MAY NOT BE REPRODUCED OR USED IN ANY FASHION WITHOUT THE PRIOR WRITTEN PERMISSION OF HUNTAIR CORPORATION.			

TOLERANCES UNLESS OTHERWISE SPECIFIED	
FRACTIONS : ±1/32	
0.0 :	±0.1
0.00 :	±0.03
0.000 :	±0.010
0.0000 :	GIVEN
ANGLES :	±0.5°

GRID OPENING LAYOUT
CLEANSUITE

DRAWN BY: mfarnsworth	HUNTAIR		19855 SW 124th AVENUE TUALATIN, OR 97062 Phone (503) 639-0113 Fax (503) 639-1269
ISSUED ON: 8/25/2014	TITLE: VA-PALO ALTO HYBRID ROOM CLEANSUITE LAYOUT		
CHECKED BY:	SIZE: B DRAWING NO: 14-6019		
SCALE: NONE	JOB NO: xxxx-xxx		SHEET: OF: