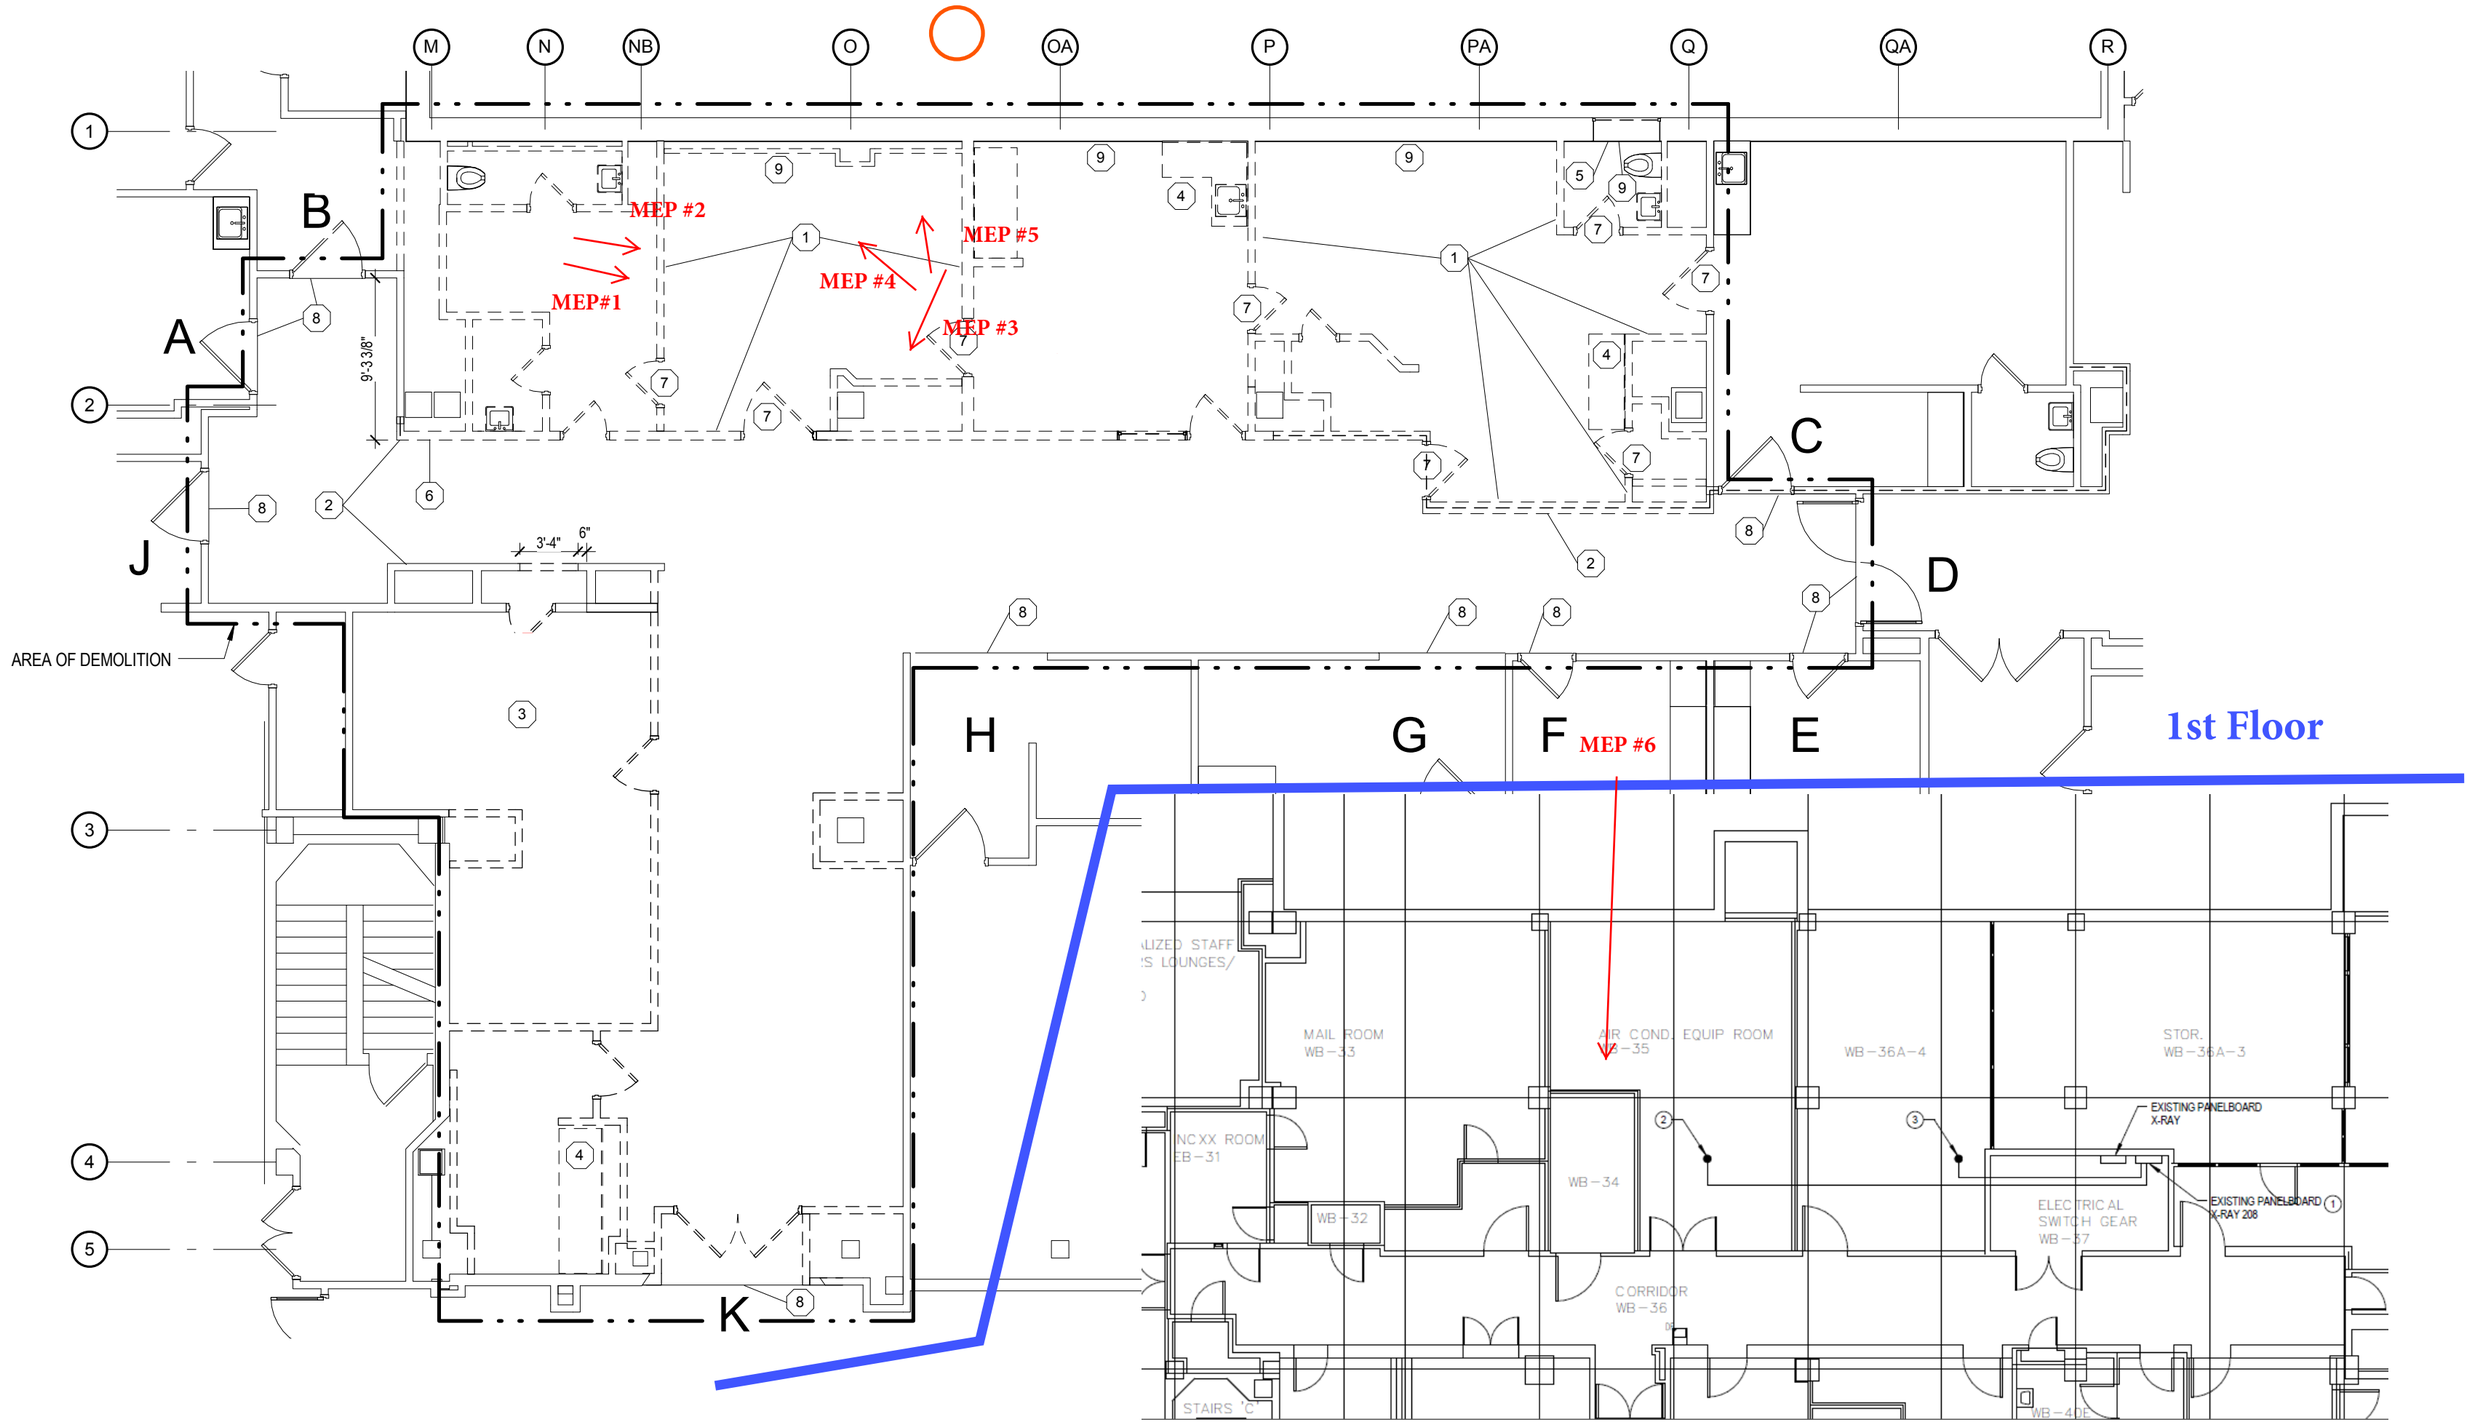

1 RADIOLOGY - DEMOLITION PLAN

1/8" = 1'-0"