


PARTIAL 6TH FLOOR NURSE CALL PLAN (UNDER CONTRACT)

SCALE: 3/16" - 1'-0"

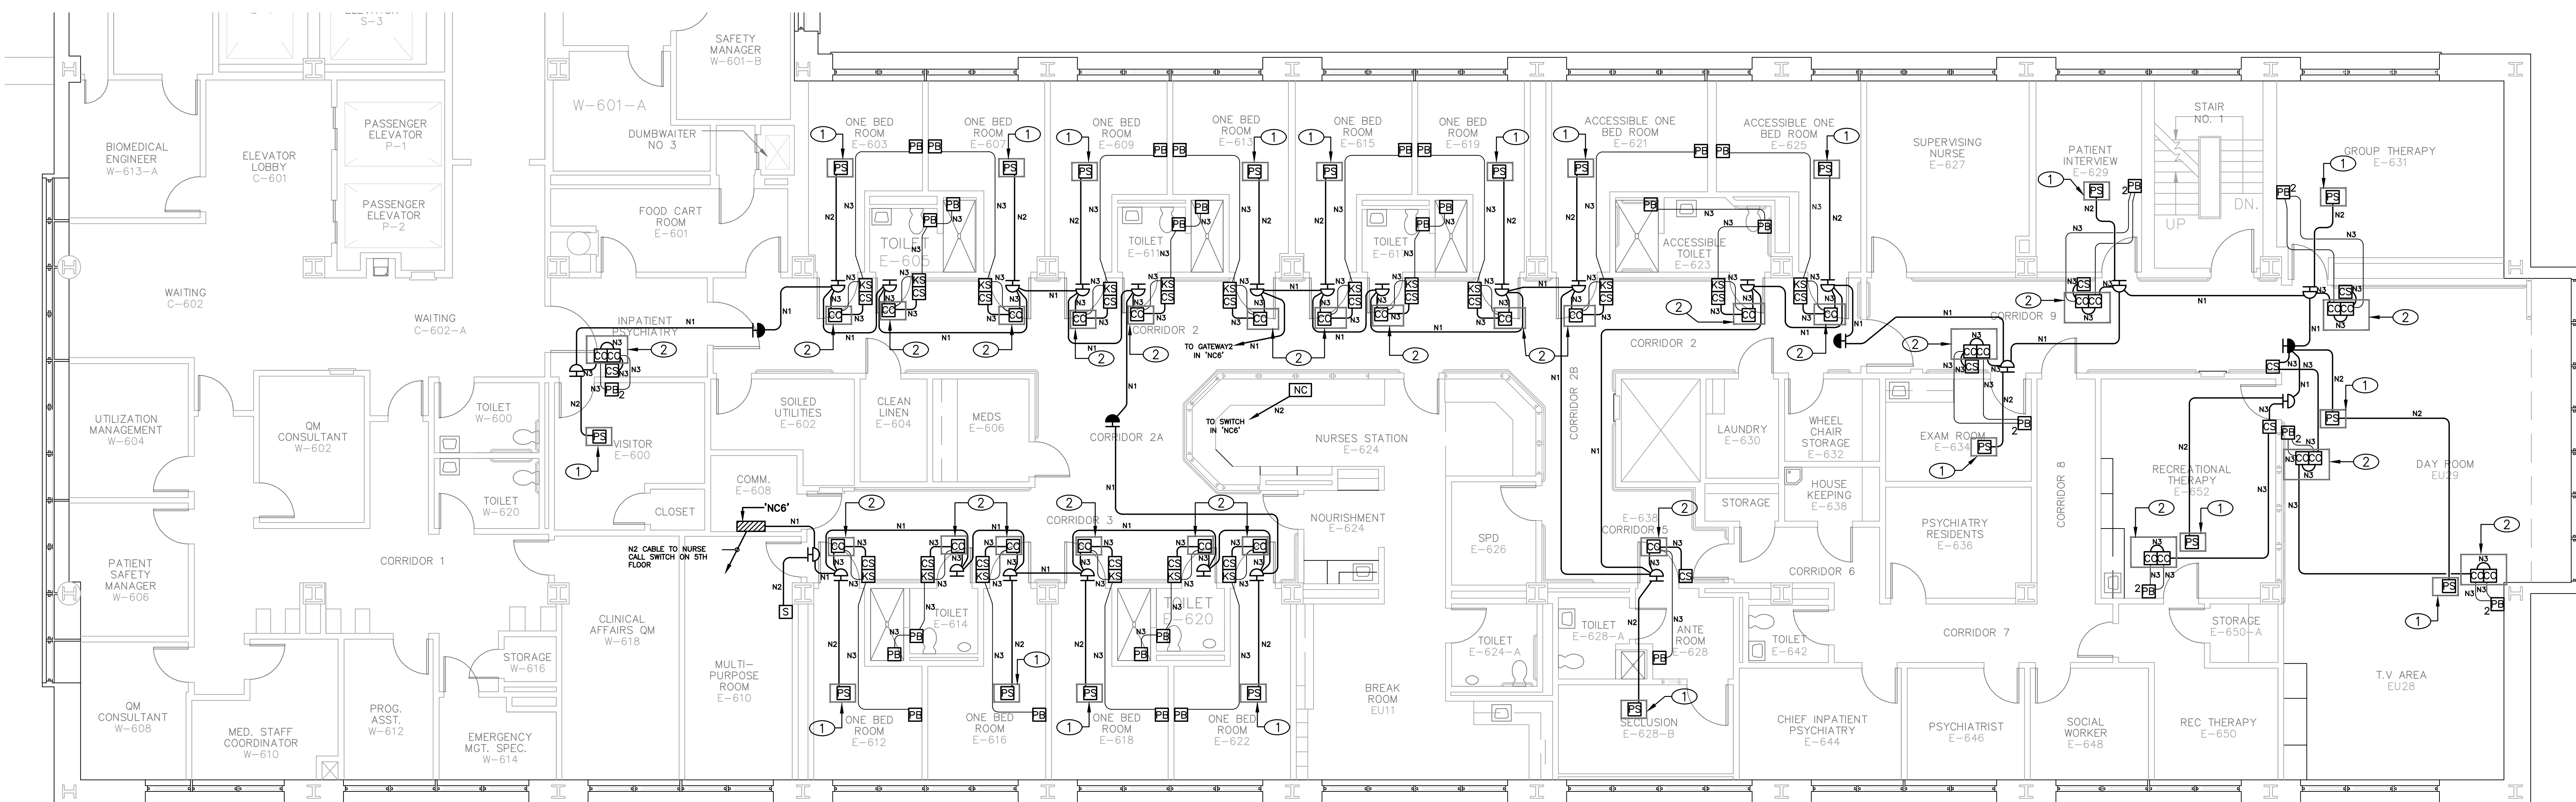

PARTIAL 6TH FLOOR NURSE CALL PLAN (WITH ADDITIONS)

SCALE: 3/16" - 1'-0"

- SHEET NOTES:**
- ① PATIENT STATION SHALL BE INSTALLED ABOVE CEILING IN AN ATLAS SOUND BACKBOX PART# 193-8 BACKBOX WITH VANDAL RESISTANT BAFFLE ATLAS SOUND PART# VP161-R8.
- ② CALL CORD STATION SHALL BE INSTALLED ABOVE CEILING IN A 4" SQUARE BOX WITH SINGLE-GANG RING. (PLEASE NOTE THAT SOME LOCATIONS REQUIRE MORE THAN ONE STATION, SEE PLANS).



**INTEGRATED
ELECTRONICS**
576 N. BUNDY DR.
RESNO, CA 93727
H. (559) 458-7250
AX(559) 458-7254
CL#: 787769

THE DESIGN AND INFORMATION CONTAINED ON THESE
DRAWINGS ARE THE EXCLUSIVE PROPERTY OF
INTEGRATED ELECTRONICS, AND THEY CANNOT BE USED
FOR INFORMATION PURPOSES OR DUPLICATED
WITHOUT THE CONSENT OF INTEGRATED ELECTRONICS
AND MAY BE RECALLED AT OUR OPTION.

DEPARTMENT OF
VETERAN AFFAIRS

DEPARTMENT OF VETERAN AFFAIRS
6TH FLOOR NURSE CALL UPGRADE
2615 E. CLINTON AVENUE
FRESNO, CA 93703
NURSE CALL SYSTEM

MARK	DATE	DESCRIPTION
ISSUE:		
PROJECT NO: ----		
CAD DWG FILE: ----		
DRAWN BY: J.I		

SHEET TITLE
6TH FLOOR NURSE CALL PLAN

NC-1