FIRST FLOOR - AREA C

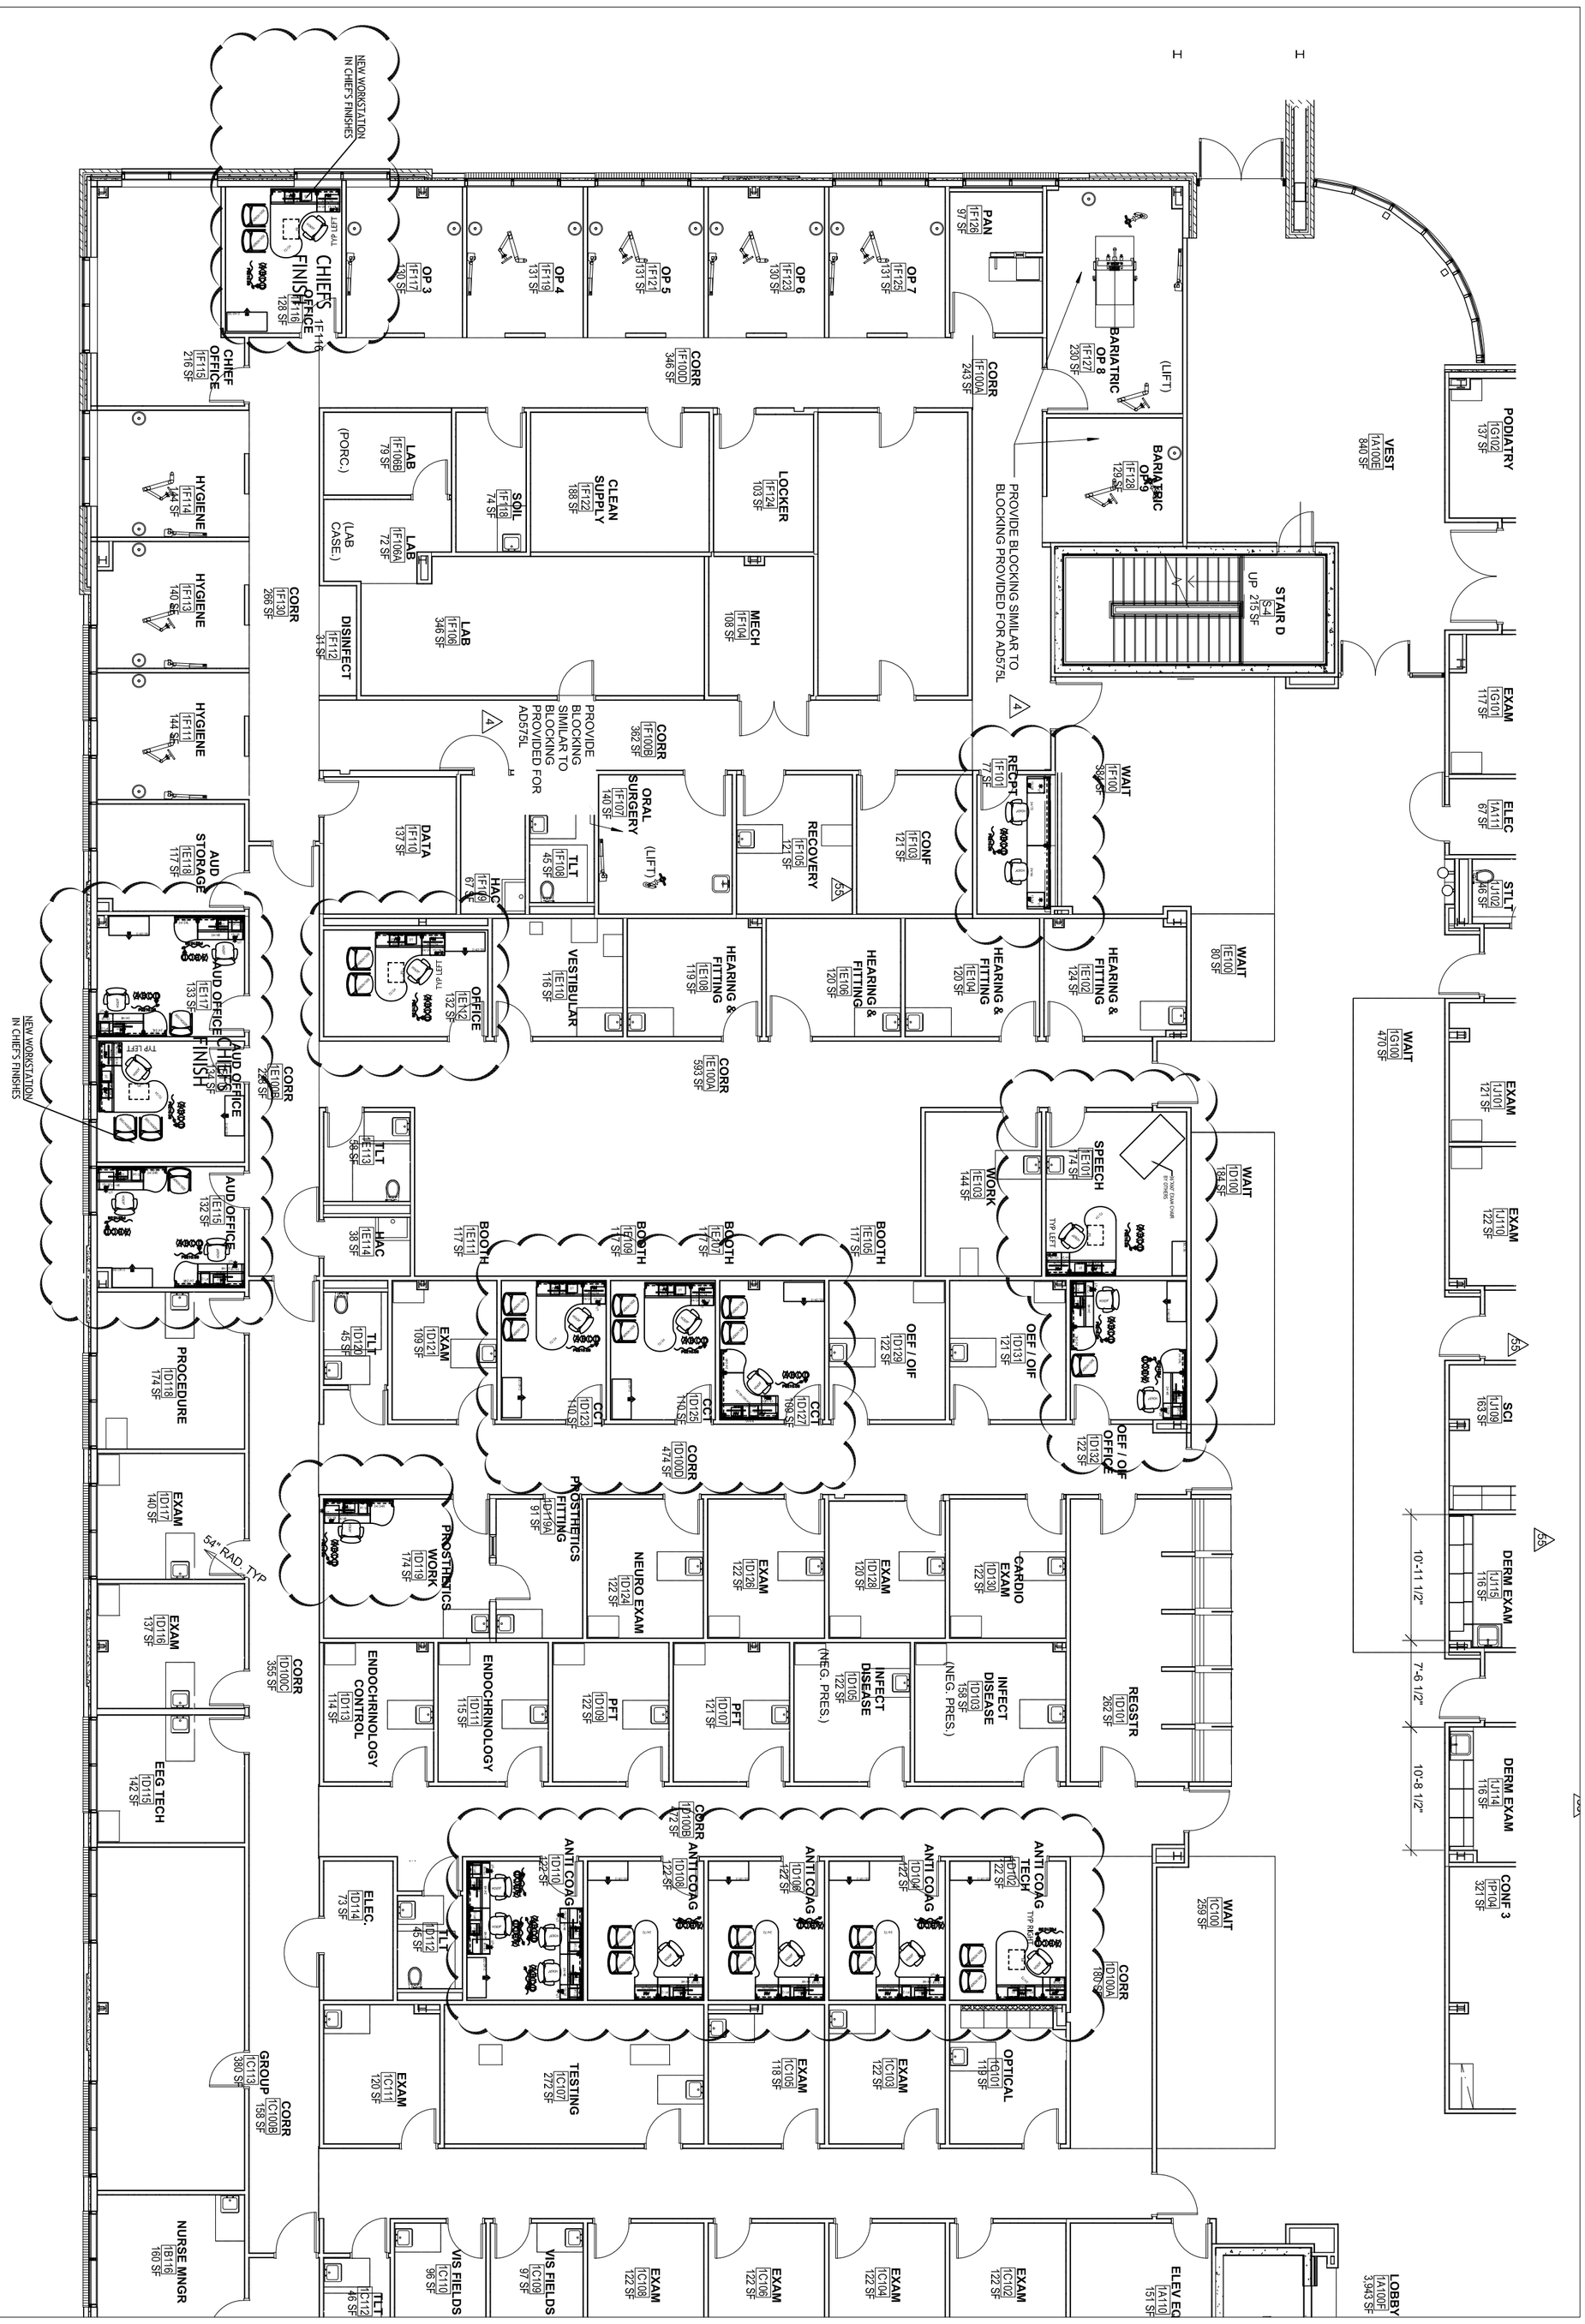

PROJECT NUMBER 93370A	**VA GR - FIRST FLOOR AREA C**	SIGNATURE OF APPROVAL: _____	DATE OF APPROVAL: _____
ACCOUNT MGR. MATT SCHAVE	GR CLINIC 5838 METRO WAY SW WYOMING MICHIGAN 49519	work² WorkSquared	WORKSQUARED.COM LOCATIONS IN GRAND RAPIDS NOVI LANSING KALAMAZOO TRAVERSE CITY
DESIGNER BRE VL - 108			SCALE: NTS
SHEET	FURNITURE PLAN		DATE: 6-20-2014

THIS DRAWING INCLUDING SPECIFICATIONS, CONCEPTS, AND ARRANGEMENTS REPRESENTED REMAIN THE PROPERTY OF WORKSQUARED. IT SHALL BE USED ONLY FOR THE SPECIFIC PROJECT FOR WHICH IT HAS BEEN PREPARED. WITHOUT PRIOR WRITTEN CONSENT BY WORKSQUARED, IT SHALL NOT BE COPIED, DISCLOSED TO THIRD PARTIES, USED TO PERFORM OR COMPLETE THIS PROJECT BY OTHERS OR USED IN CONNECTION WITH ANY OTHER WORK OR PROJECT OTHER THAN THE SPECIFIC PROJECT FOR WHICH IT HAS BEEN PREPARED.