


**KEY NOTES:**

12. 40 KIP MICROPILE FOUNDATION ELEMENT WITH FOOTING BRACKET. REFER TO SPECIFICATION SECTION 316216.

**1 PARTIAL BASEMENT FLOOR / FOUNDATION PLAN**  
S301 1/8" = 1'-0"

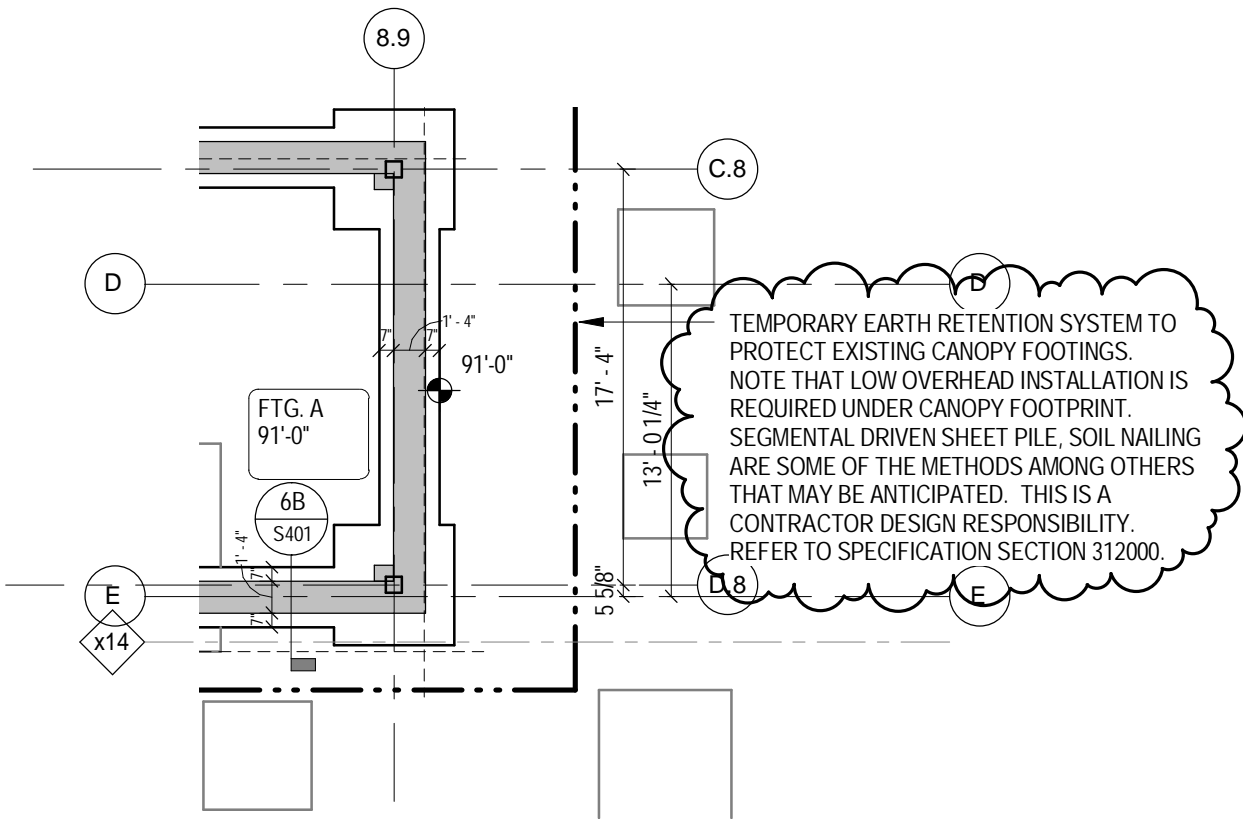

**1 PARTIAL BASEMENT FLOOR / FOUNDATION PLAN**  
S301 1/8" = 1'-0"