





**THP Limited, Inc.**  
 100 East Eighth Street  
 Cincinnati, Ohio 45202  
 Phone: 513.241.3222  
 Fax: 513.241.2981  
 www.thpltd.com

PROJECT CLINICAL ADDITION	THP # 08301.15	DRAWING NUMBER
TITLE REVISED DETAILS 4/S401 AND 5/S401		SKS-004
ISSUE		
BY FJE/SET	DATE 09/09/14	

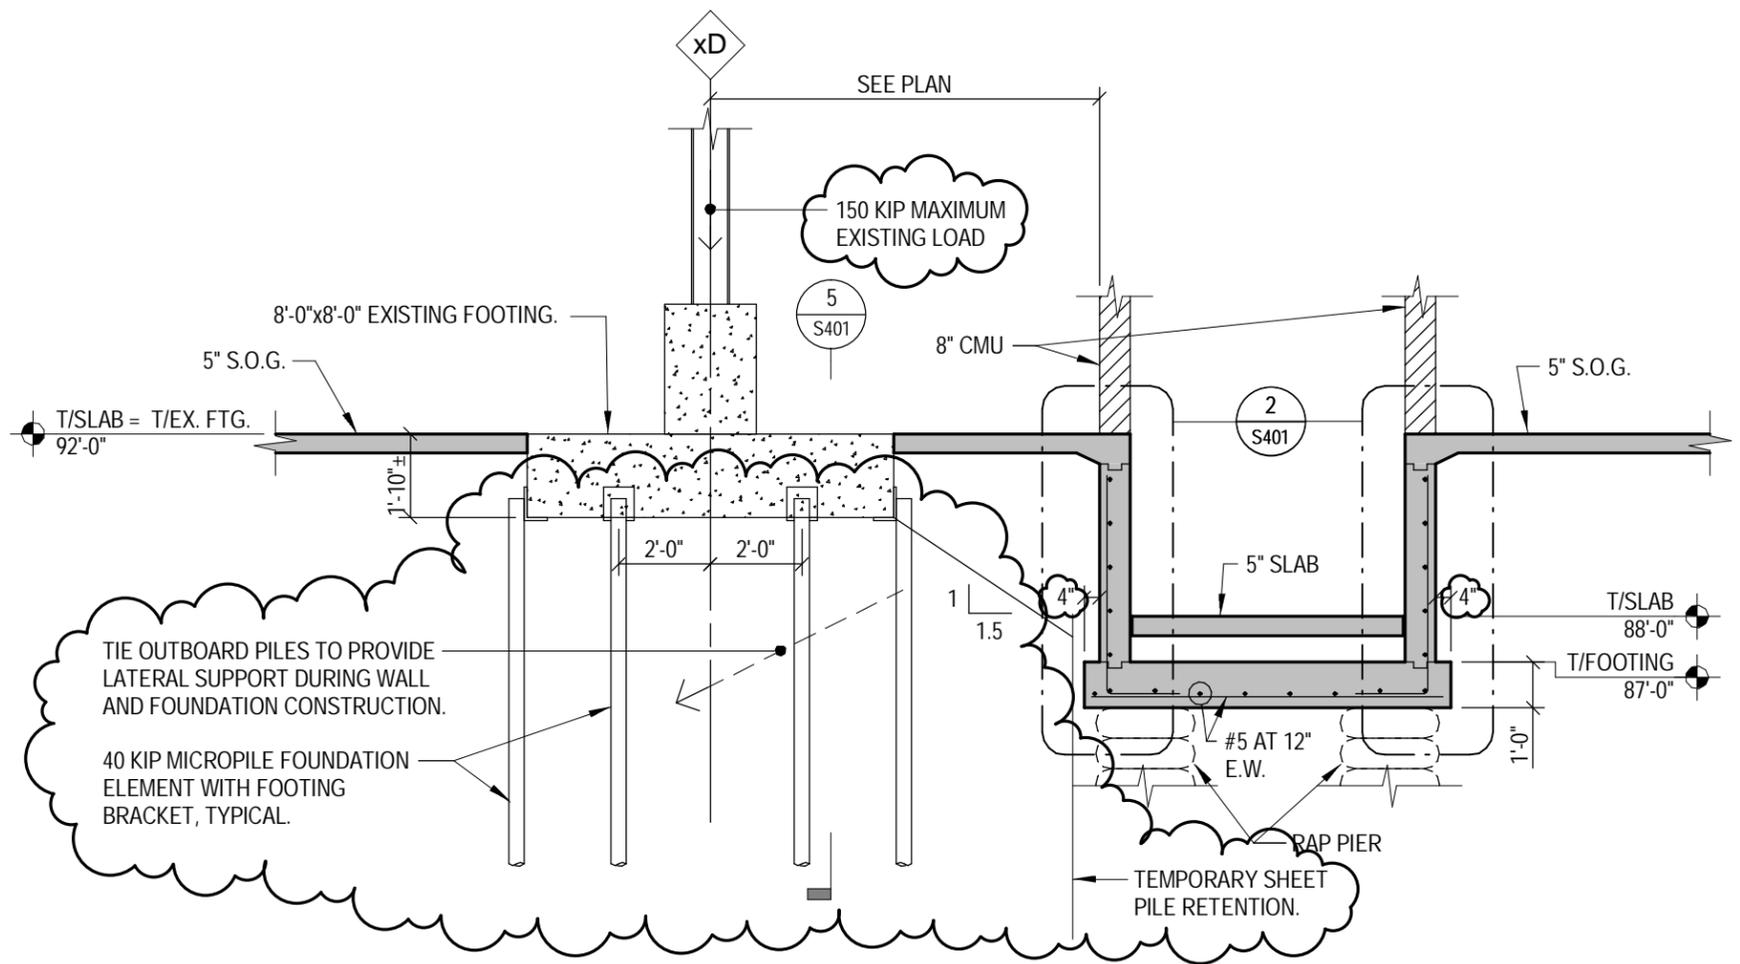

**4 SECTION**  
 S401 1/4" = 1'-0"

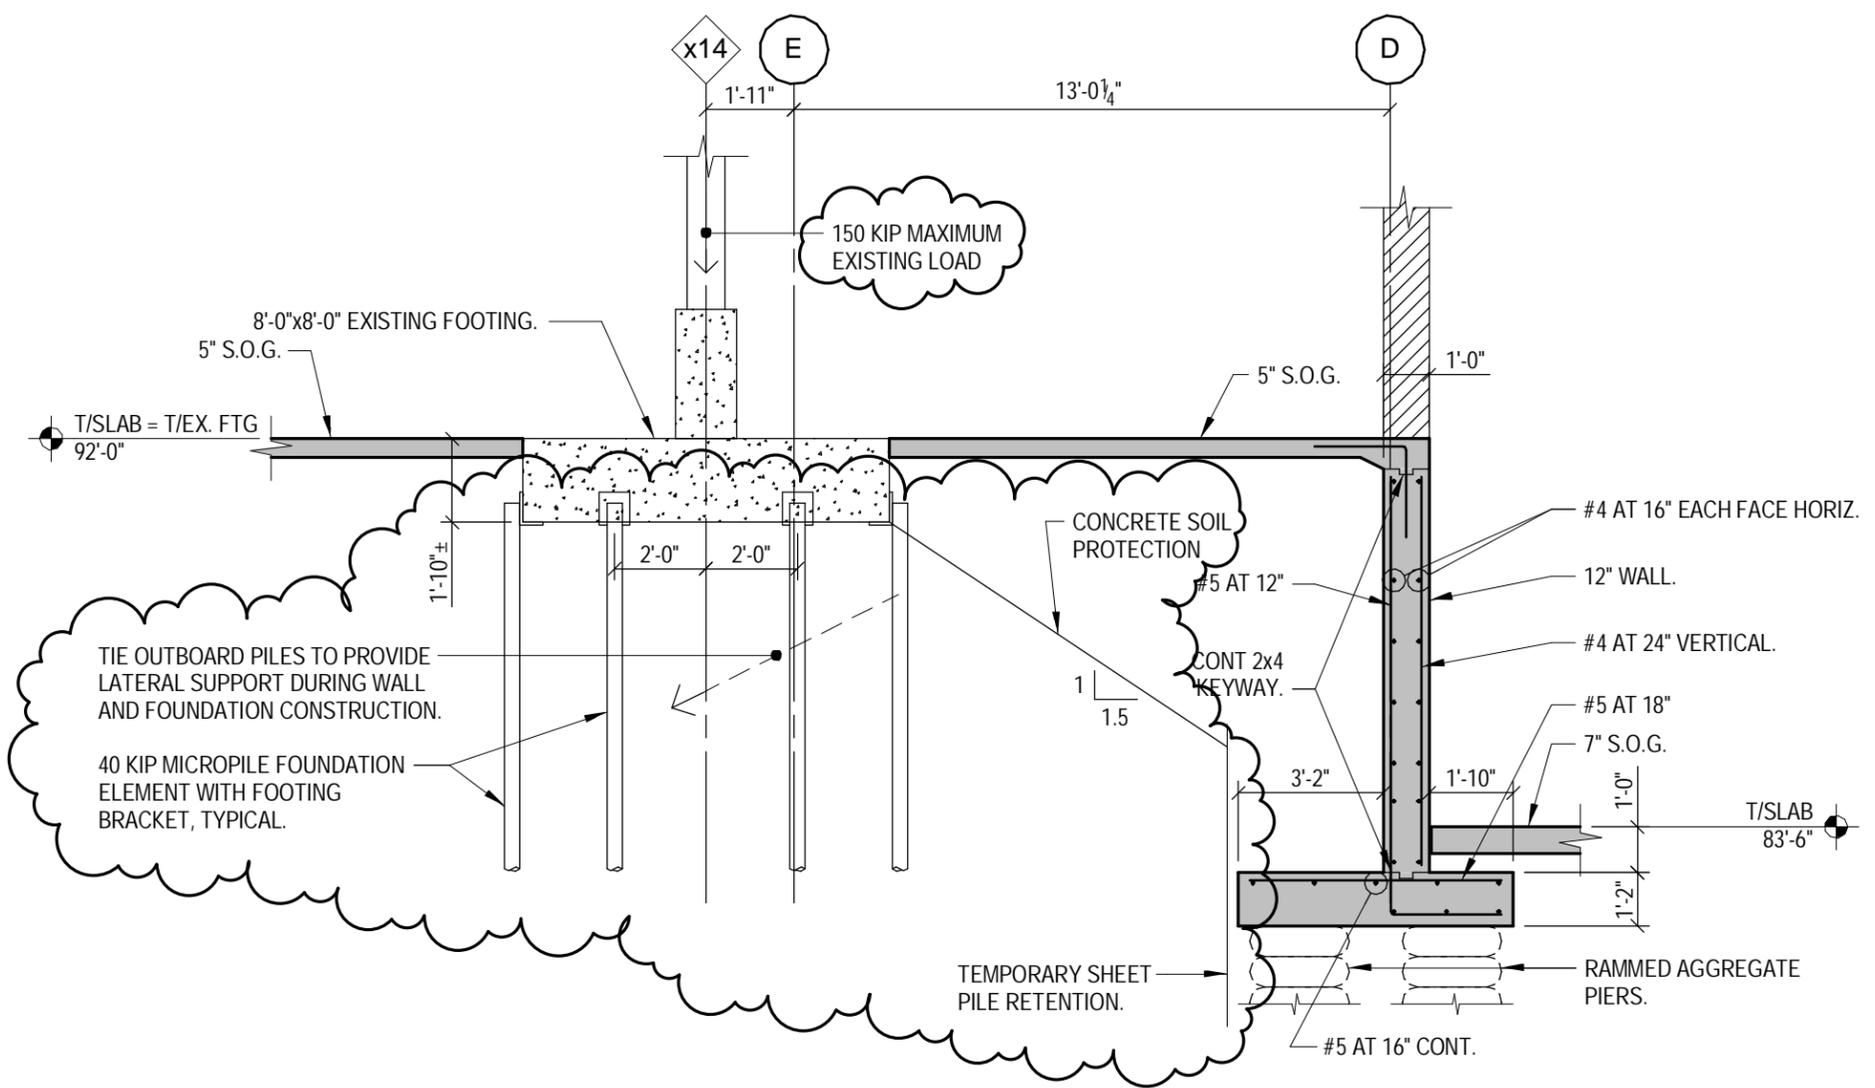

**5 SECTION**  
 S401 1/4" = 1'-0"