
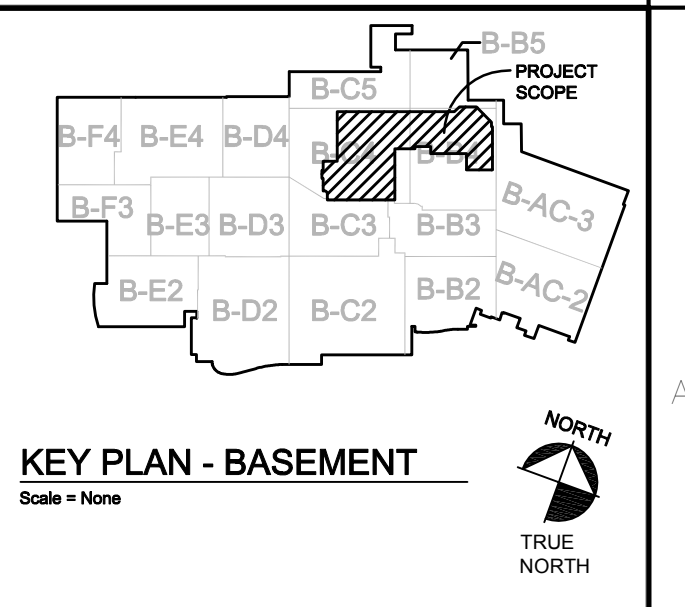


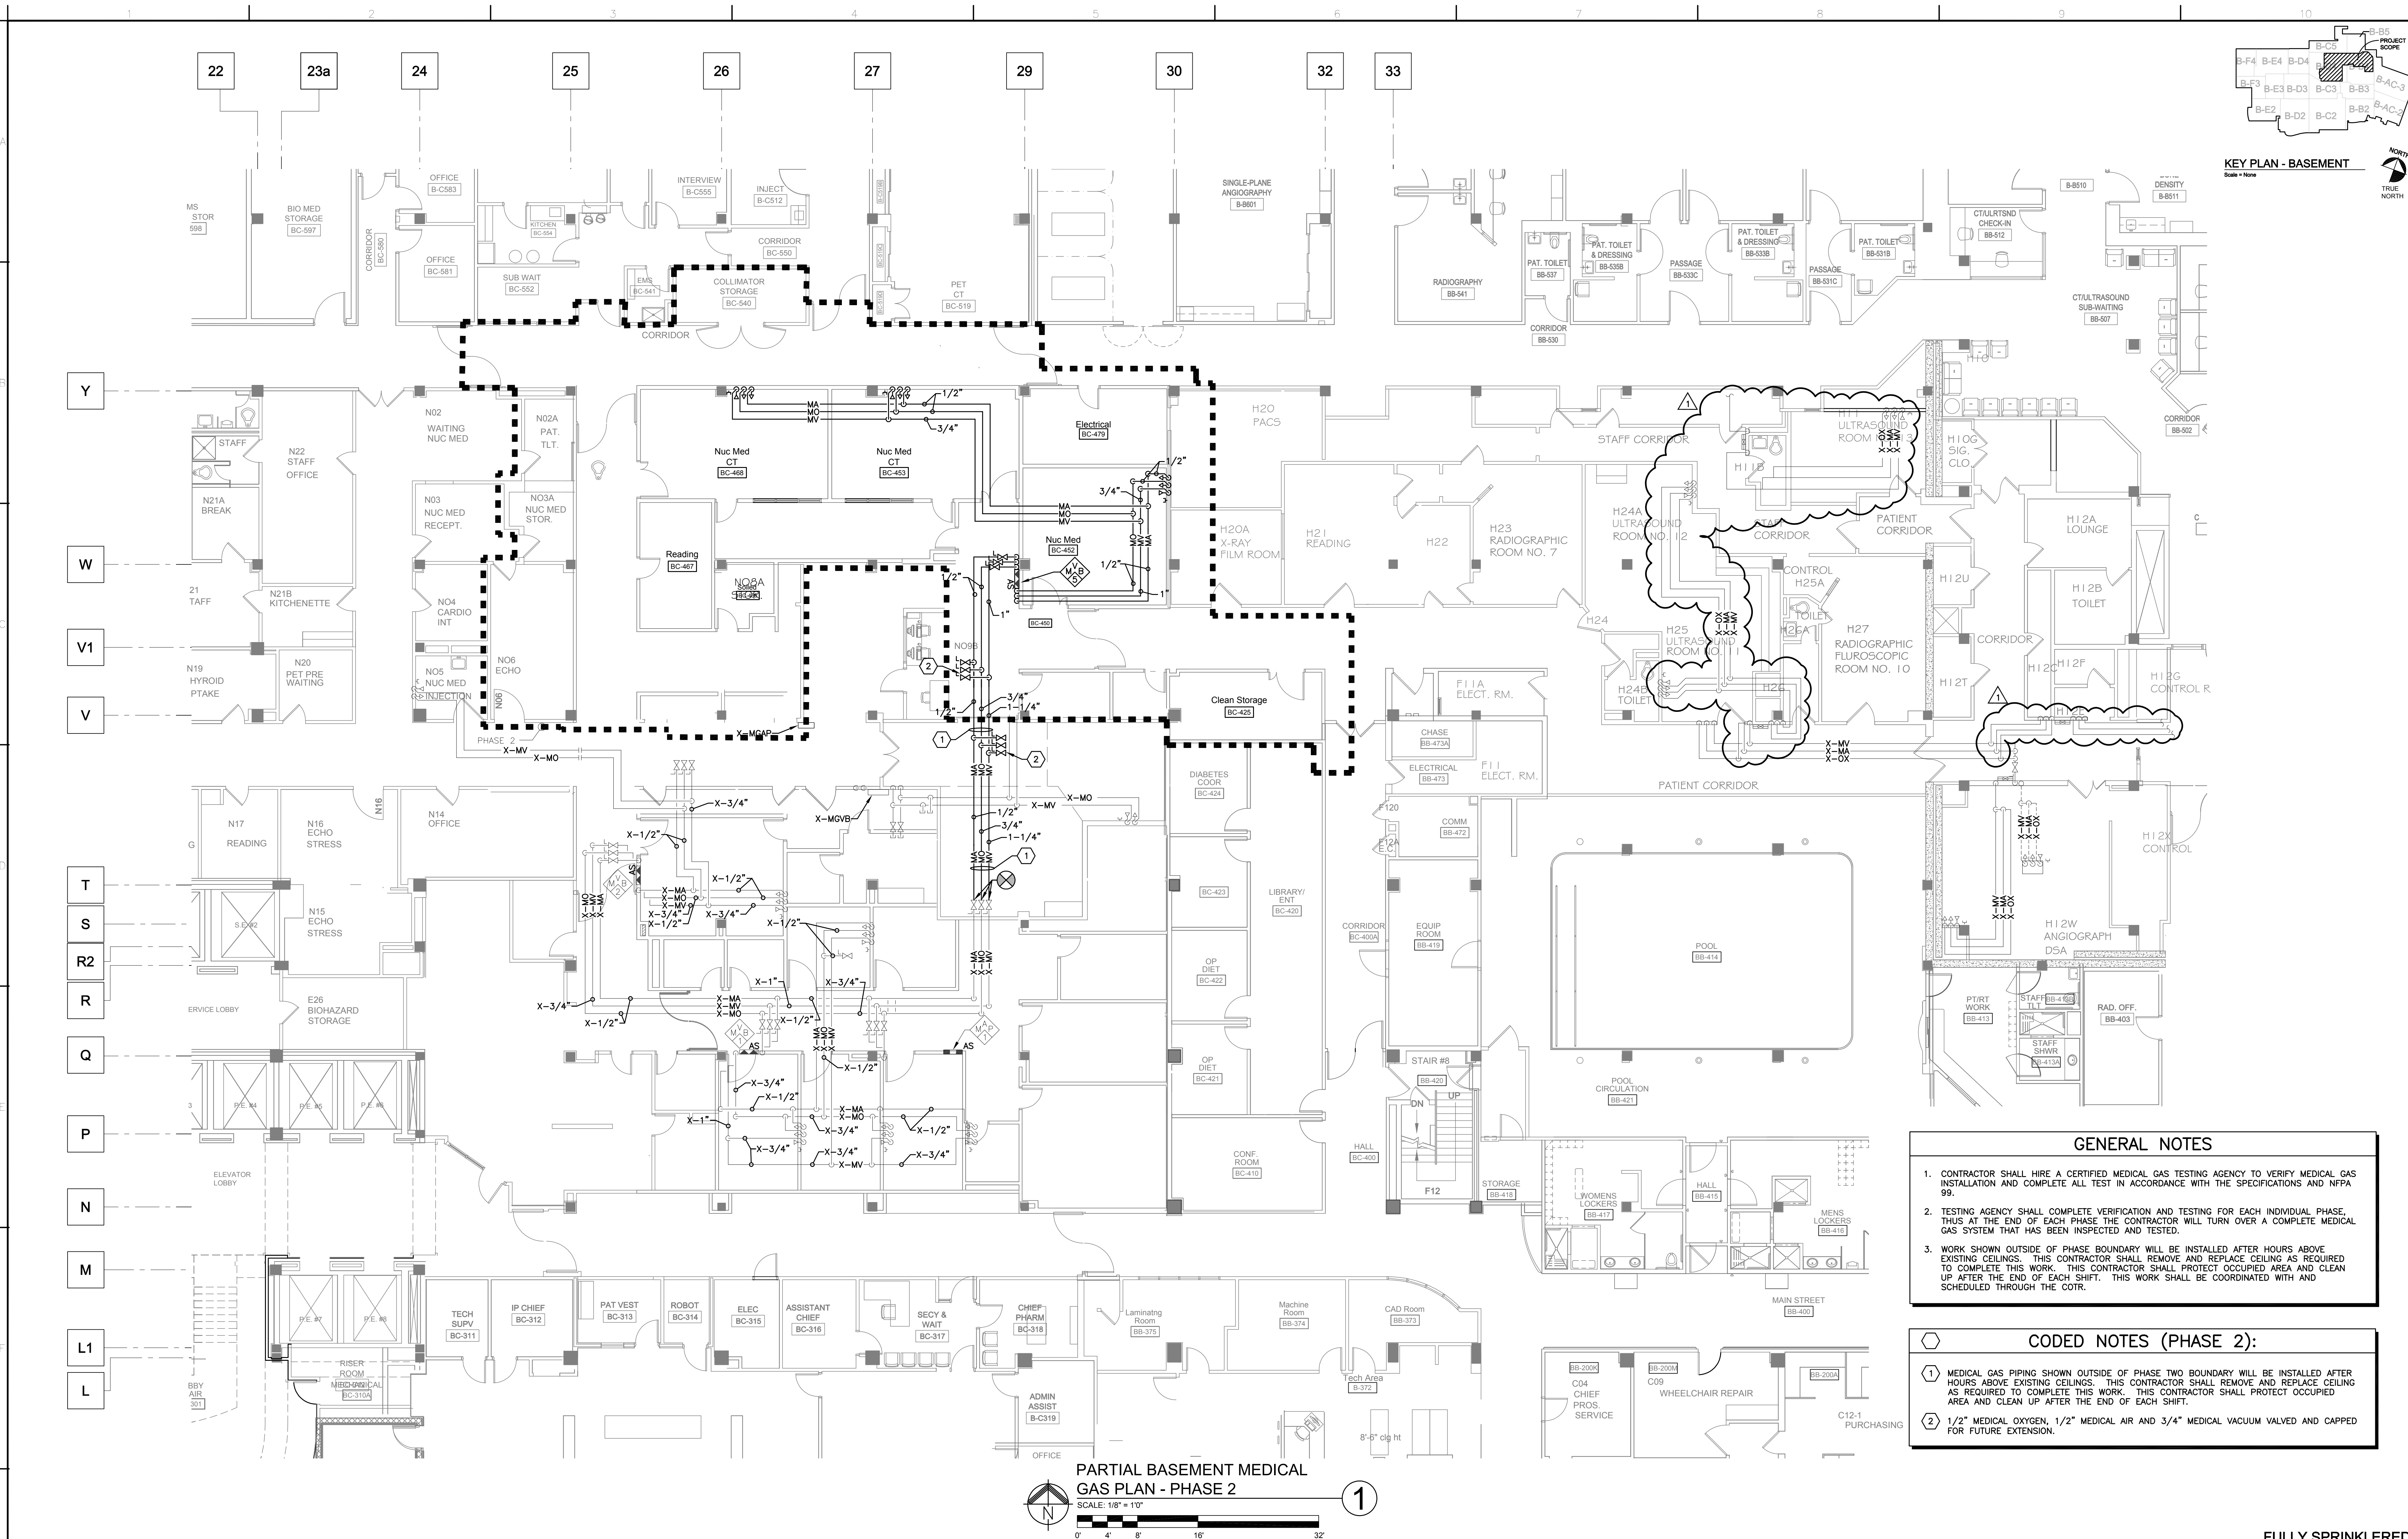

- GENERAL NOTES**
 - CONTRACTOR SHALL HIRE A CERTIFIED MEDICAL GAS TESTING AGENCY TO VERIFY MEDICAL GAS INSTALLATION AND COMPLETE ALL TEST IN ACCORDANCE WITH THE SPECIFICATIONS AND NFPA 99.
 - TESTING AGENCY SHALL COMPLETE VERIFICATION AND TESTING FOR EACH INDIVIDUAL PHASE, THUS AT THE END OF EACH PHASE THE CONTRACTOR WILL TURN OVER A COMPLETE MEDICAL GAS SYSTEM THAT HAS BEEN INSPECTED AND TESTED.
 - WORK SHOWN OUTSIDE OF PHASE BOUNDARY WILL BE INSTALLED AFTER HOURS ABOVE EXISTING CEILING. THIS CONTRACTOR SHALL REMOVE AND REPLACE CEILING AS REQUIRED TO COMPLETE THIS WORK. THIS CONTRACTOR SHALL PROTECT OCCUPIED AREA AND CLEAN UP AFTER THE END OF EACH SHIFT. THIS WORK SHALL BE COORDINATED WITH AND SCHEDULED THROUGH THE COTR.
- CODED NOTES (PHASE 2):**
 - MEDICAL GAS PIPING SHOWN OUTSIDE OF PHASE TWO BOUNDARY WILL BE INSTALLED AFTER HOURS ABOVE EXISTING CEILING. THIS CONTRACTOR SHALL REMOVE AND REPLACE CEILING AS REQUIRED TO COMPLETE THIS WORK. THIS CONTRACTOR SHALL PROTECT OCCUPIED AREA AND CLEAN UP AFTER THE END OF EACH SHIFT.
 - 1/2" MEDICAL OXYGEN, 1/2" MEDICAL AIR AND 3/4" MEDICAL VACUUM VALVED AND CAPPED FOR FUTURE EXTENSION.

CONSULTANTS:		ARCHITECT:		Drawing Title		Project Title		Project Number		Office of Facilities Management	
 FREDRICK, FREDRICK & HELLER ENGINEERS, INC. 672 EAST ROYALTON ROAD BROADVIEW HTS., OHIO 44147 TEL: (440) 546-8888 FAX: (440) 546-8889		 Perspectus architecture 13212 Shaker Square Suite 204 Cleveland, Ohio 44120 P. 216.752.1800 F. 216.752.3833		PARTIAL BASEMENT MEDICAL GAS PLAN - PHASE 2		EXPAND AND RENOVATE NUCLEAR MEDICINE AND RADIOLOGY		541-14-101		Office of Facilities Management	
Amendment 02 Bid Issue Revisions:		2217 East 9th Street, Suite 350 Cleveland OH 44115-1257 216-875-0100/ (F) 216-875-0111 barberhoffman.com BARBER & HOFFMAN, INC. Consulting Engineers		Approved: Project Director		VAMC - WADE PARK		Building Number 1		Department of Veterans Affairs	
09/12/14 01/17/14 Date		FFH #13027				Location		Drawing Number 1-P6.2			
						Date 1-17-2014		Checked BMW		Dwg. of	
								Drawn DAD			