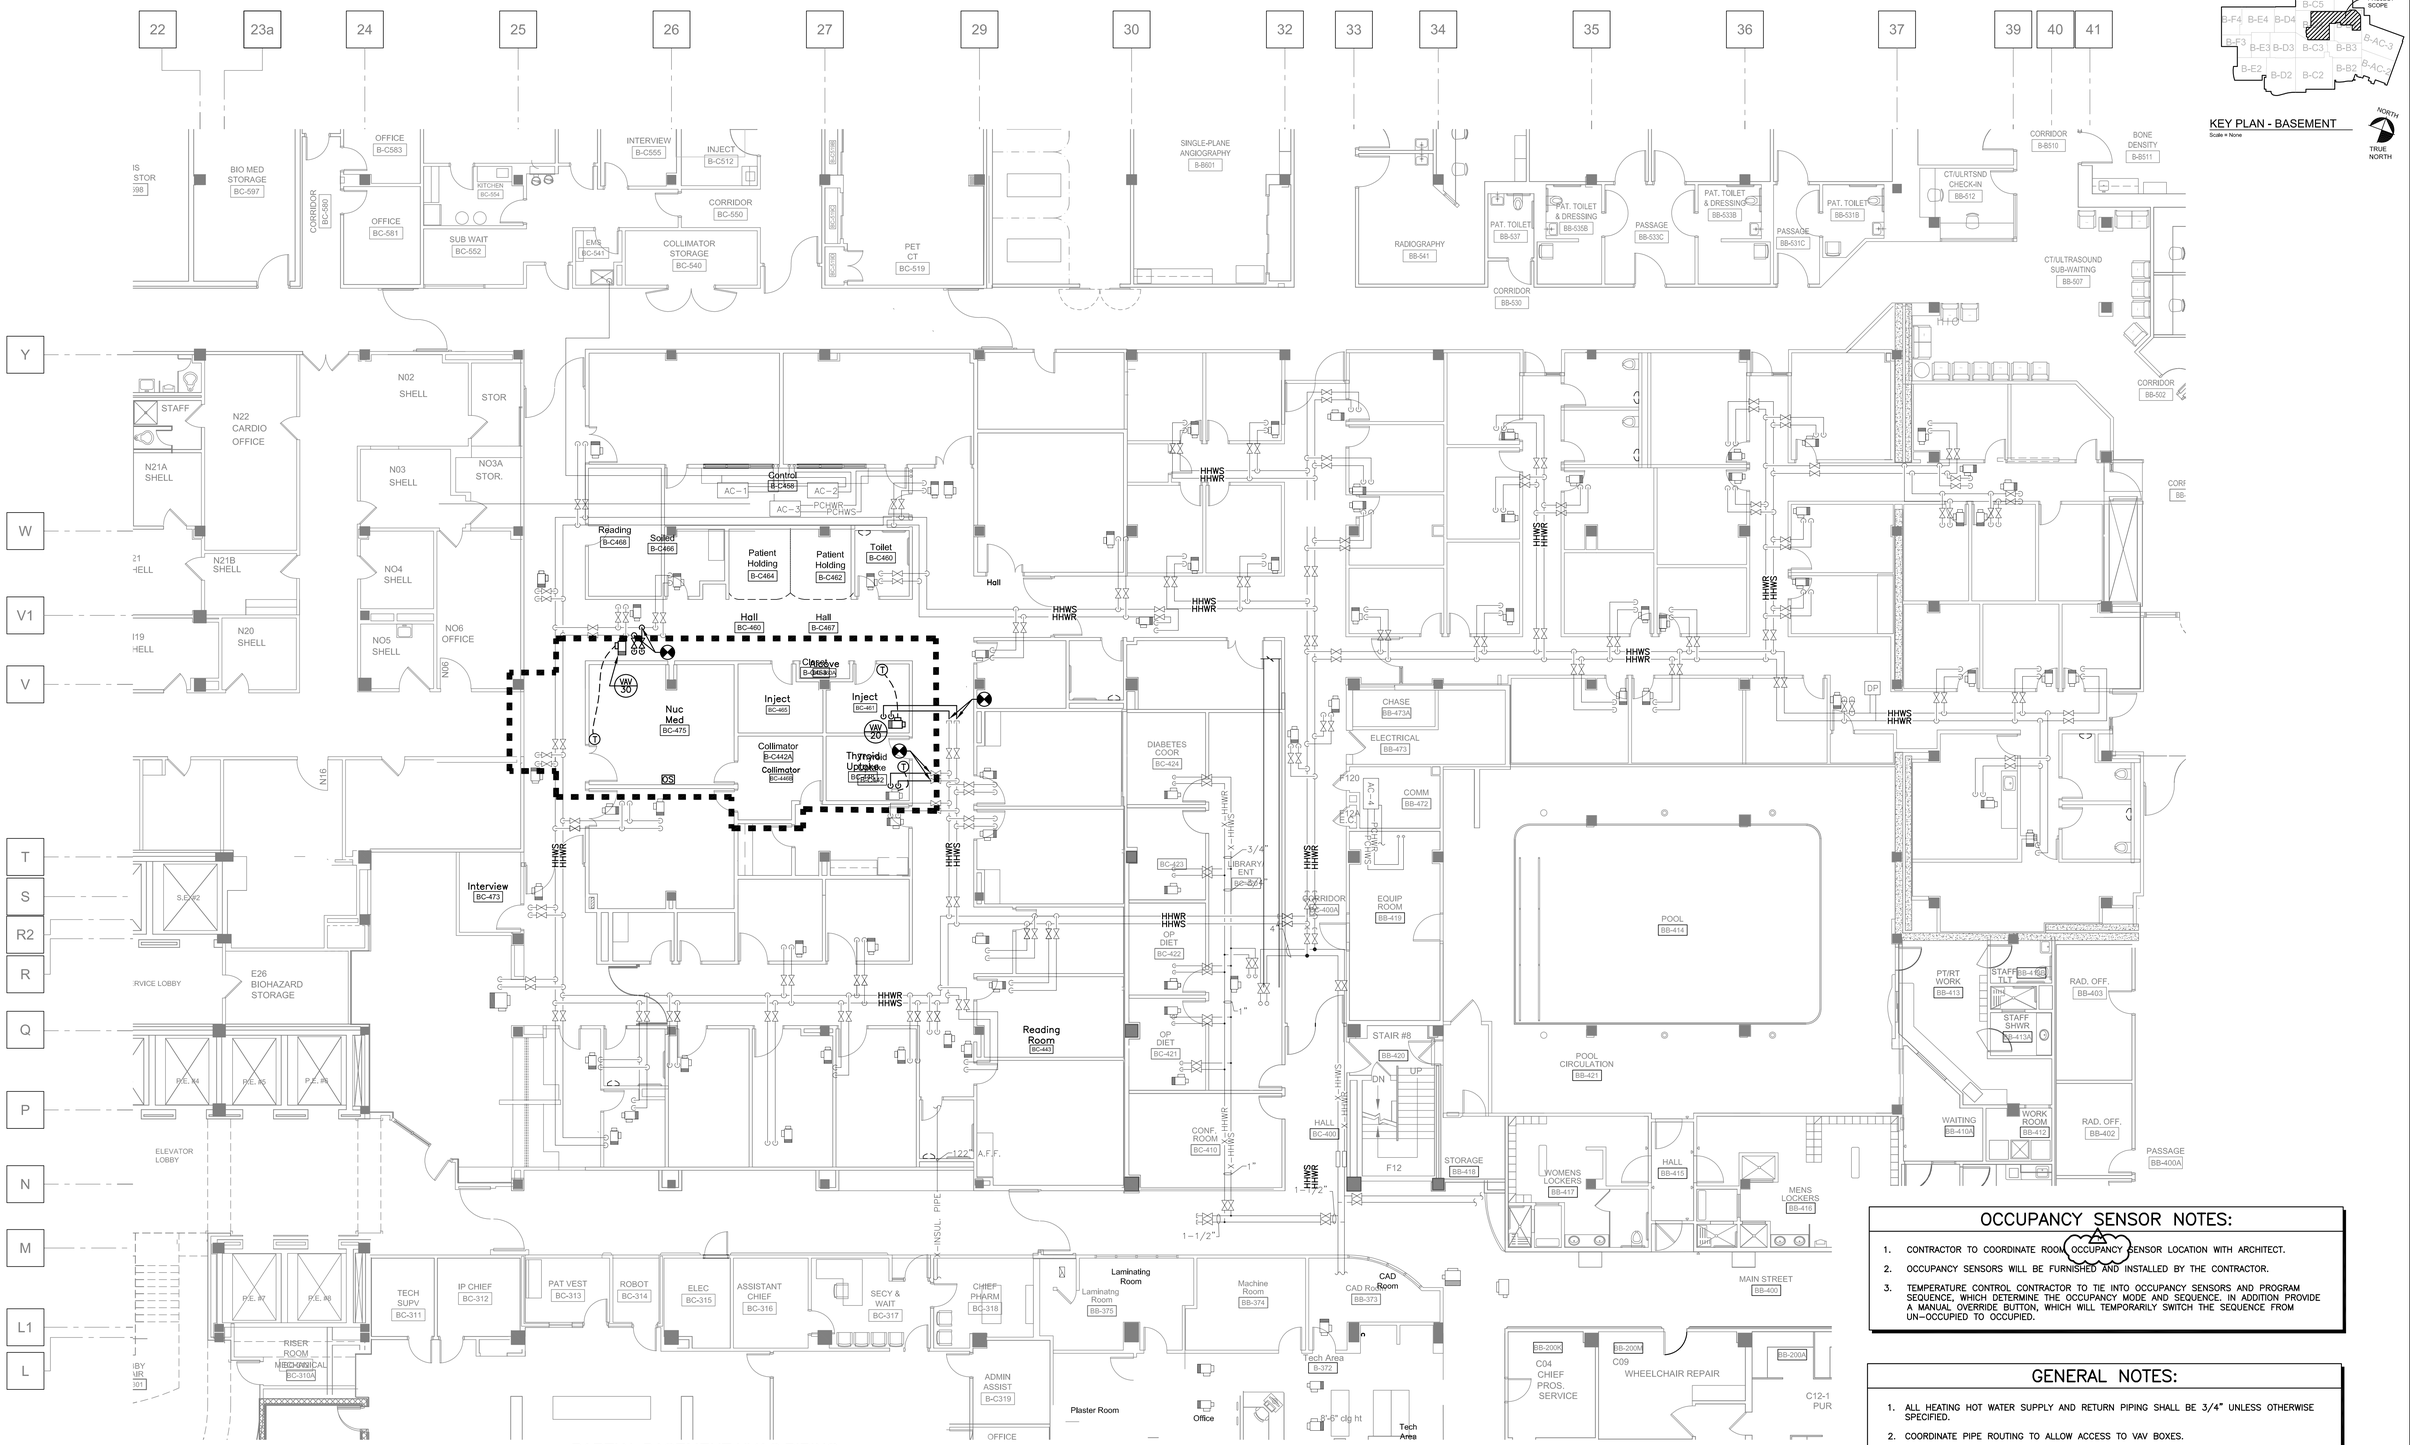

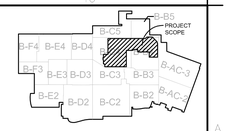

KEY PLAN - BASEMENT

Scale = None

PARTIAL BASEMENT HVAC PIPING PLAN - PHASE 4

1

SCALE: 1/8" = 1'0"

0' 4' 8' 16' 32'

OCCUPANCY SENSOR NOTES:

1. CONTRACTOR TO COORDINATE ROOM OCCUPANCY SENSOR LOCATION WITH ARCHITECT.
2. OCCUPANCY SENSORS WILL BE FURNISHED AND INSTALLED BY THE CONTRACTOR.
3. TEMPERATURE CONTROL CONTRACTOR TO TIE INTO OCCUPANCY SENSORS AND PROGRAM SEQUENCE, WHICH DETERMINE THE OCCUPANCY MODE AND SEQUENCE. IN ADDITION PROVIDE A MANUAL OVERRIDE BUTTON, WHICH WILL TEMPORARILY SWITCH THE SEQUENCE FROM UN-OCCUPIED TO OCCUPIED.

GENERAL NOTES:

1. ALL HEATING HOT WATER SUPPLY AND RETURN PIPING SHALL BE 3/4" UNLESS OTHERWISE SPECIFIED.
2. COORDINATE PIPE ROUTING TO ALLOW ACCESS TO VAV BOXES.
3. VAV BOX VAV-26 IS COOLING ONLY AND DOES NOT RECEIVE REHEAT PIPING.
4. DO NOT ROUTE PIPING ABOVE ELECTRICAL PANELS.

FULLY SPRINKLERED

Amendment 02	09/12/14
Bid Issue	01/17/14
Revisions:	**Date**

CONSULTANTS:

FREDRICK, FREDRICK & HELLER ENGINEERS, INC.
672 EAST ROYALTON ROAD
BROADVIEW HTS., OHIO 44147
TEL. (440) 546-9696
FAX: (440) 546-9699

2217 East 9th Street, Suite 350
Cleveland OH 44115-1257
216-875-0100/ (F) 216-875-0111
barberhoffman.com
BARBER & HOFFMAN, INC.
Consulting Engineers

FFH #13027

ARCHITECT:

Perspectus architecture
13212 Shaker Square Suite 204 Cleveland, Ohio 44120
P. 216.752.1800 F.216.752.3833

DESIGN AND CONSTRUCTION DOCUMENTS AS INSTRUMENTS OF SERVICE ARE GIVEN IN CONFIDENCE AND REMAIN THE PROPERTY OF PERSPECTUS ARCHITECTURE. THE USE OF THIS DESIGN AND THESE CONSTRUCTION DOCUMENTS FOR PURPOSES OTHER THAN THE SPECIFIC PROJECT NAMED HEREIN IS STRICTLY PROHIBITED WITHOUT THE EXPRESSED WRITTEN CONSENT OF PERSPECTUS ARCHITECTURE.

Drawing Title: **PARTIAL BASEMENT HVAC PIPING PLAN - PHASE 4**

Approved: Project Director

Project Title: **EXPAND AND RENOVATE NUCLEAR MEDICINE AND RADIOLOGY**

Location: **VAMC - WADE PARK**

Date: 1-17-2014 | Checked: BMW | Drawn: DAD

Project Number: 541-14-101

Building Number: 1

Drawing Number: **1-H5.4**

Dwg. of

Office of Facilities Management

Department of Veterans Affairs

VA FORM 08-6231, OCT 1978