AREA BB PORTION OF PROJECT
TOILET ACCESSORIES SCHEDULE

ROOM NUMBER	ROOM NAME	ACCESORIES													
PROVIDED BY		CON	VA	CON	CON	CON	VA	CON	CON	CON	CON	CON	CON	CON	CON
INSTALLED BY		CON	VA	CON	CON	CON	VA	CON	CON	CON	CON	CON	CON	CON	CON
		PAPER TOWEL DISPENSER (PTD-1)	SOAP DISPENSER (SD-1)	ROBE HOOK (RH-1)	FRAMED MIRROR 18"x36" (FM-1)	FRAMED MIRROR 24"x48" (FM-2)	HAND SANITIZER (HS-1) PROVIDED & INSTALLED BY OWNER	TOILET TISSUE DISPENSER (TTD-1)	GRAB BAR 36" (GB-36)	GRAB BAR 42" (GB-42)	GRAB BAR 18" (GB-18)	PAPER TOWEL DISPENSER (PTD-2)	SANITARY NAPKIN DISPOSAL (SND-1)	TOILET SEAT COVER DISPENSER (TSCD-1)
BB-426	OFFICE														
BB-427	OFFICE														
BB-428	OFFICE														
BB-429	OFFICE														
BB-431	OFFICE														
BB-432	OFFICE														
BB-433	OFFICE														
BB-435	TOILET (MEN)	1	1	1	1		1	1	1	1	1				1
BB-436	TOILET (WOMEN)	1	1	1	1		1	1	1	1	1			1	1
BB-437	LOCKERS					1									
BB-438	STAFF LOUNGE		1				1					1			
BB-441	OFFICE														
BB-442	OFFICE														
BB-443	OFFICE														
BB-444	OFFICE														
BB-445	OFFICE														
BB-451	OFFICE														
BB-452	OFFICE														
BB-453	OFFICE														
BB-454	OFFICE														
BB-456	OFFICE														
BB-457	OFFICE														
BB-458	OFFICE														
BB-459	OFFICE														
BB-461	OFFICE														
BB-462	OFFICE														
BB-463	TOILET (STAFF)	1	1	1	1		1	1	1	1	1				1
BB-464	TOILET (STAFF)	1	1	1	1		1	1	1	1	1				1
BB-465	OFFICE														
BB-466	OFFICE														
BB-467	OFFICE														
BB-468	OFFICE														
BB-481	OFFICE														
BB-482	OFFICE														
BB-483	OFFICE														

TOILET ACCESSORIES SCHEDULE NOTES:
- SEE SPEC SECTION 10 28 00 - FOR INFORMATION ON SCHEDULED ITEMS.
- PROVIDE BLOCKING AS REQUIRED PER MANUFACTURERS INSTRUCTION FOR ALL ITEMS. COORDINATE WITH COTR.
- MOUNT ROBE HOOK ON ROOM SIDE OF DOOR CENTERED HORIZONTALLY.
- SEE FLOOR PLAN FOR LOCATIONS OF MULTIPLE ROBE HOOKS.
- MOUNT FM-2 ON BACK OF DOOR IN LOCKERS BB-437.

AREA BC
TOILET ACCESSORIES SCHEDULE

ROOM NUMBER	ROOM NAME	ACCESORIES													
PROVIDED BY		CON	VA	CON	CON	VA	CON	CON	VA	VA	VA	VA	CON	CON	CON	CON
INSTALLED BY		CON	VA	CON	CON	VA	CON	CON	CON	VA	VA	VA	CON	CON	CON	CON
		PAPER TOWEL DISPENSER (PTD-1)	SOAP DISPENSER (SD-1)	ROBE HOOK (RH-1)	FRAMED MIRROR 18"x36" (FM-1)	HAND SANITIZER (HS-1)	TOILET TISSUE DISPENSER (TTD-1)	GRAB BARS (GB-36, GB-42 GB-18)	CURTAIN ROD AND TRACK	GLOVE DISPENSER AND DISPOSAL	COMBO GLOVE/ CAP/ SHOE/ FACE MASK DISPENSER AND DISPOSAL	SHARPS NEEDLE DISPOSAL	TOILET SEAT COVER DISPENSER (TSCD-1)	PAPER TOWEL DISPENSER (PTD-2)	FRAMED MIRROR 24" X 48" (FM-2)	SANITARY NAPKIN DISPOSAL (SND-1)
BC-431	SOILED		1	1		1					1			1		
BC-432	STORAGE			1												
BC-433	ECHO		1	1	1	1			1	1	1	1		1		
BC-434	EKG		1	1	1	1			1	1	1	1		1		
BC-435	ECHO		1	1	1	1			1	1	1	1		1		
BC-436	EKG		1	1	1	1			1	1	1	1		1		
BC-437	ECHO		1	1	1	1			1	1	1	1		1		
BC-441	STAFF TOILET	1	1	1	1	1	1	1					1			
BC-442	CARDIOLOGY TECH		1			1								1		
BC-443	READING ROOM															
BC-444	OFFICE															
BC-445	ECHO STRESS		1	1	1	1			1	1	1	1		1	1	
BC-446	HOT LAB		1	1		1				1	1	1		1		
BC-446A	RAD WASTE			1						1	1					
BC-447	ECHO STRESS		1	1	1	1			1	1	1	1		1	1	
BC-448	THYROID UPTAKE		1	1	1	1			1	1	1	1		1		
BC-449	HOLTER		1	1	1	1			1	1				1		
BC-451	STAFF TOILET	1	1	1	1	1	1	1					1			
BC-452	NUC MED		1	1	1	1			1	1	1	1		1		
BC-453	NUC MED CT		1	1	1	1			1	1	1	1		1		
BC-462	TOILET	1	1	1	1	1	1	1					1			
BC-461	INJECT		1	1	1	1			1	1	1	1		1		
BC-463	PATIENT HOLDING					1			1	1	1	1				
BC-464	PATIENT HOLDING					1			1	1	1	1				
BC-465	INJECT		1	1	1	1			1	1	1	1		1		
BC-466	SOILED		1	1		1					1			1		
BC-467	READING															
BC-468	NUC MED CT		1	1	1	1			1	1	1	1		1		
BC-473	INTERVIEW			1												
BC-472	TOILET	1	1	1	1	1	1	1					1			
BC-474	NUC MED		1	1	1	1			1	1	1	1		1		
BC-475	NUC MED		1	1	1	1			1	1	1	1		1		

TOILET ACCESSORIES SCHEDULE NOTES:
1. SEE SPEC SECTION 10 28 00 - FOR INFORMATION ON SCHEDULED ITEMS.
2. PROVIDE BLOCKING AS REQUIRED PER MANUFACTURERS INSTRUCTION FOR ALL ITEMS. COORDINATE WITH COTR.

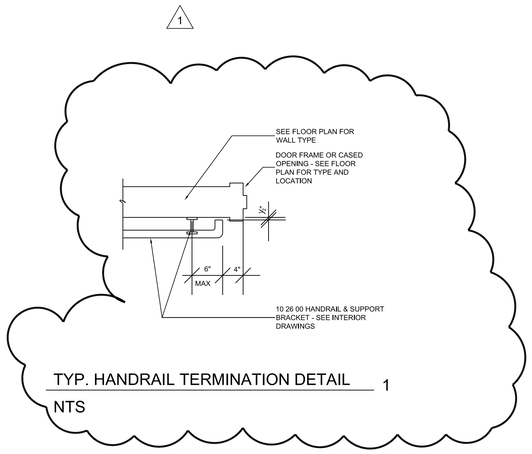

TYP. HANDRAIL TERMINATION DETAIL 1

NTS

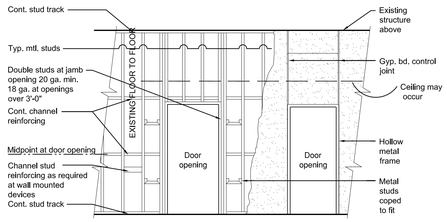

TYPICAL GYP. BOARD DETAIL 0

0 2' 4' 8'
1/4" = 1'-0"

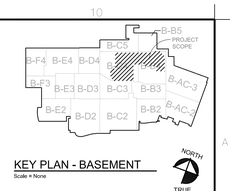

KEY PLAN - BASEMENT
Scale = None

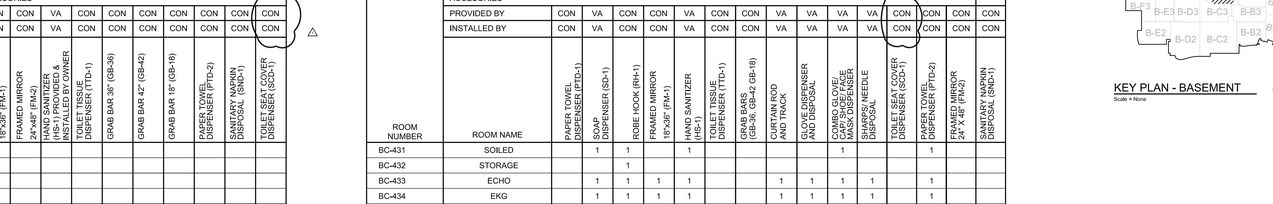

STANDARD MOUNTING HEIGHTS

0 2' 4' 8'
1/4" = 1'-0" TYPICAL ACCESSORY ITEMS. SOME ITEMS MAY NOT OCCUR IN PROJECT

ABBREVIATIONS

ab	anchor bolt
a/c	air conditioning
acous	acoustic(al)
act	acoustical ceiling tile
adj	adjacent
aff	above finish floor
alt	alternate
alum	aluminum
anod	anodized
approx	approximate
arch	architect(ural)
auto	automatic
bd	board
betw	between
bldg	building
blk	block(ing)
blkhd	bulkhead
bm	beam
bot	bottom
brdg	bridging
brg	bearing
brk	brick
bsmt	basement
bur	built-up roofing
c/c	center to center
cab't	cabinet
cad	cadmium
cb	catch basin
cem	cement
c.l. or ℄	center line
cfm	cubic feet per minute
cg	corner guard
ci	cast iron
cj	control joint
clg	ceiling
cl	closet
clr	clear
cll	contract limit line
cntr	counter
cmu	concrete masonry unit
co	cased opening/clean out
col	column
conc	concrete
conn	connection
const	construction
cont	continuous
coord	coordinate
corr	corridor
cs	course
cr	crash rail
ctr	center
d	depth
db	door bell
dbl	double
deg	degrees
demo	demolition
dia	diameter
dim	dimension
disp	dispenser
dn	down
dr	door
ds	down spout
det	detail
dwg	drawing
dwr	drawer
dw	drywall
ea	each
ec	electrical contractor
eifs	exterior insulation and finish system
ej	expansion joint
elec	electric
elev	elevator/elevation
emerg	emergency
eq	equal
equip	equipment
etr	existing to remain
ew	each way
ewc	electric water cooler
exh	exhaust
exist	existing
exp	expansion
exp'd	exposed
ext	exterior
fa	fire alarm
fb	face brick
fcu	fan coil unit
ftf	face to face
fd	floor drain
fdn	foundation
fe	fire extinguisher
fec	fire extinguisher cabinet
fhc	fire hose cabinet
fin	finish
flr	floor
fluor	fluorescent
fr	fire resistant
frt	fire-retardant treated
frtwd	fire-retardant treated wood
ft	feet
ftg	footing
furr	furring
fvc	fire valve cabinet
ga	gauge
galv	galvanized
gc	general contractor
gl	glass
gr	grade
gwb	gypsum board
h	high
hb	hose bibb
hbgpt	high build glazed coating
hc	hollow core
hdbd	hardboard
hdcpd	handicapped
hdwr	hardware
hdwd	hardwood
hm	hollow metal
hortz	horizontal
hpdl	high pressure decorative laminate
hr	hour
ht	height
htg	heating
htr	heater
hvac	heating, ventilation air conditioning
hw	hot water
hwh	hot water heater
id	inside diameter
in	inch
incl	include (inclusive)
insul	insulation
int	interior
jan	janitor
jst	joist
kd	knock down
ko	knock out
l	length (long)
lam	laminate(d)
lav	lavatory
lb	pound
lf	linear feet (foot)
lim	limited
lt	light
ltg	lighting
lvr	louver
marb	marble
mas	masonry
mat	material
max	maximum
mech	mechanical
memb	membrane
mfr	manufacturer
mh	manhole
min	minimum
misc	miscellaneous
mo	masonry opening
mtd	mounted
mtl	metal
mull	mullion
n/a	not applicable
nic	not in contract
no	number
nom	nominal
nts	not to scale
oa	overall
oc	on center
ocaff	on center above finish floor
od	outside diameter
ohdr	overhead door
oph	opposite hand
ovrd	overflow roof drain
o/o	out to out
op'g	opening
opp	opposite
opt	optional
pbd	particle board
pcf	pounds per cubic foot
perim	perimeter
pg bd	peg board
pl	plate
plas	plastic
plam	plastic laminate
plbg	plumbing
pmbf	premoulded
pnl	panel
plywd	plywood
polsh	polished
pr	pair
prefin	prefinished
prefab	prefabricated
proj	projection
psc	pre-stress concrete
psf	pounds per square foot
psi	pounds per square inch
pt	point
ptd	painted
ptn	partition
pvc	polyvinylchloride
pvmt	pavement
qt	quarry tile
qty	quantity
r	riser
ra	return air
rad	radius
rag	return air grille
rd	roof drain
rec	receptacle
ref	refrigerator
reg	register
reinf	reinforcement (reinforcing)
req'd	required
res	resilient
ret	return
rev	revised (revision)
rm	room
ro	rough opening
rvs	reverse
sc	solid core
sched	schedule
sd	smoke detector
sdl	saddle
sect	section
sht	sheet
slm	slimline
sp	stand pipe
spec	specifications
spkr	speaker
splkr	sprinkler
spr	single ply roofing
sq	square
sq in	square inch
sy	square yard
ss	stainless steel/ slop sink
std	standard
stl	steel
stor	storage
struc	structure(al)
susp	suspended
sys	systems
t	thread
t/g or t&g	tongue and groove
td	trench drain
tel	telephone
temp	temporary
temp'd	tempered
terr	terrazzo
thk	thick
thld	threshold
toc	top of concrete (top of curb)
tos	top of steel
tod	top of deck
tom	top of masonry
toj	top of joist
top	top of parapet
tow	top of wall
typ	typical
uc	undercut
ug	underground
unfin	unfinished
unlim	unlimited
uno	unless noted otherwise
ur	urinal
vert	vertical
vest	vestibule
vif	verify in field
w	width
w/	with
w/o	without
w/w	wall to wall
wc	water closet
wd	wood
wh	water heater
win	window
wg	wire glass
wt	weight
wp	wall protection
wwf	welded wire fabric
yd	yard

SYMBOLS

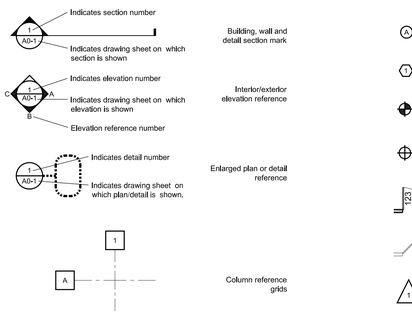

FULLY SPRINKLERED

Revisions:	Date
Amendment 02	09/12/14
Bid Issue	01/17/14

CONSULTANTS:

FREDRICK, FREDRICK & HELLER ENGINEERS, INC.
672 EAST ROYALTON ROAD
BROADVIEW HTS., OHIO 44147
TEL. (440) 546-9696
FAX: (440) 546-9699

BARBER & HOFFMAN, INC.
Consulting Engineers
2217 East 9th Street, Suite 350
Cleveland OH 44115-1257
216-875-0100/ (F) 216-875-0111
barberhoffman.com

STATE OF OHIO
WILLIAM C. AYARS
7259
REGISTERED ARCHITECT

ARCHITECT:

Perspectus architecture
13212 Shaker Square Suite 204 Cleveland, Ohio 44120
P. 216.752.1800 F.216.752.3833

DESIGN AND CONSTRUCTION DOCUMENTS AS INSTRUMENTS OF SERVICE ARE GIVEN IN CONFIDENCE AND REMAIN THE PROPERTY OF PERSPECTUS ARCHITECTURE. THE USE OF THIS DESIGN AND THESE CONSTRUCTION DOCUMENTS ON ANY OTHER PROJECT OR WITH THE SPECIFIC PROJECT NAMED HEREIN IS STRICTLY PROHIBITED WITHOUT THE EXPRESSED WRITTEN CONSENT OF PERSPECTUS ARCHITECTURE.

Drawing Title
SYMBOLS, ABBREVIATIONS, SCHEDULES & MISC DETAILS

Approved: Project Director

Project Title
EXPAND AND RENOVATE NUCLEAR MEDICINE AND RADIOLOGY

Location
VAMC - WADE PARK

Date 1-17-2014 | Checked **RN** | Drawn **PRM**

Project Number 541-14-101

Building Number 1

Drawing Number **1-00.1**

Dwg. of

Office of Facilities Management

Department of Veterans Affairs

VA FORM 08-6231, OCT 1978