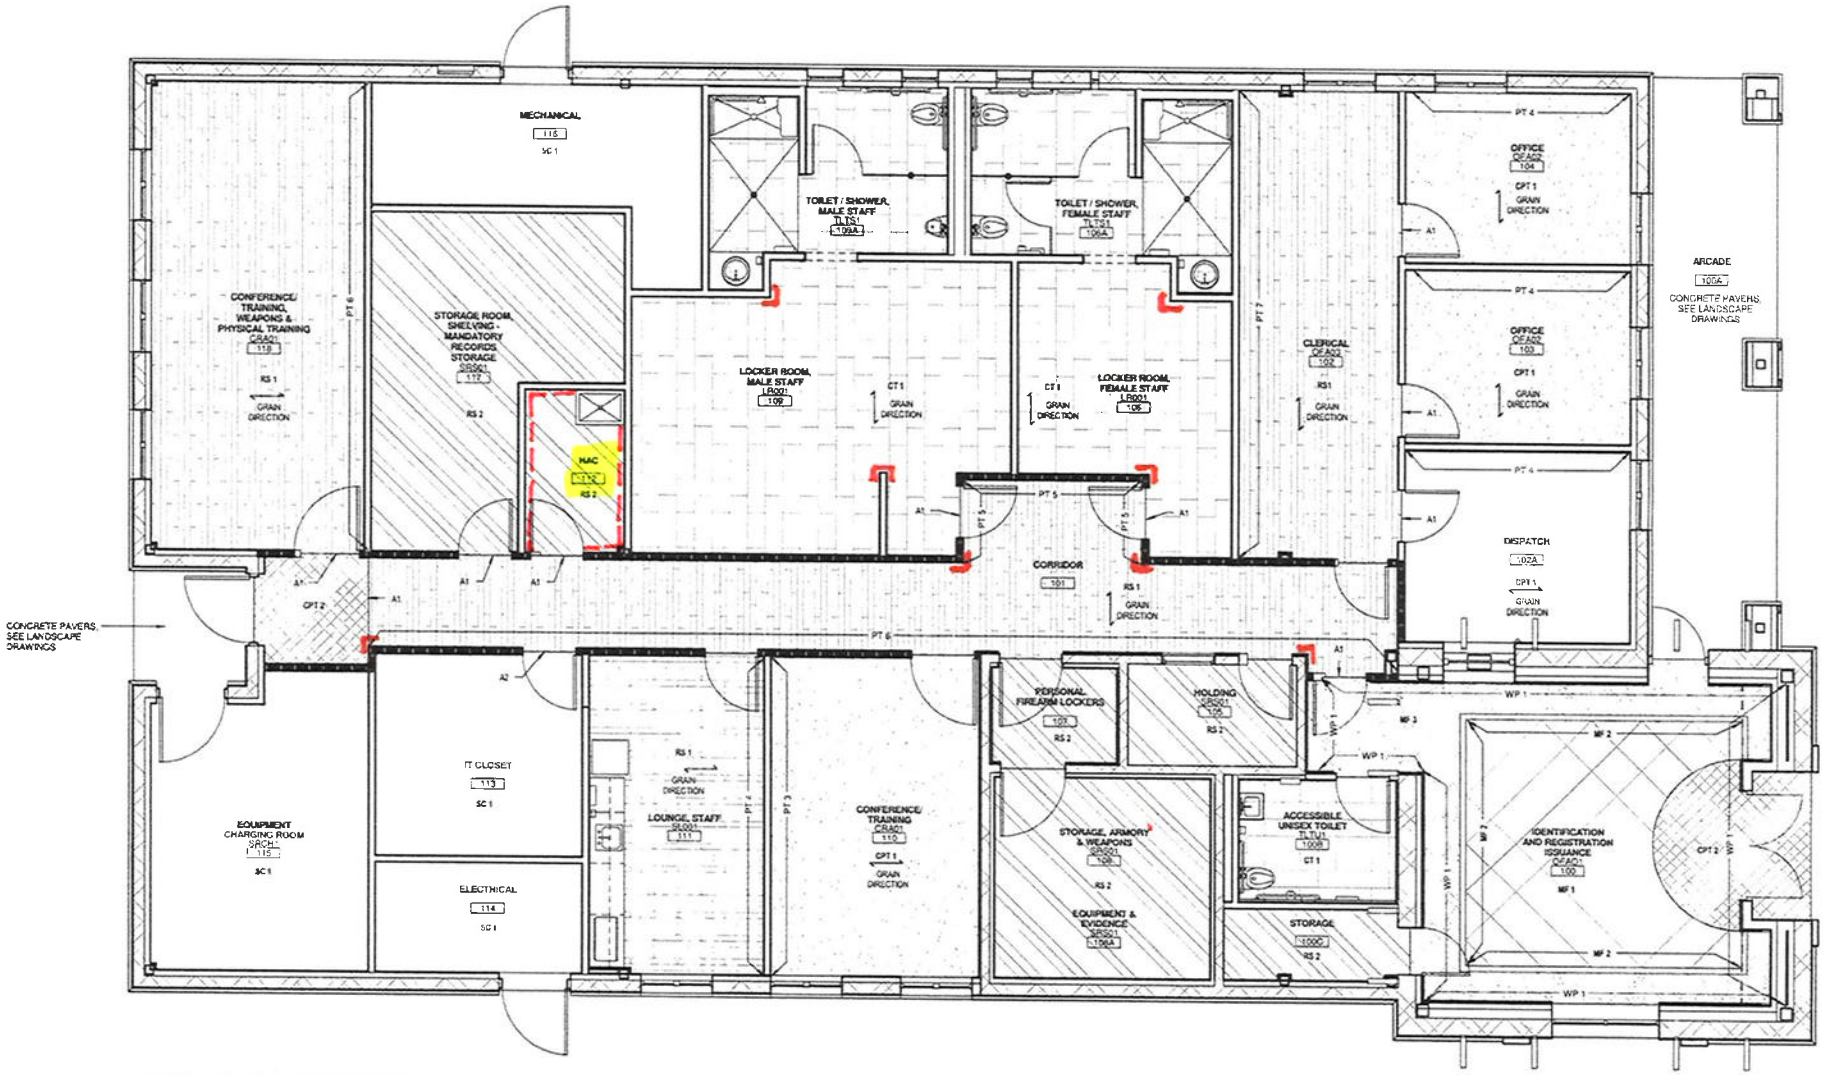

FINISH PLAN - BASE BID

1/4" = 1'-0"

Corner Guard Location

--- Impact resistant material

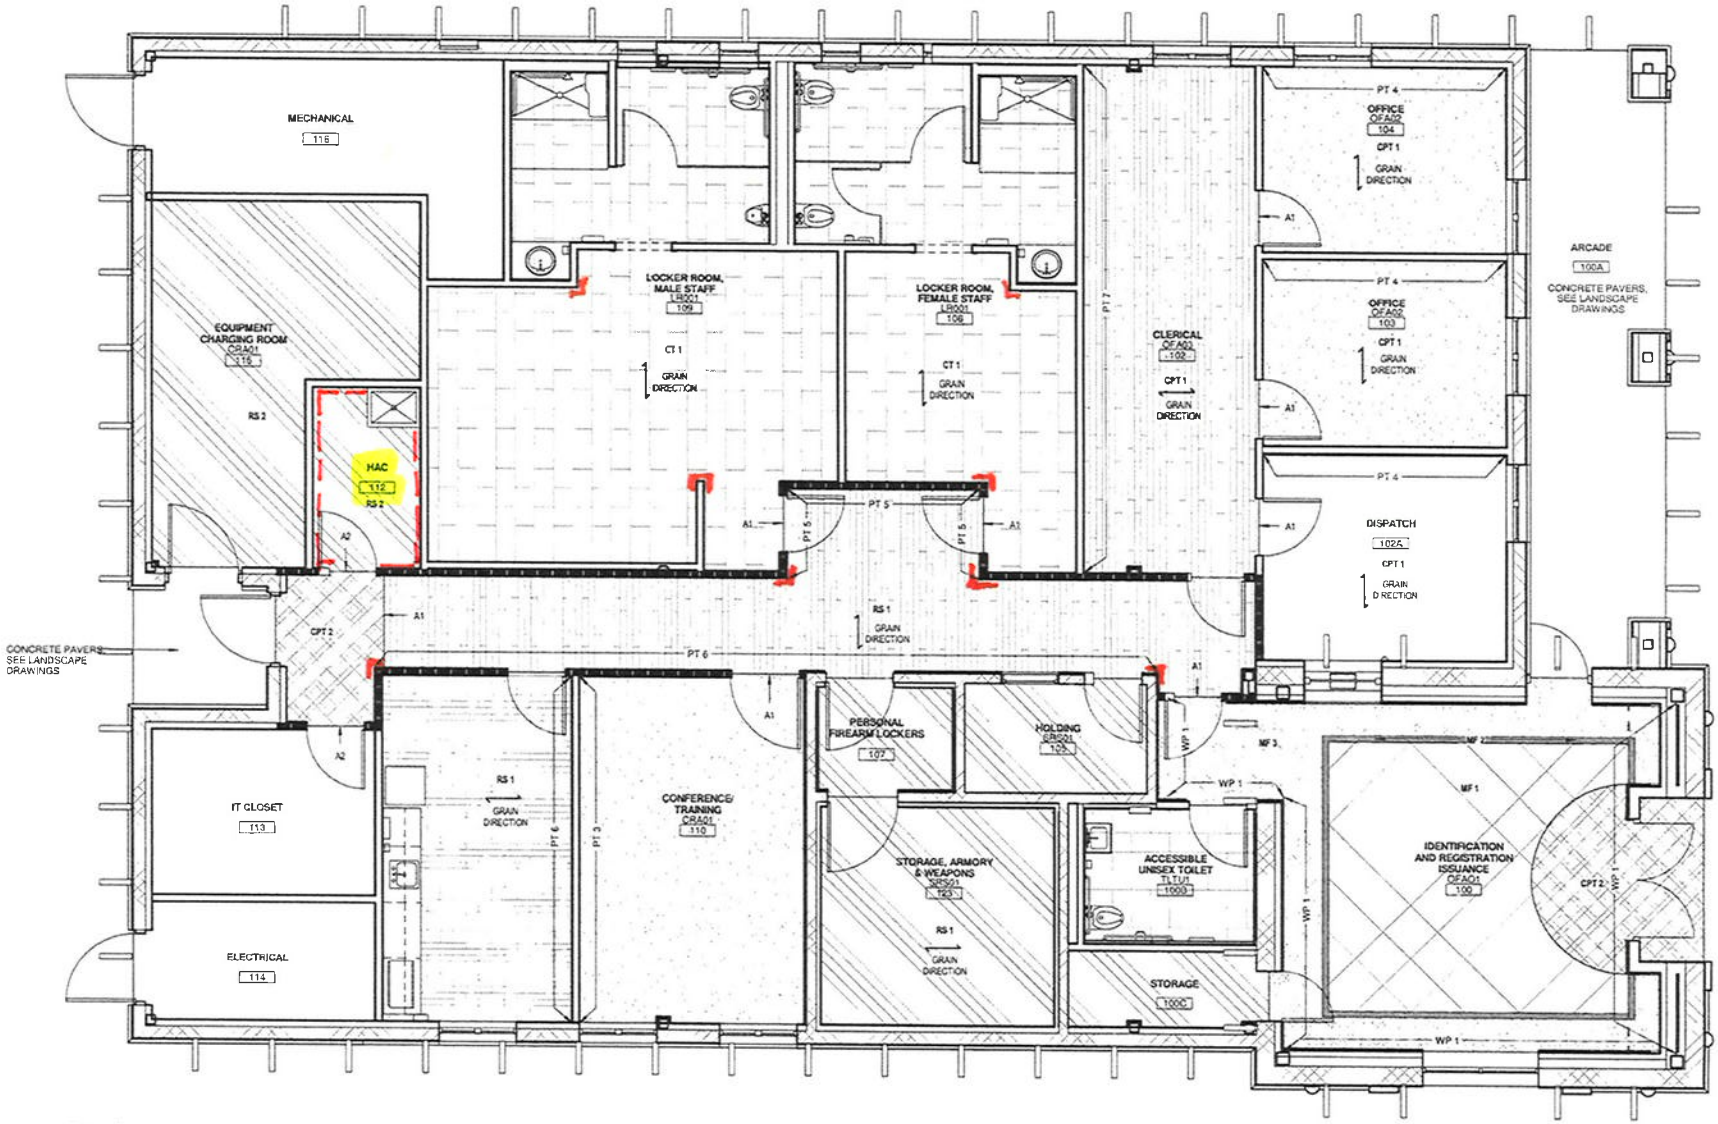

FINISH PLAN - DEDUCTIVE ALTERNATE #10

1/4" = 1'-0"

Corner guard location

Impact Resistant materials