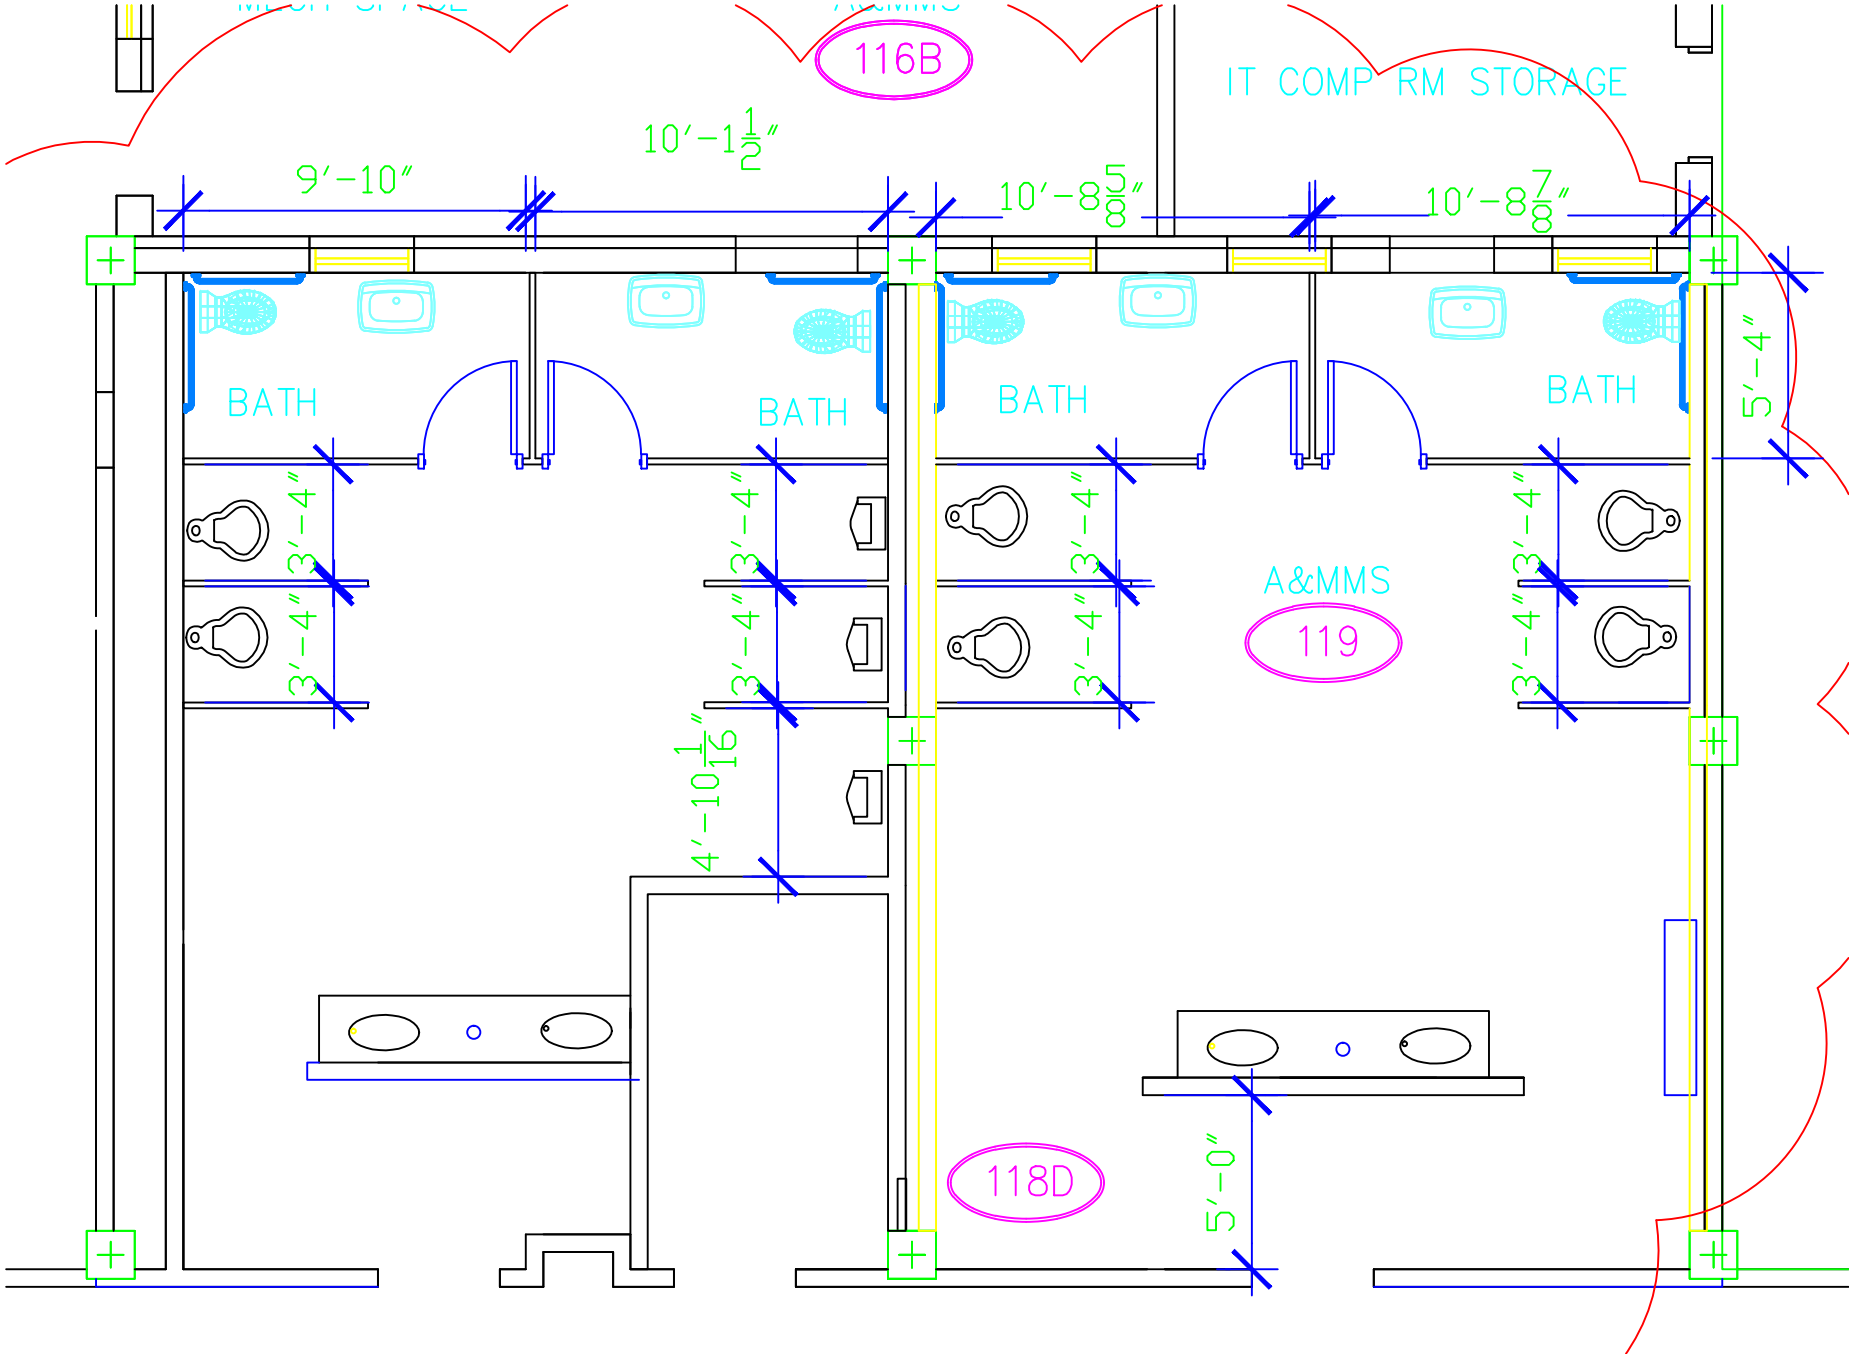
116B
IT COMP RM STORAGE
10′-1 1/2″
9′-10″
10′-8 5/8″
10′-8 7/8″
BATH
BATH
BATH
BATH
5′-4″
3′-4″
3′-4″
3′-4″
3′-4″
3′-4″
3′-4″
3′-4″
3′-4″
A&MMS
119
4′-10 1/16″
118D
5′-0″