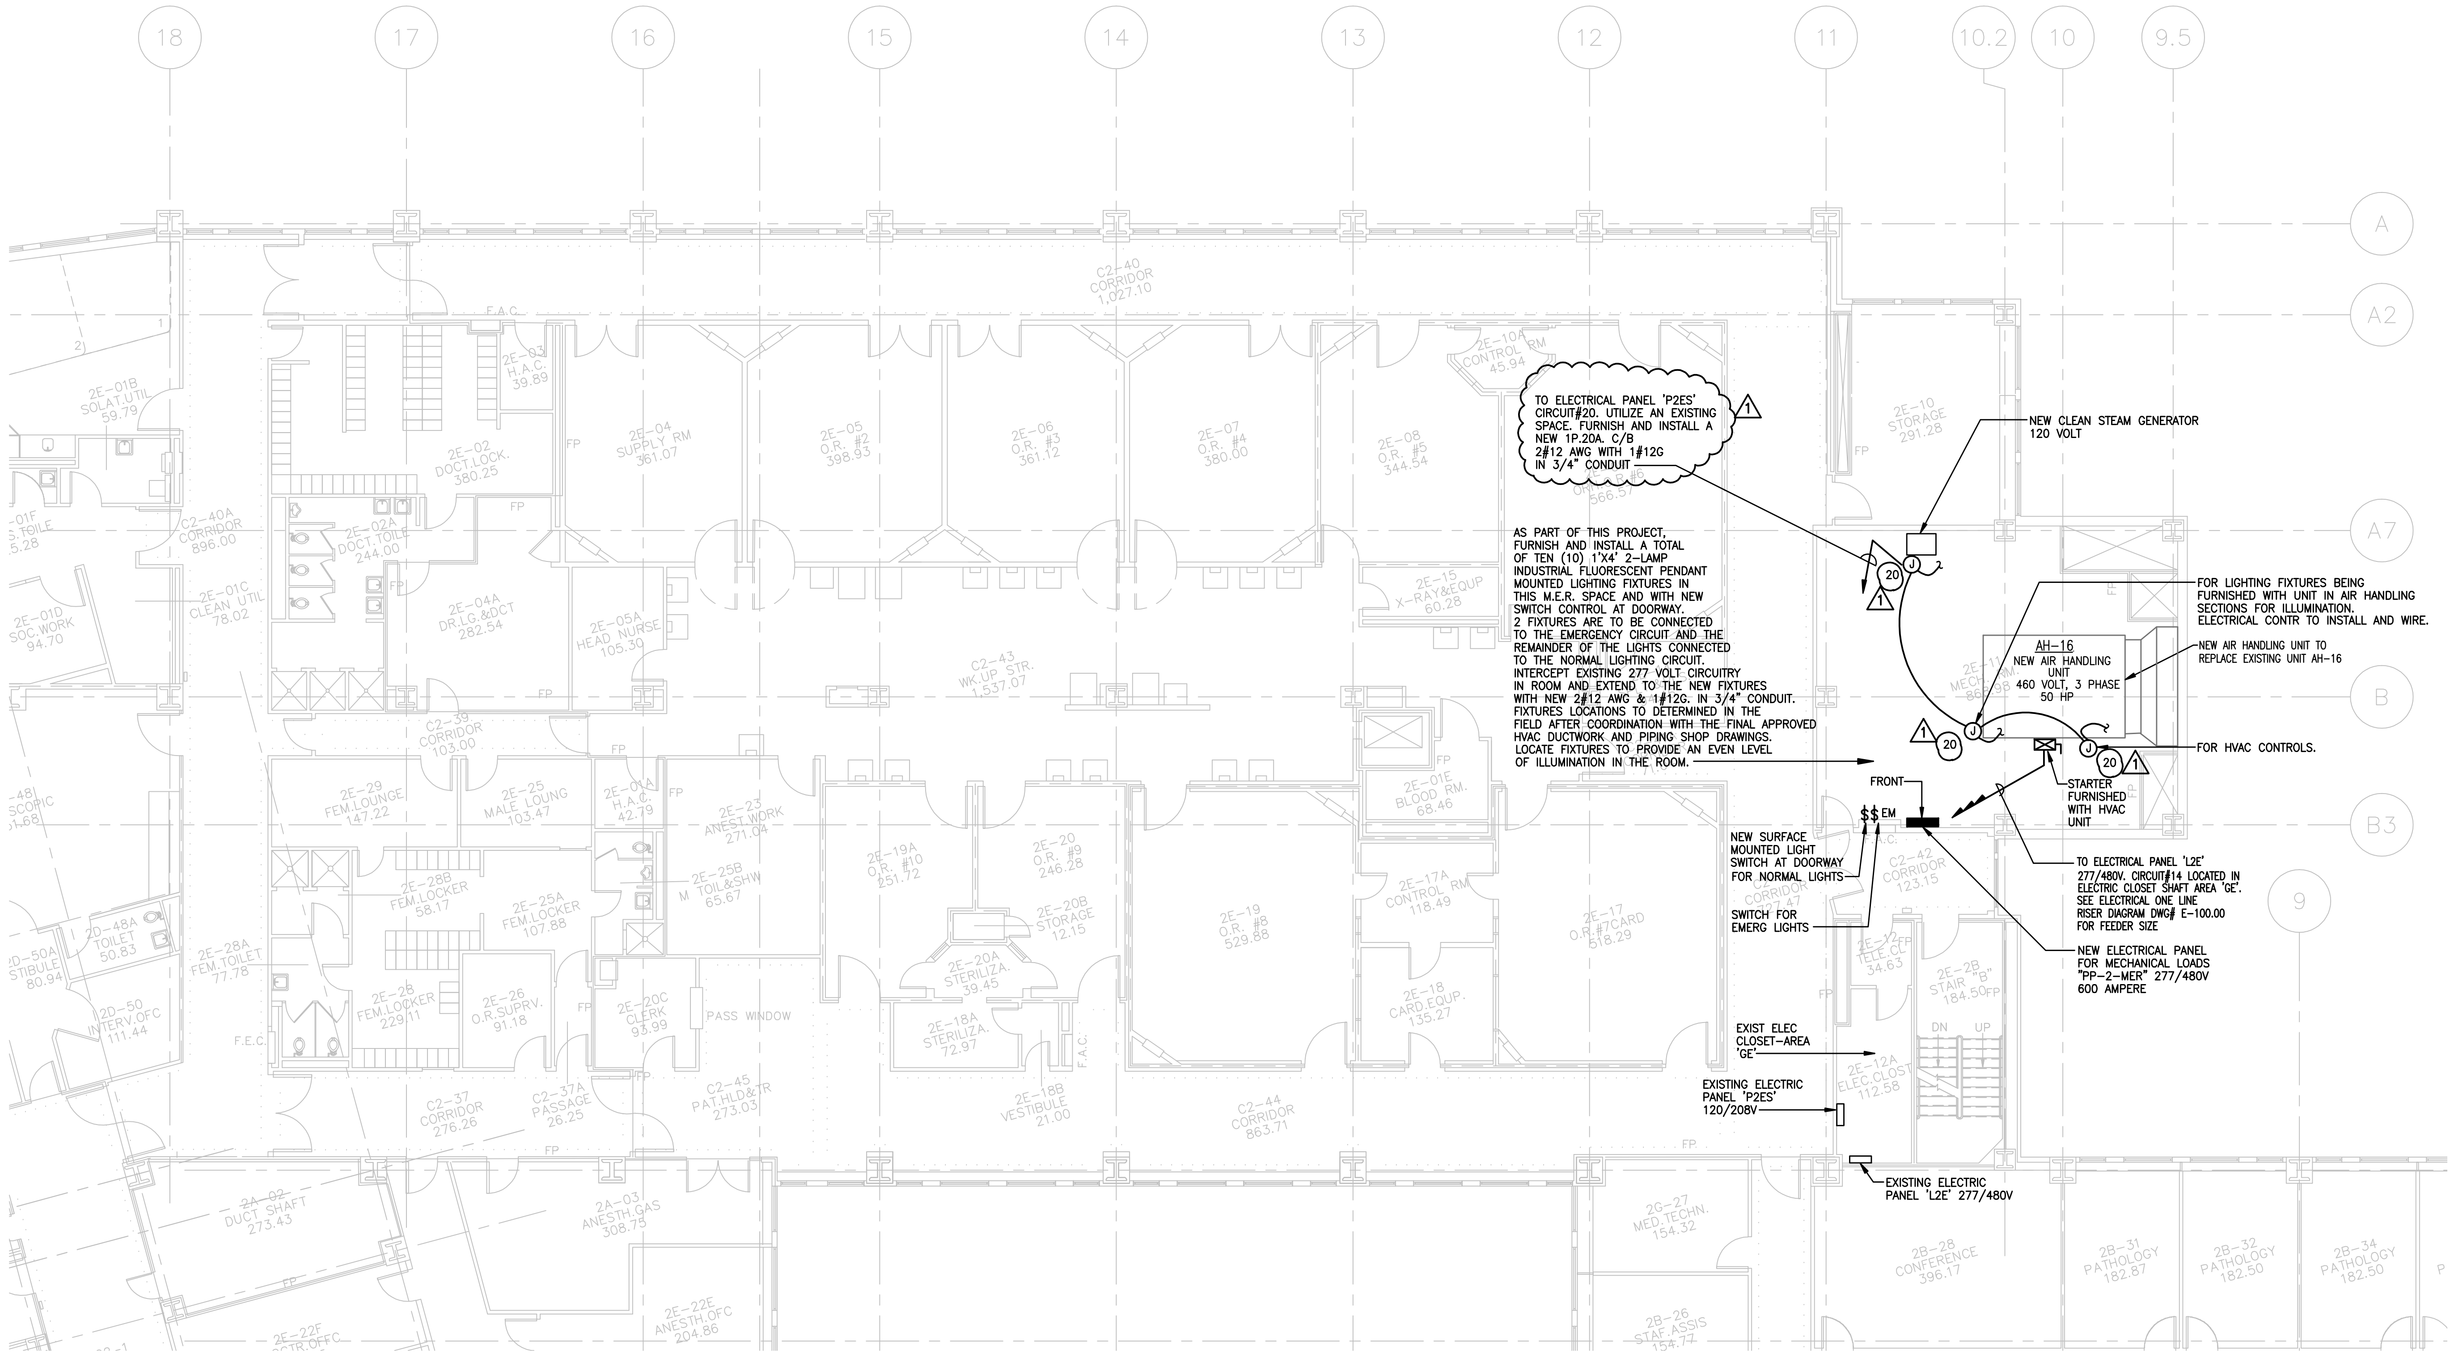

1 2ND FLOOR ELECTRICAL PART PLAN

Scale: 1/8" = 1'-0"

GENERAL ELECTRICAL CONSTRUCTION NOTE:

CONTRACTOR SHALL VERIFY ALL CONDITIONS IN THE FIELD PRIOR TO SUBMISSION OF PRICES AND START OF CONSTRUCTION. ALL DISCREPANCIES AS PER THESE DRAWINGS WITH ACTUAL FIELD CONDITIONS THAT SHALL INTERFERE WITH THE COMPLETION OF WORK AS INDICATED ON THESE DRAWING SHALL BE IMMEDIATELY REPORTED TO THE CONSTRUCTION MANAGER, PROJECT MANAGER, AND ENGINEER.

Revisions:	Date:
REVISION NO. 1 △1	12/02/2009
ISSUED FOR CONSTRUCTION	03/31/2009
50% DESIGN DEVELOPMENT	02/27/2009
SCHEMATIC DESIGN	11/21/2008

12/12/03 03:30 PM

Pennoni
Engineering & Surveying of New York P.C.
29 West 35th Street
8th Floor
New York, NY 10001

KEY PLAN:

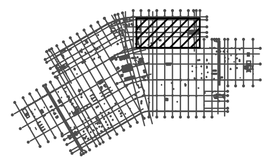

DRAWING TITLE: SECOND FLOOR- ELECTRICAL NEW WORK PART PLAN

APPROVED: DIVISION CHIEF

APPROVED: SERVICE DIRECTOR

PROJECT TITLE: V.A.H. BRONX, N.Y. SECOND FLOOR SECTOR E AH-16 REPLACEMENT BUILDING 100

BUILDING NUMBER: 100

CHECKED BY: KD

DRAWN BY: RM

LOCATION: BRONX, NEW YORK

SCALE: 1/8" = 1'-0"

DATE: 10/14/2008

PROJECT NUMBER: VETS0801

DRAWING NUMBER: E-300.00

DWG. 3 OF 4

Office of Facilities

Department of Veterans Affairs

DWG INFORMATION DIRECTORY: FILENAME PEN MAP JOB NO. XREFS