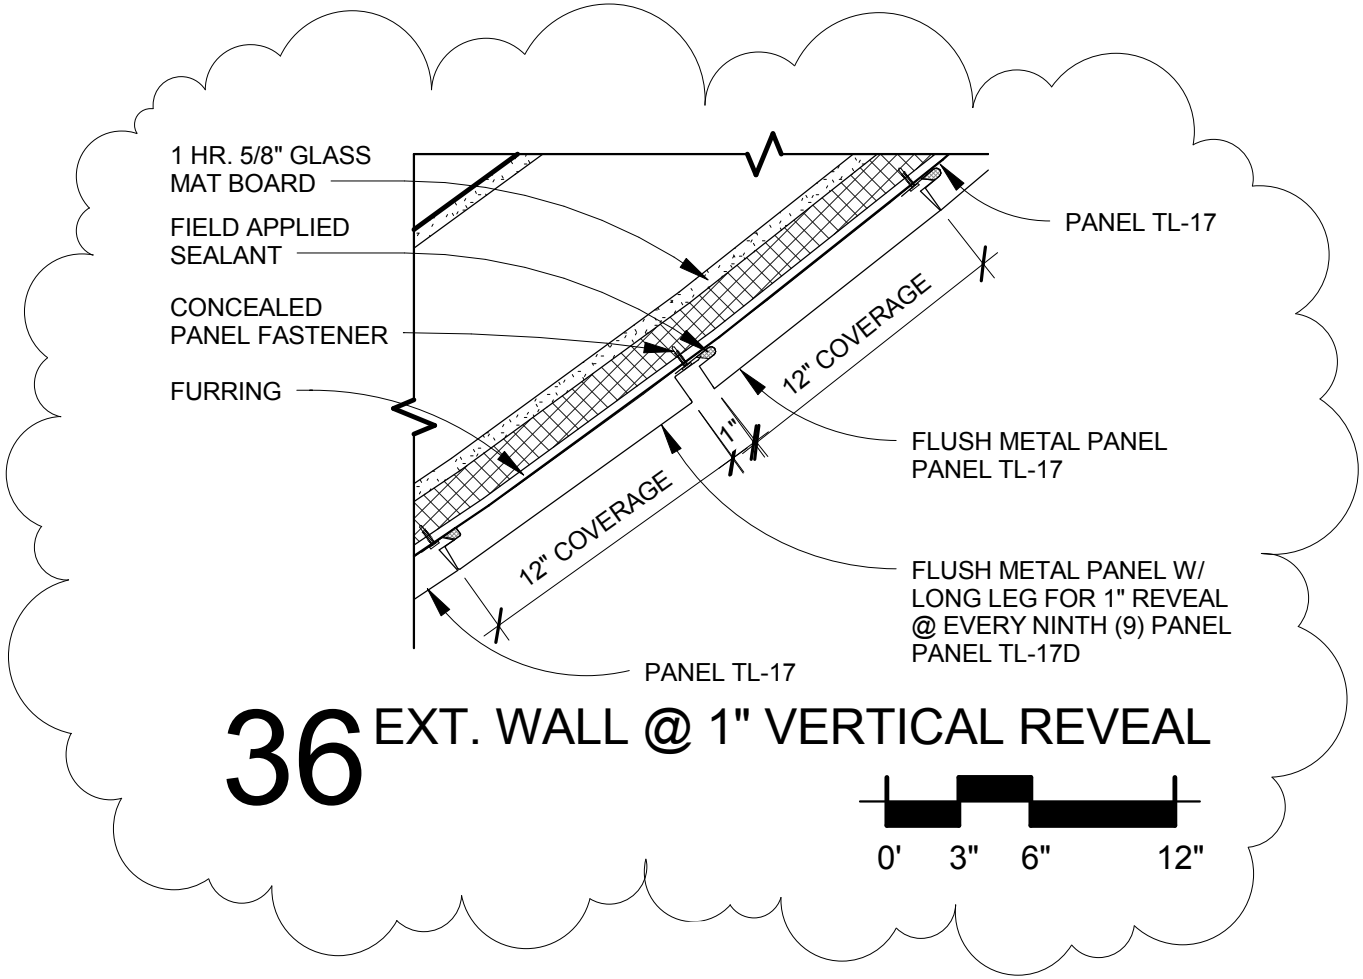

36 EXT. WALL @ 1" VERTICAL REVEAL

REVEAL DETAIL

Project Title: **MEDICAL SPECIALTIES BUILDING 648**	Project Number: **612-122**	Office of Construction and Facilities Management
	Building Number: **648**	
Location: **VA MATHER**	Drawing Number: **A8.11**	
Date: 09/18/2014 · Checked: **M.H.** · Drawn: **HA**	Dwg. **35** of	Department of Veterans Affairs