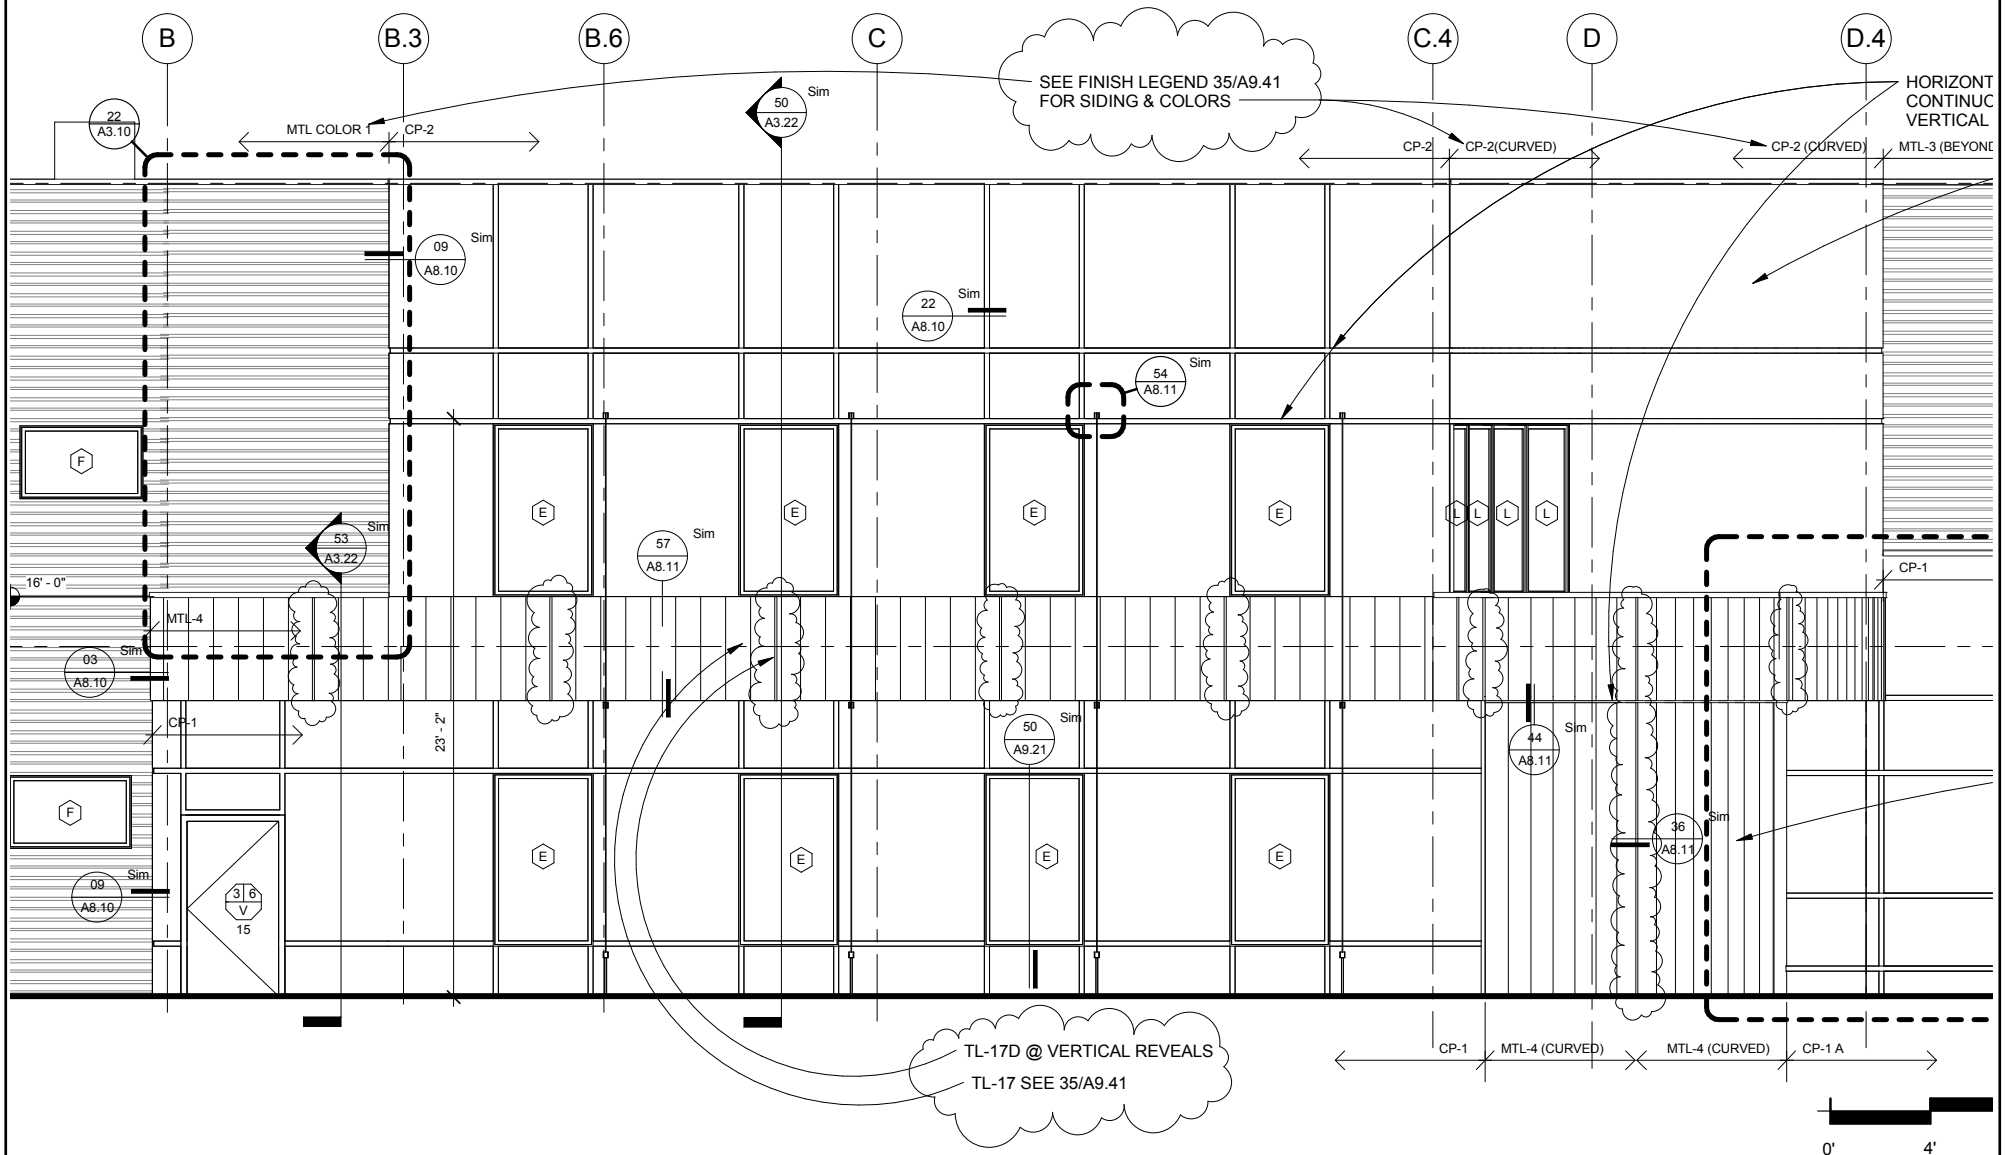

PARTIAL DRAWING

0' 4'

WEST ELEVATION

Project Title: **MEDICAL SPECIALTIES BUILDING 648**	Project Number: **612-122**	Office of Construction and Facilities Management
	Building Number: **648**	
Location: **VA MATHER**	Drawing Number: **A3.10**	
Date: 09/18/2014 · Checked: **M.H.** · Drawn: **P.M.**	Dwg. **11** of	Department of Veterans Affairs