

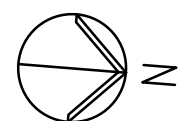


GENERAL FIRE ALARM DEMOLITION PLAN NOTES


- A. REFER TO SHEET F-001 FOR LEGEND, ABBREVIATIONS, AND GENERAL NOTES.
- B. RENOVATION NOTATIONS:
- (RX) REMOVE EXISTING DEVICE OR EQUIPMENT
- (XR) EXISTING DEVICE OR EQUIPMENT TO BE REMOVED AND REPLACED AT SAME LOCATION
- C. FIRE ALARM DEVICES SHOWN SHALL BE DISCONNECTED AND REMOVED, REFER TO NEW DRAWINGS FOR FURTHER INFORMATION.

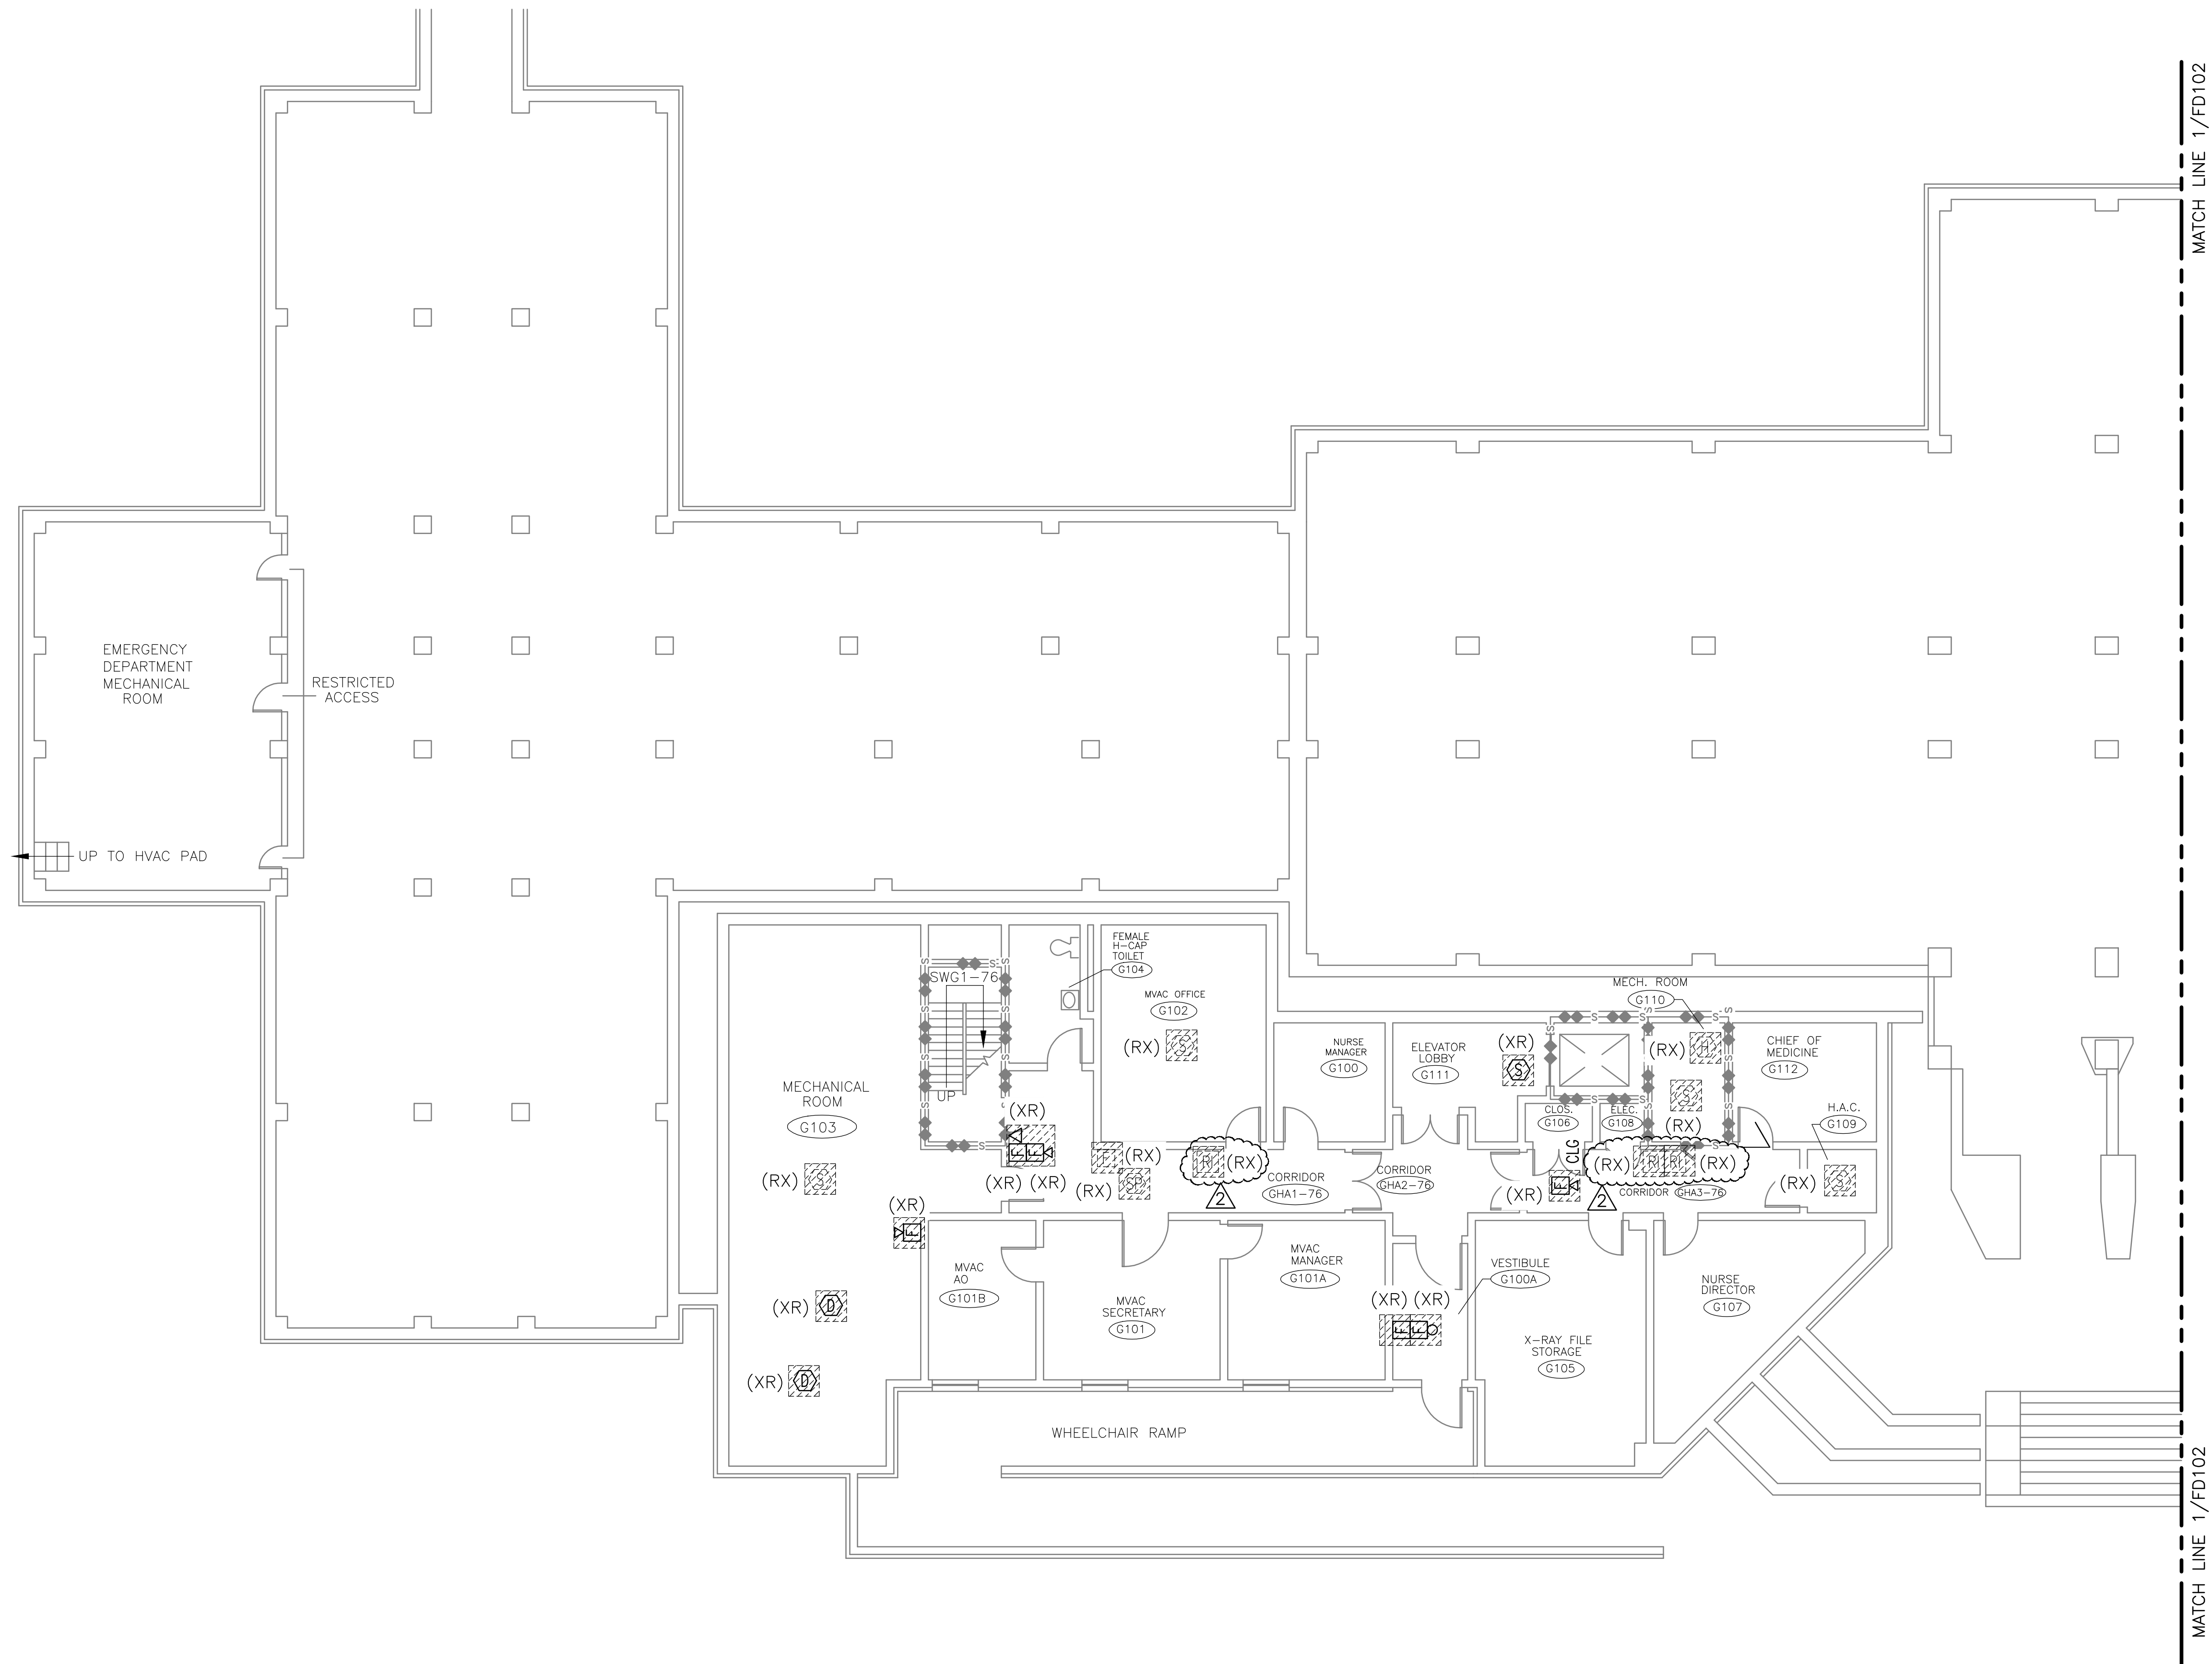

1 PARTIAL FLOOR PLAN
1/8" = 1'-0"

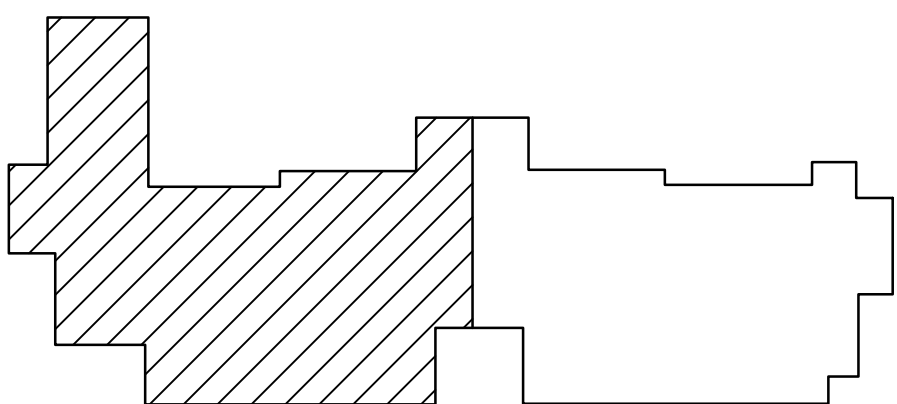

KEY PLAN
NTS

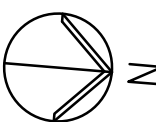

FULLY SPRINKLERED
BID DOCUMENTS

		ARCHITECT/ENGINEERS:		ALL WORK TO BE IN ACCORDANCE WITH N.F.P.A., NATIONAL, STATE AND CITY CODES & O.S.H.A.		Approved: A.F.G.E.	Date	Approved: Fire Chief	Date	Approved: Patient Safety	Date	Drawing Title	Project Title	Date	
				Approved: Logistics Manager.		Approved: Interior Designer	Date	Approved: Safety Officer	Date	Approved: M&R Foreman	Date	FIRE ALARM DEMOLITION / REPLACEMENT GROUND FLOOR SOUTH	UPGRADE FIRE ALARM SYSTEM BUILDING 76	07-21-2014	
				Approved: Infection Control Mgr.		Approved: Info. Sys.	Date	Approved: Industrial Hygienist	Date	Approved: Industrial Hygienist	Date	Approved: Eng. Project Supervisor	Building No. 76	Project No. 528A6-14-601	
				Approved: Chief Security		Approved: Women's Health Rep	Date	Approved: Space Owner	Date	Approved: Associate Director	Date	Approved: Medical Center Director	Checked BAM	Drawn MMF	
														DRAWING NO. VAMC-528A6-0012	
AMENDMENT #2	08/26/2014													FD101	
AMENDMENT #1	08/14/2014													Dwg. 3 of 33	
Revisions	Date														

200 Envoy Circle #201, Louisville KY 40299 ~ PH: 502.339.8511 ~ www.paradigmusa.com