


A. REFER TO SHEET F-001 FOR LEGEND, ABBREVIATIONS, AND GENERAL NOTES.

B. RENOVATION NOTATIONS:

(RX) REMOVE EXISTING DEVICE OR EQUIPMENT

(XR) EXISTING DEVICE OR EQUIPMENT TO BE REMOVED AND REPLACED AT SAME LOCATION

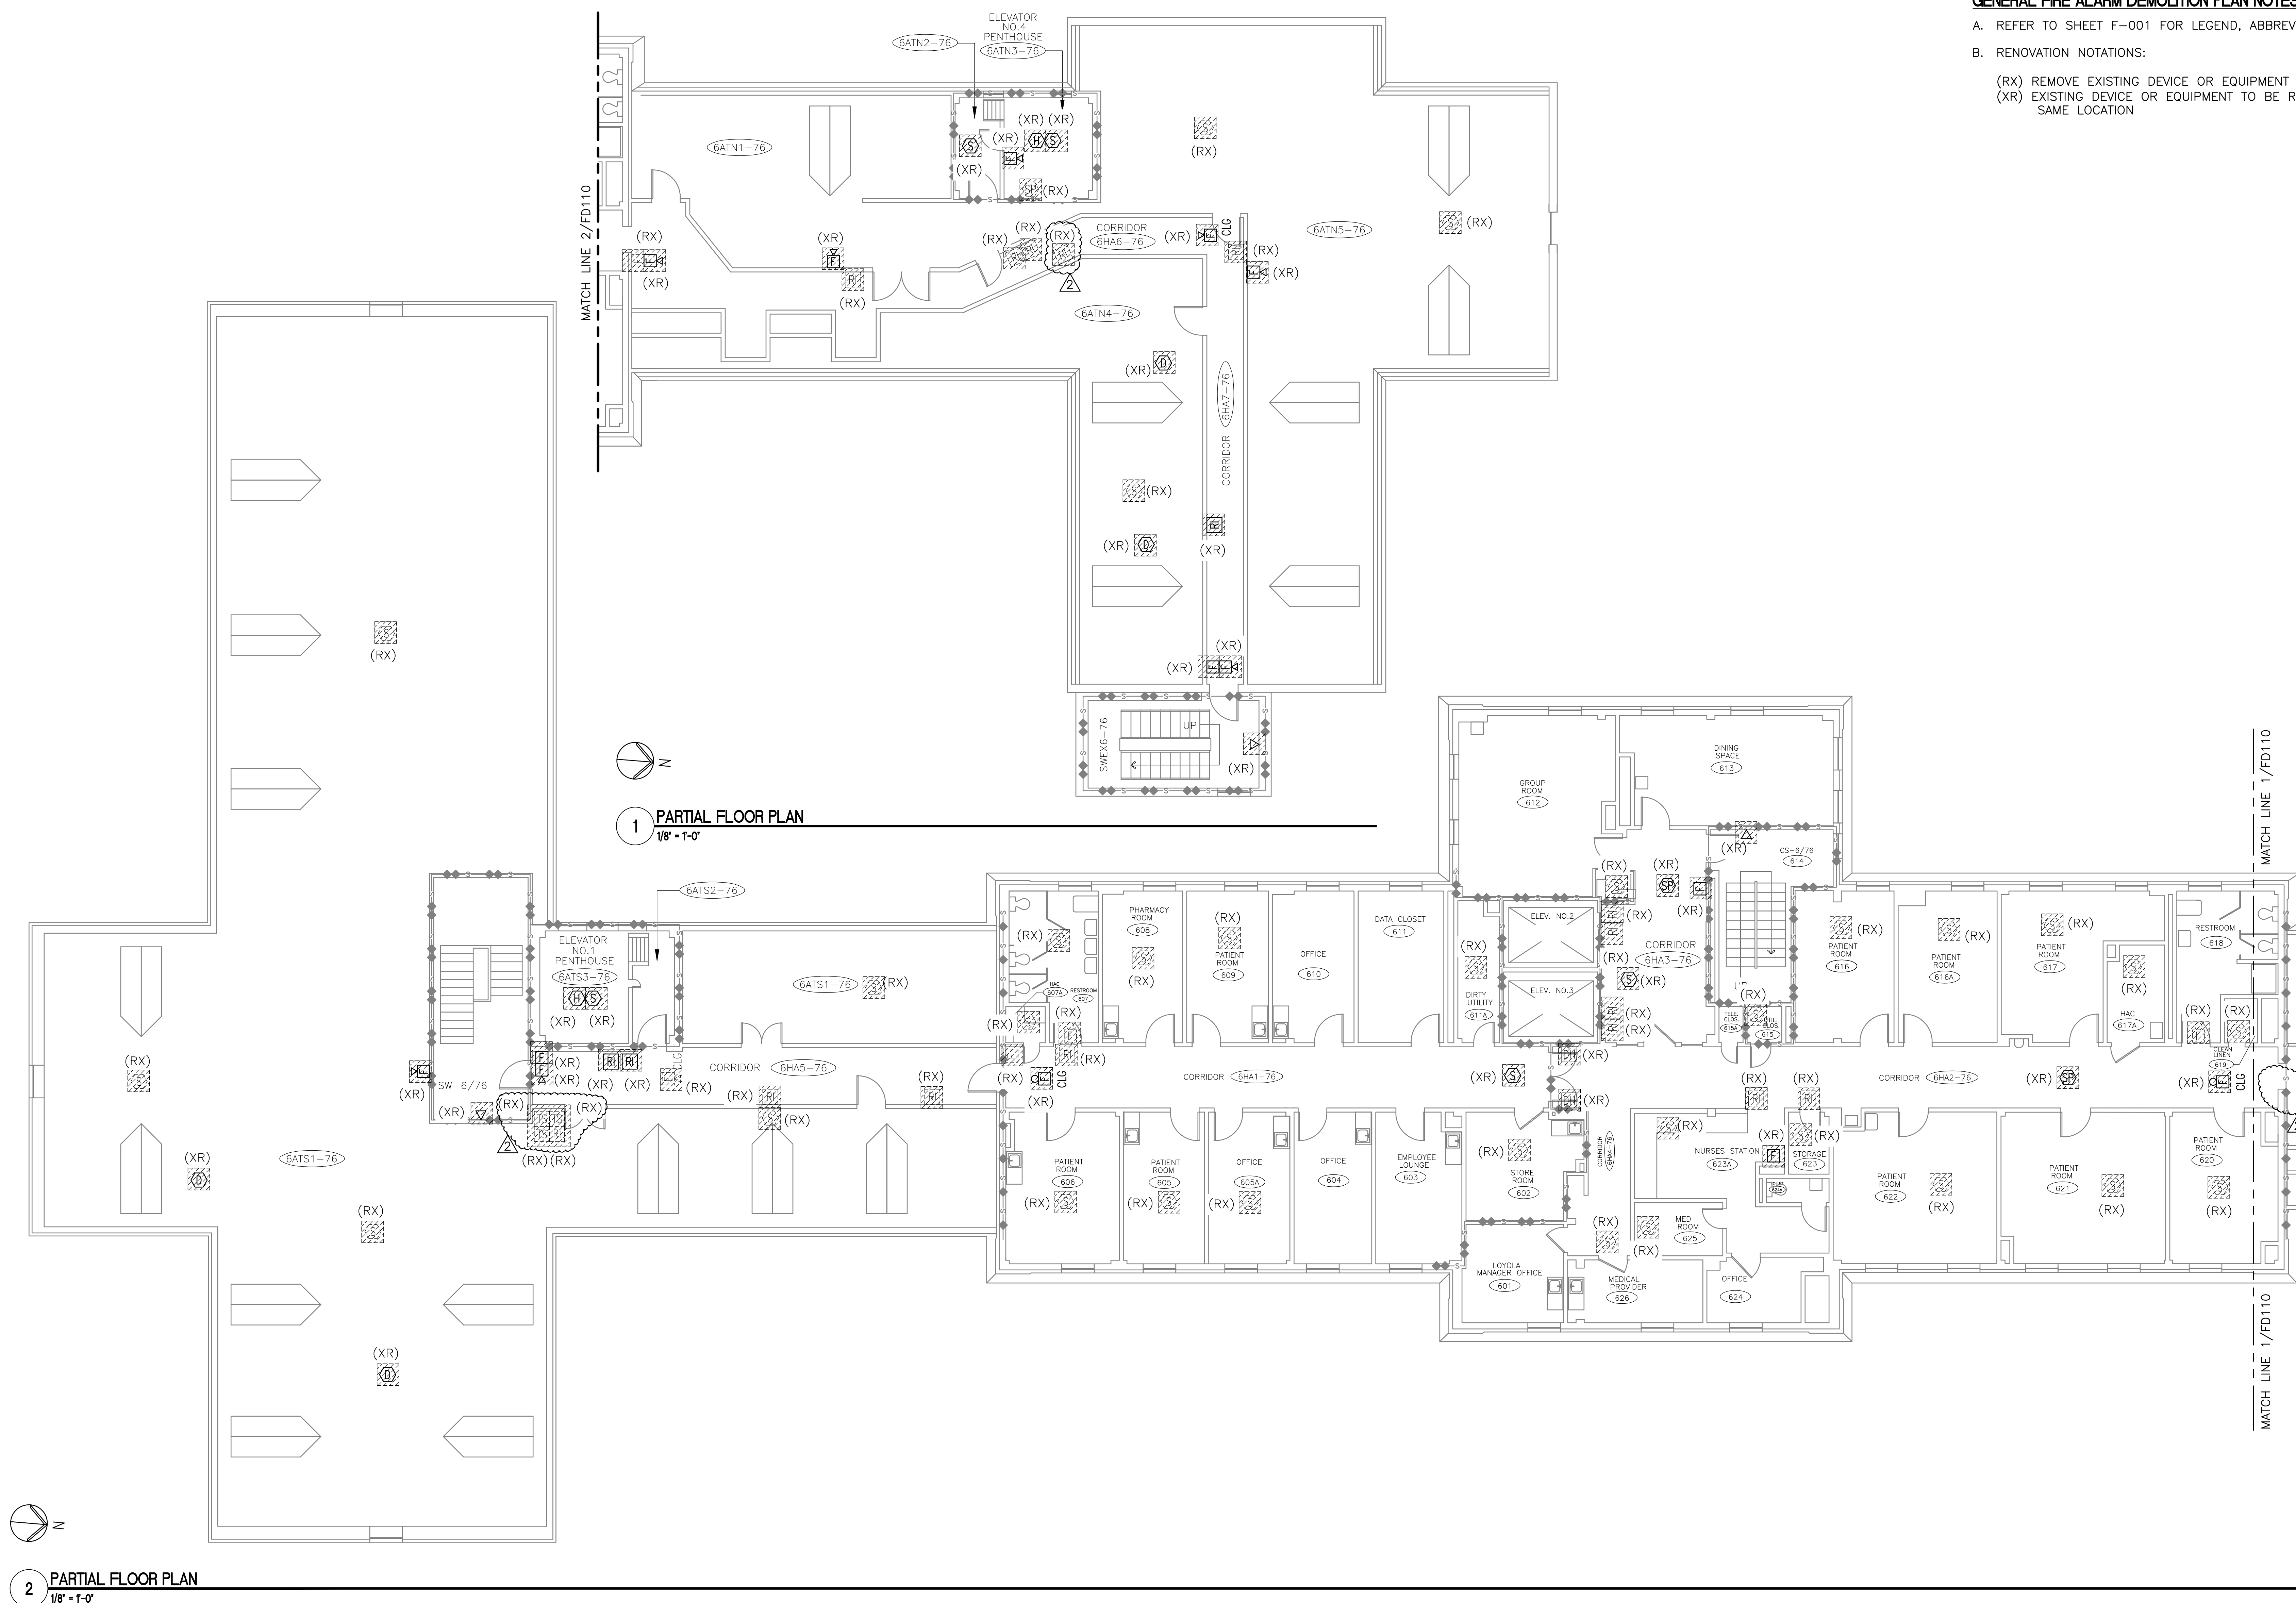

2 PARTIAL FLOOR PLAN
1/8" = 1'-0"

<div>AMENDMENT #2</div> <div>AMENDMENT #1</div> <div>Revisions</div>		<div>ARCHITECT/ENGINEERS:</div> <div><div>PARADIGM</div><div>ENGINEERS AND CONSTRUCTORS</div></div> <div>200 Envoy Circle #201, Louisville KY 40299 - PH: 502.339.8511 - www.paradigmusa.com</div>	<div>ALL WORK TO BE IN ACCORDANCE WITH N.E.P.A., NATIONAL, STATE AND CITY CODES & O.S.H.A.</div> <div>Approved: Logistics Manager. Date</div> <div>Approved: Infection Control Mgr. Date</div> <div>Approved: Chief Security Date</div>	<div>Approved: A.F.G.E. Date</div> <div>Approved: Interior Designer Date</div> <div>Approved: Info. Sys. Date</div> <div>Approved: Women's Health Rep Date</div>	<div>Approved: Fire Chief Date</div> <div>Approved: Safety Officer Date</div> <div>Approved: Industrial Hygienist Date</div> <div>Approved: Space Owner Date</div>	<div>Approved: Patient Safety Date</div> <div>Approved: M&R Foreman Date</div> <div>Approved: Industrial Hygienist Date</div> <div>Approved: Associate Director Date</div>	<div>Drawing Title</div> <div>FIRE ALARM DEMOLITION / REPLACEMENT SIXTH FLOOR</div> <div>Approved: Eng. Project Supervisor Date</div> <div>Approved: Medical Center Director Date</div>	<div>Project Title</div> <div>UPGRADE FIRE ALARM SYSTEM BUILDING 76</div> <div>Building No. 76</div> <div>Checked BAM</div> <div>Drawn MMF</div> <div>Location</div> <div>BATH, NEW YORK</div>	<div>Date</div> <div>07-21-2014</div> <div>Project No.</div> <div>528A6-14-601</div> <div>DRAWING NO.</div> <div>VAMC-528A6-0012</div> <div>FD110</div> <div>Dwg. 12 of 33</div>	<div></div> <div></div>	
	08/26/2014										
	08/14/2014										
	Date										