


- A. REFER TO SHEET F-001 FOR LEGEND, ABBREVIATIONS, AND GENERAL NOTES.
- B. RENOVATION NOTATIONS:
  - (R) LOCATION OF RELOCATED DEVICE OR EQUIPMENT
  - (RR) REMOVE AND RELOCATE EXISTING DEVICE OR EQUIPMENT
  - (X) EXISTING DEVICE OR EQUIPMENT TO REMAIN
  - (XR) EXISTING FIRE ALARM DEVICE OR EQUIPMENT THAT HAS BEEN REMOVED AND REPLACED WITH NEW, RE-USE EXISTING CONDUIT WHENEVER POSSIBLE.
- C. ALL AREAS SHALL BE CONSIDERED TO HAVE A LAY-IN CEILING UNLESS NOTED OTHERWISE.
- D. THE CONTRACTOR SHALL BE RESPONSIBLE FOR CUTTING AND PATCHING WALLS AND CEILINGS. MATCH EXISTING FINISHES.
- E. ALL FIRE ALARM WIRING SHALL BE IN CONDUIT.

1. ALL SPRINKLER LOW PRESSURE, TAMPER, AND FLOW SWITCHES ARE EXISTING TO REMAIN. REMOVE EXISTING FIRE ALARM INTERFACE MODULES AND FURNISH AND INSTALL NEW MODULES FOR MONITORING BY NEW SYSTEM.
2. REPLACE ELEVATOR #1 SHUTDOWN CONTROL MODULE.
3. REPLACE ELEVATOR #1 RECALL CONTROL MODULE.
4. REPLACE ELEVATOR #1 ALTERNATE FLOOR CONTROL MODULE.
5. REPLACE ELEVATOR #4 SHUTDOWN CONTROL MODULE.
6. REPLACE ELEVATOR #4 RECALL CONTROL MODULE.
7. REPLACE ELEVATOR #4 ALTERNATE FLOOR CONTROL MODULE.

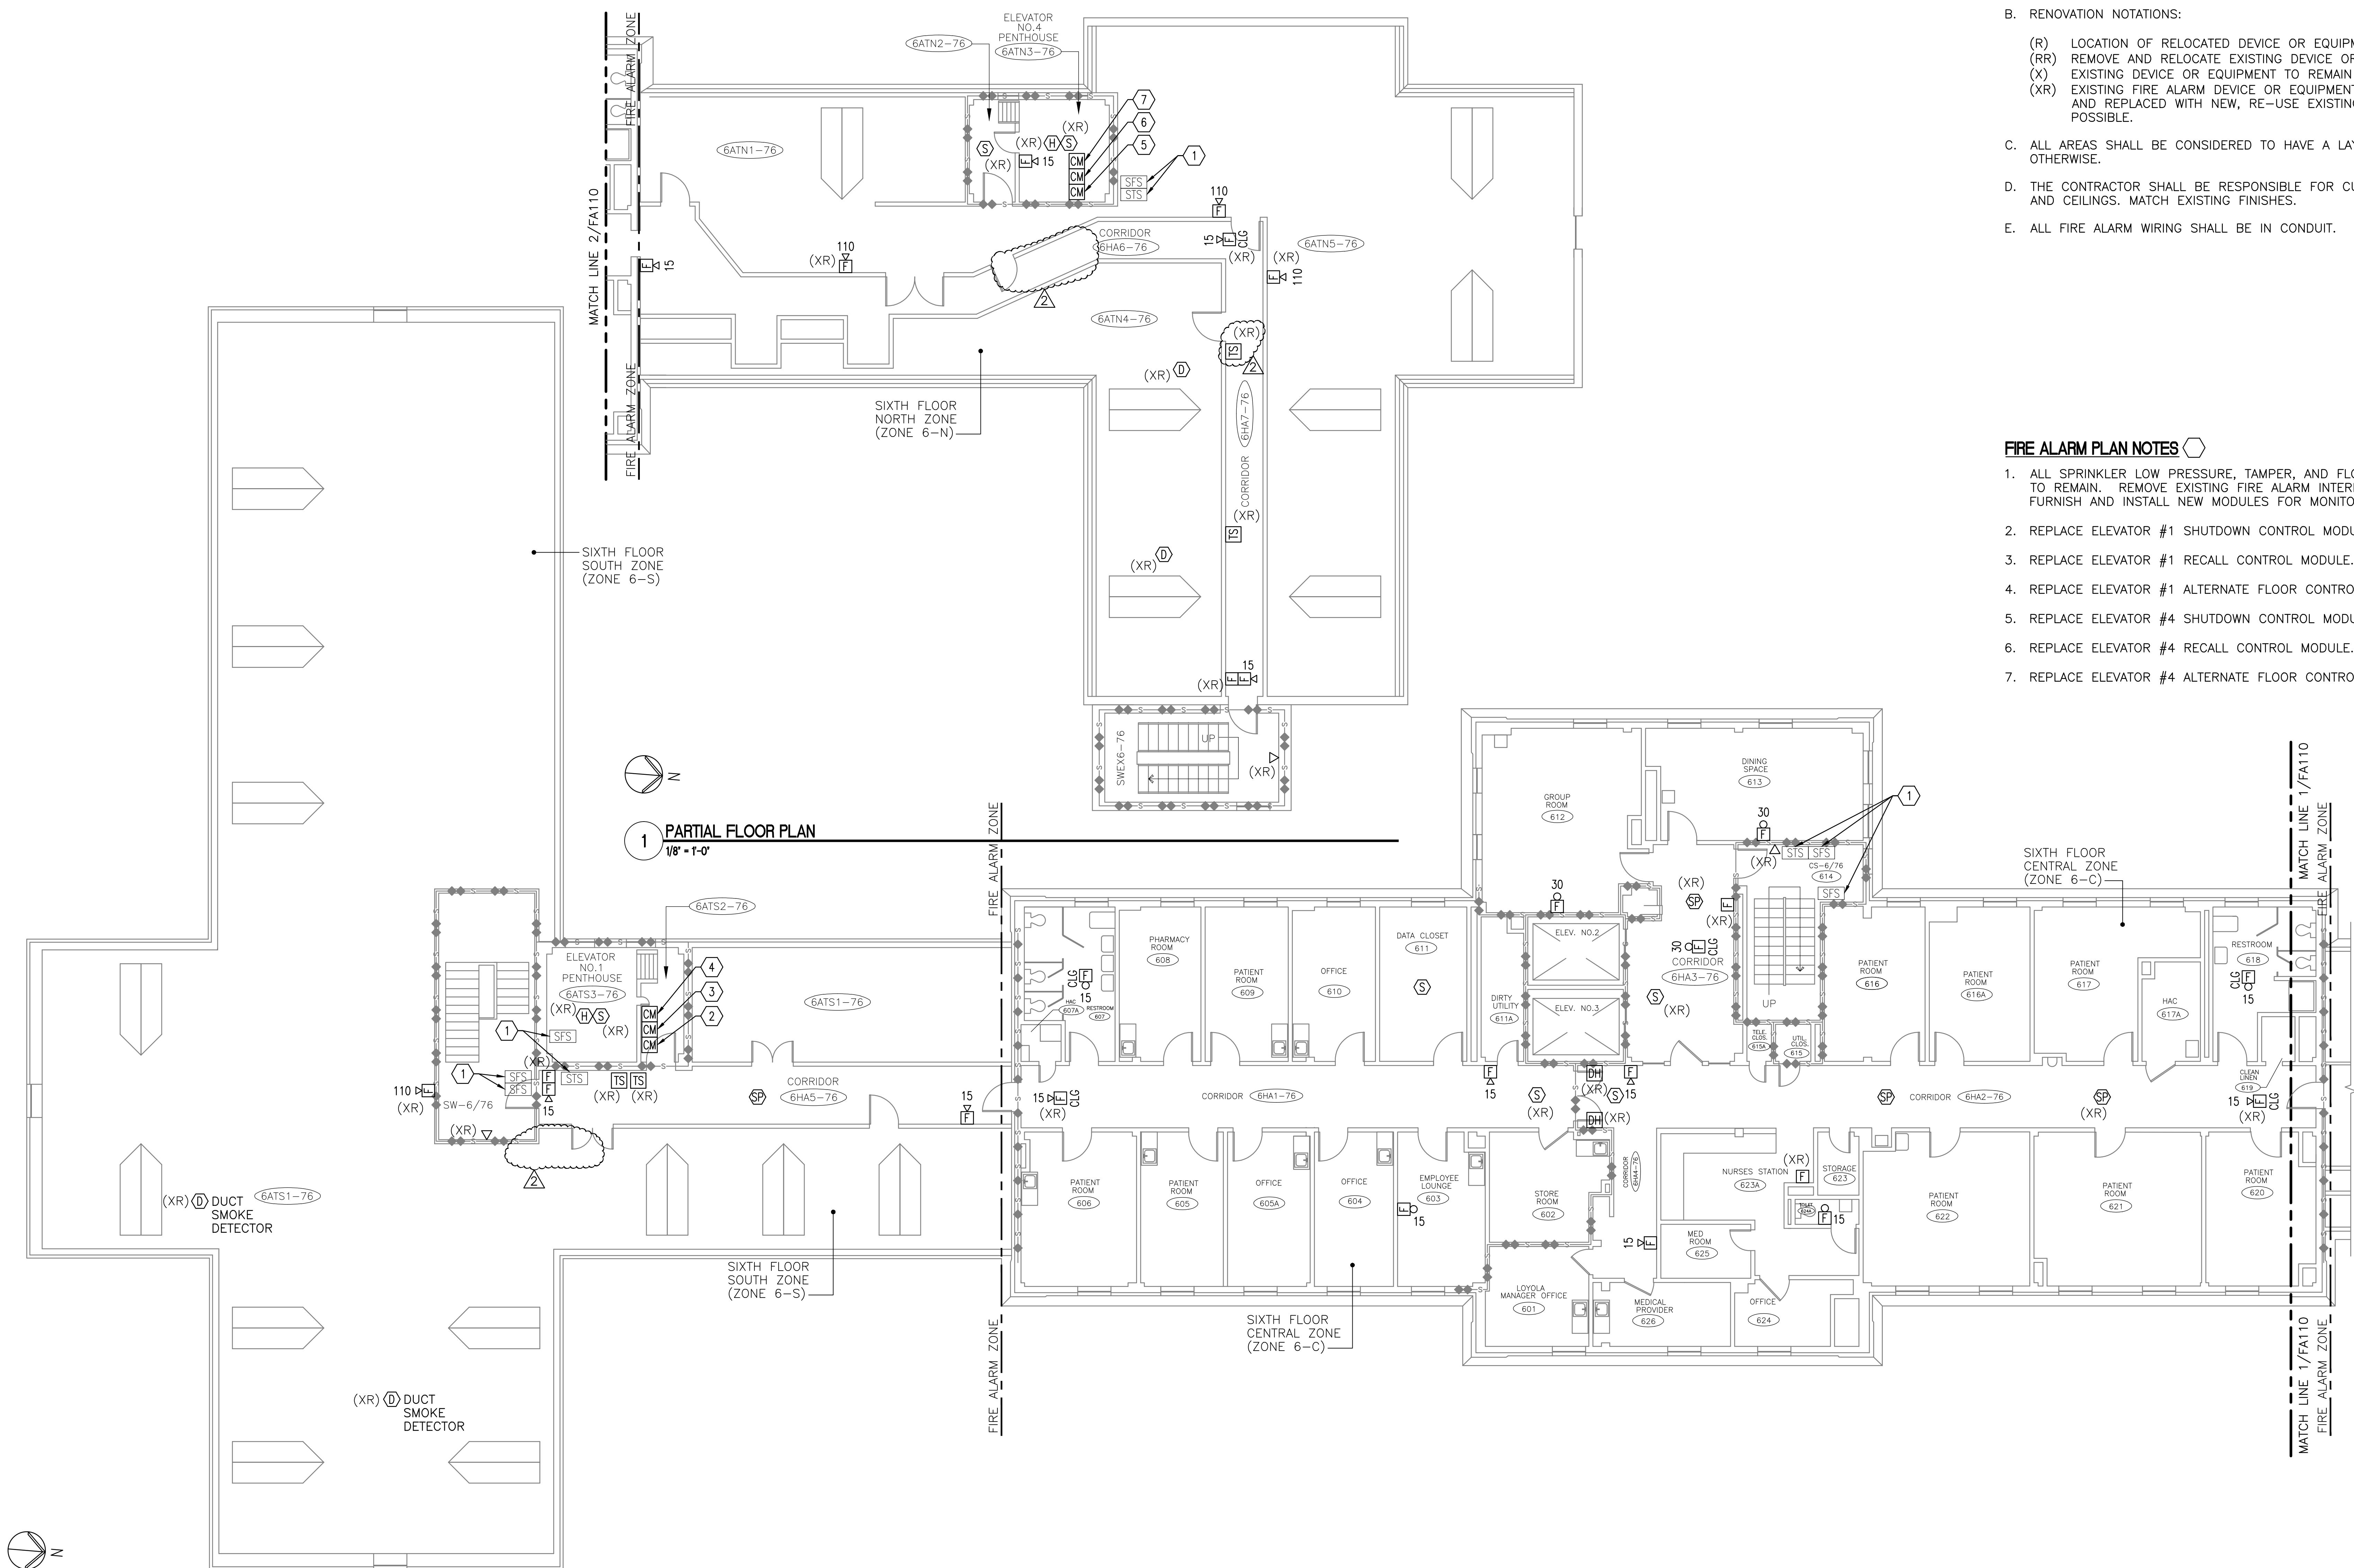

2 PARTIAL FLOOR PLAN  
1/8" = 1'-0"

1 PARTIAL FLOOR PLAN  
1/8" = 1'-0"

2 PARTIAL FLOOR PLAN  
1/8" = 1'-0"

**FULLY SPRINKLERED  
BID DOCUMENTS**

[illegible]