
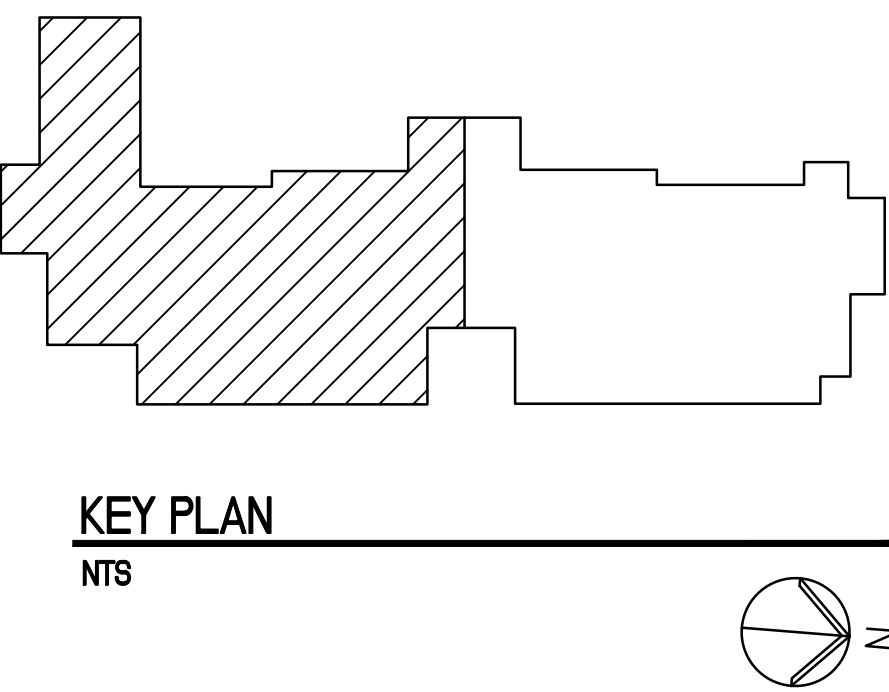


GENERAL FIRE ALARM PLAN NOTES

- A. REFER TO SHEET F-001 FOR LEGEND, ABBREVIATIONS, AND GENERAL NOTES.
- B. RENOVATION NOTATIONS:
- (R) LOCATION OF RELOCATED DEVICE OR EQUIPMENT
 - (RR) REMOVE AND RELOCATE EXISTING DEVICE OR EQUIPMENT
 - (X) EXISTING DEVICE OR EQUIPMENT TO REMAIN
 - (XR) EXISTING FIRE ALARM DEVICE OR EQUIPMENT THAT HAS BEEN REMOVED AND REPLACED WITH NEW, RE-USE EXISTING CONDUIT WHENEVER POSSIBLE.
- C. ALL AREAS SHALL BE CONSIDERED TO HAVE A LAY-IN CEILING UNLESS NOTED OTHERWISE.
- D. THE CONTRACTOR SHALL BE RESPONSIBLE FOR CUTTING AND PATCHING WALLS AND CEILINGS. MATCH EXISTING FINISHES.
- E. ALL FIRE ALARM WIRING SHALL BE IN CONDUIT.

FIRE ALARM PLAN NOTES

1. ALL SPRINKLER LOW PRESSURE, TAMPER, AND FLOW SWITCHES ARE EXISTING TO REMAIN. REMOVE EXISTING FIRE ALARM INTERFACE MODULES AND FURNISH AND INSTALL NEW MODULES FOR MONITORING BY NEW SYSTEM.

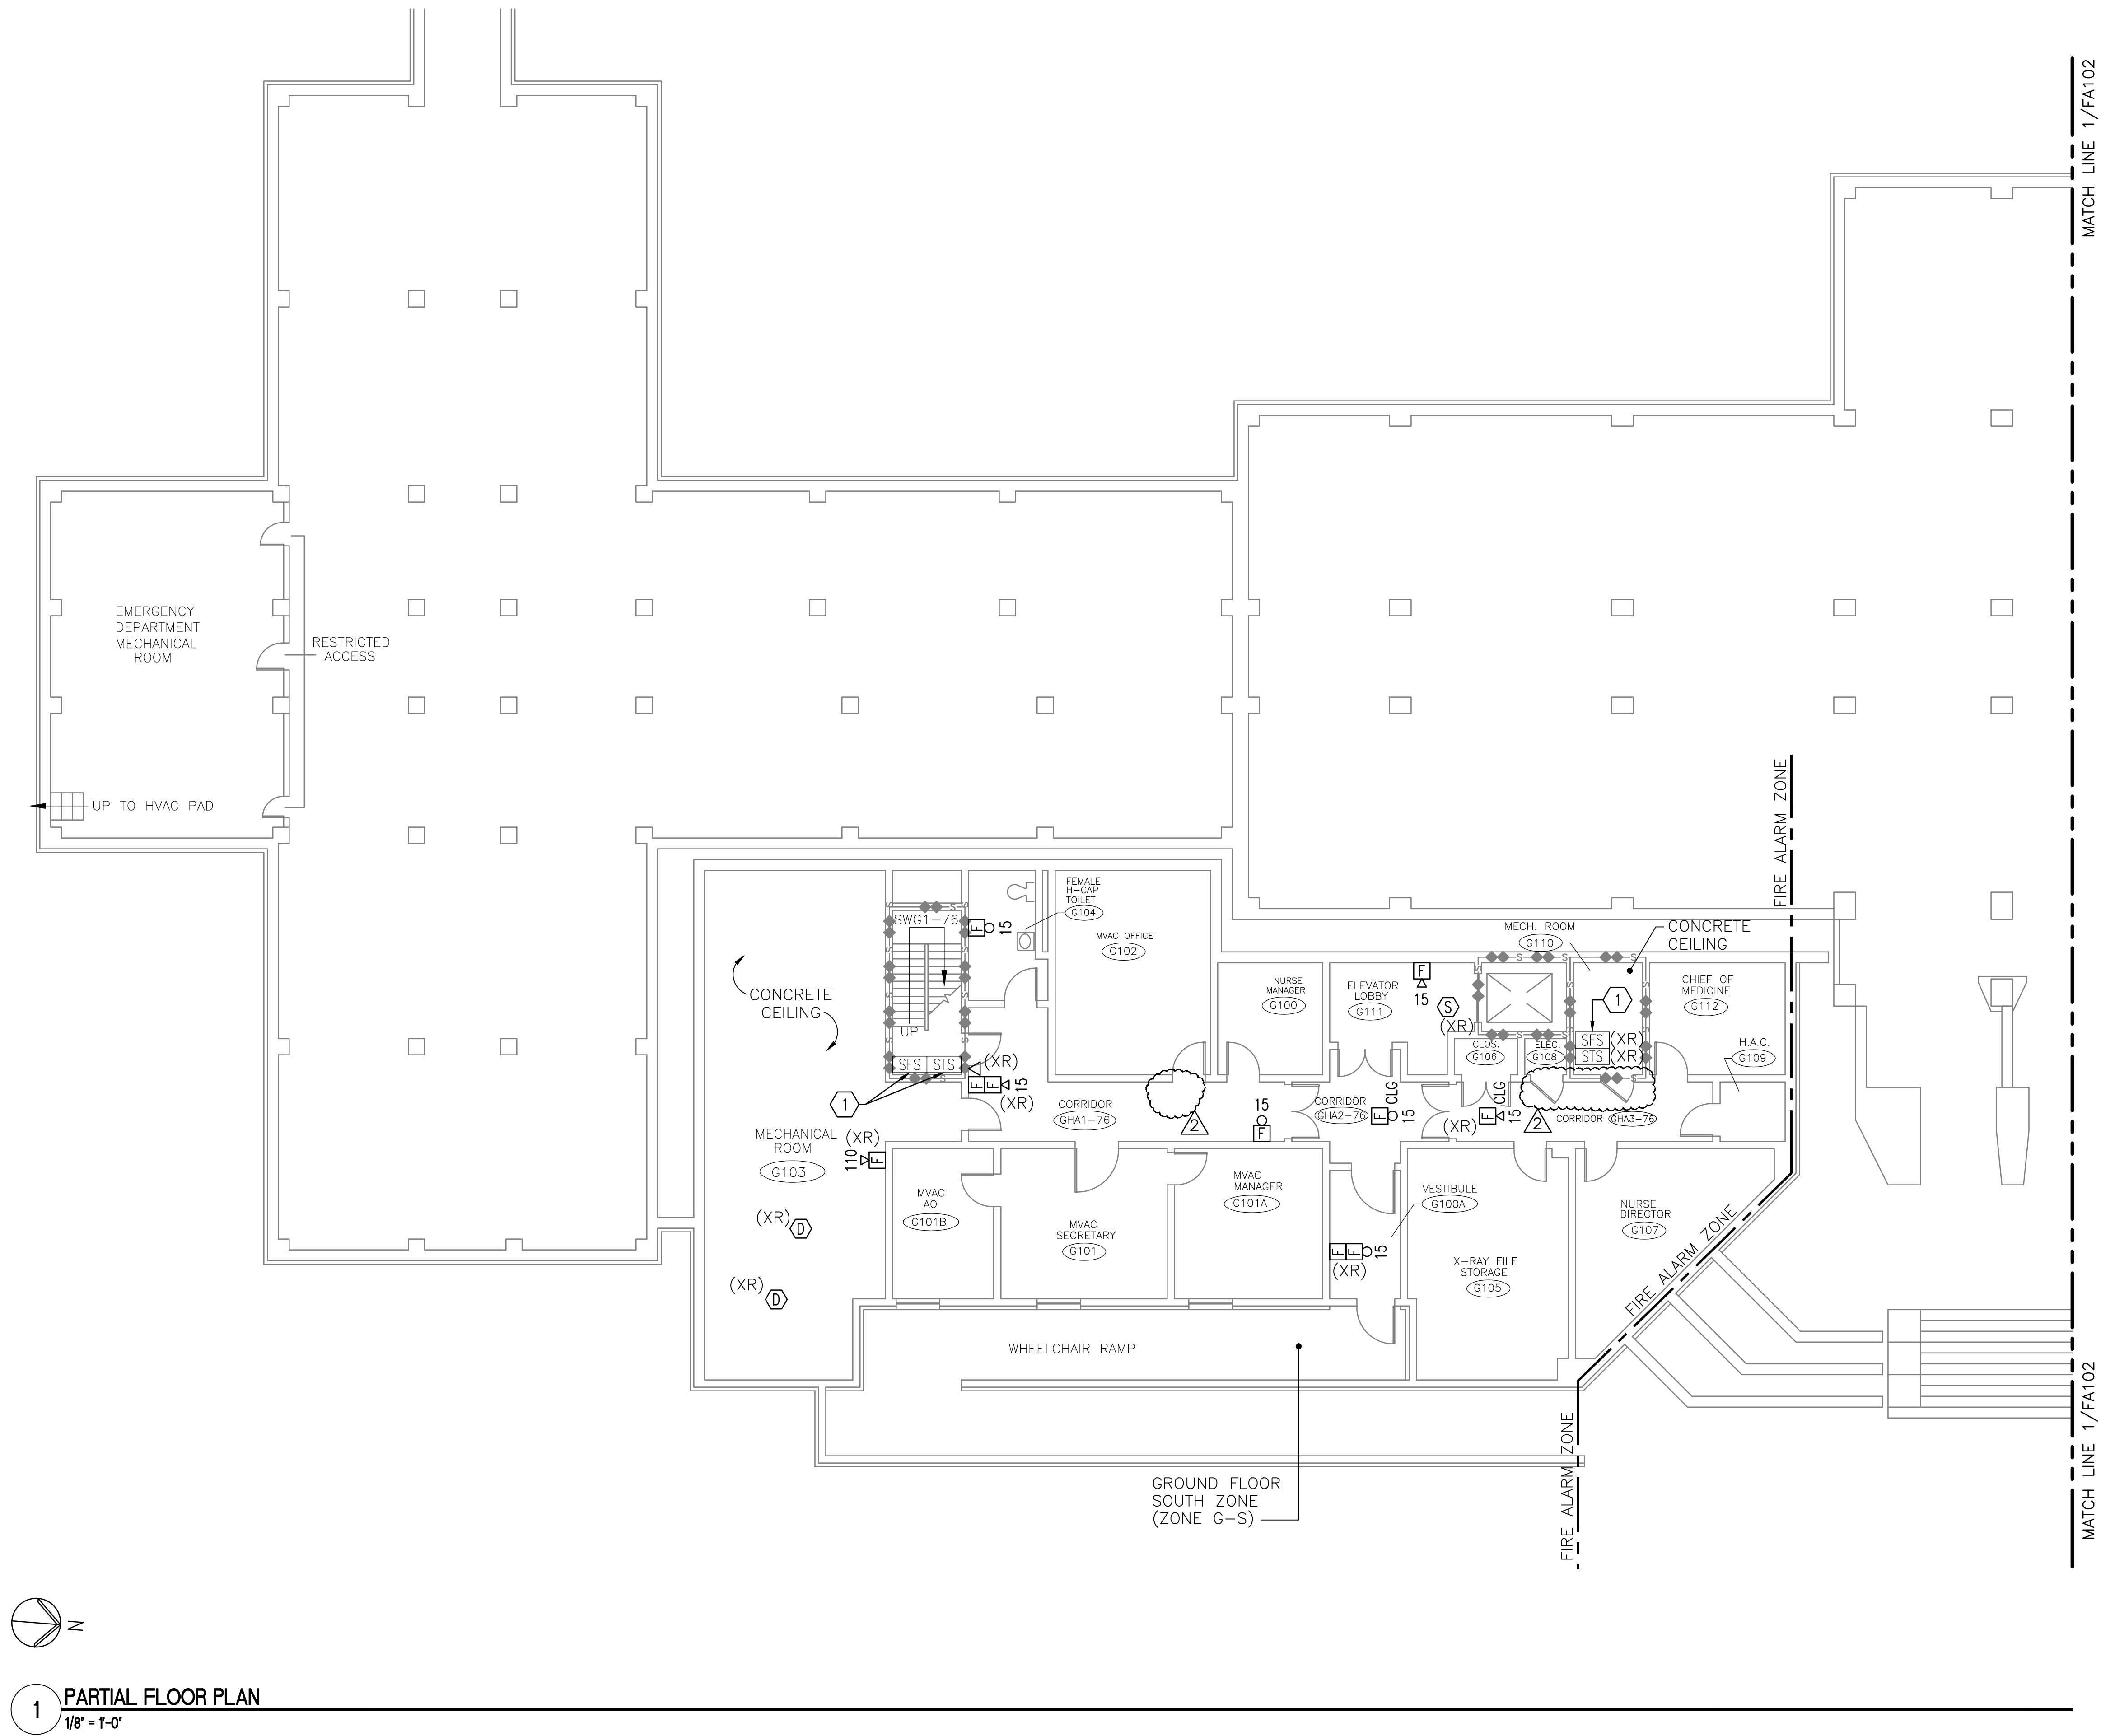

1 PARTIAL FLOOR PLAN
1/8" = 1'-0"

KEY PLAN
NTS

FULLY SPRINKLERED
BID DOCUMENTS

		ARCHITECT/ENGINEERS:	ALL WORK TO BE IN ACCORDANCE WITH N.F.P.A., NATIONAL, STATE AND CITY CODES & O.S.H.A.	Approved: A.F.G.E. Date	Approved: Fire Chief Date	Approved: Patient Safety Date	Drawing Title FIRE ALARM - GROUND FLOOR PLAN SOUTH	Project Title UPGRADE FIRE ALARM SYSTEM BUILDING 76	Date 07-21-2014	A . V	
		<div>PARADIGM</div> <div>ENGINEERS AND CONSTRUCTORS</div> <div>200 Envoy Circle #201, Louisville KY 40299 ~ PH: 502.339.8511 ~ www.paradigmusa.com</div>	Approved: Logistics Manager. Date	Approved: Interior Designer Date	Approved: Safety Officer Date	Approved: M&R Foreman Date			Project No. 528A6-14-601		
		Approved: Infection Control Mgr. Date	Approved: Info. Sys. Date	Approved: Industrial Hygienist Date	Approved: Industrial Hygienist Date	Approved: Eng. Project Supervisor Date	Building No. 76	Checked BAM	Drawn MMF		DRAWING NO. VAMC-528A6-0012
		Approved: Chief Security Date	Approved: Women's Health Rep Date	Approved: Space Owner Date	Approved: Associate Director Date	Approved: Medical Center Director Date	Location BATH, NEW YORK		FA101		Dwg. 14 of 33