






GENERAL FIRE ALARM DEMOLITION PLAN NOTES

- A. REFER TO SHEET F-001 FOR LEGEND, ABBREVIATIONS, AND GENERAL NOTES.
- B. RENOVATION NOTATIONS:
- (RX) REMOVE EXISTING DEVICE OR EQUIPMENT
- (XR) EXISTING DEVICE OR EQUIPMENT TO BE REMOVED AND REPLACED AT SAME LOCATION

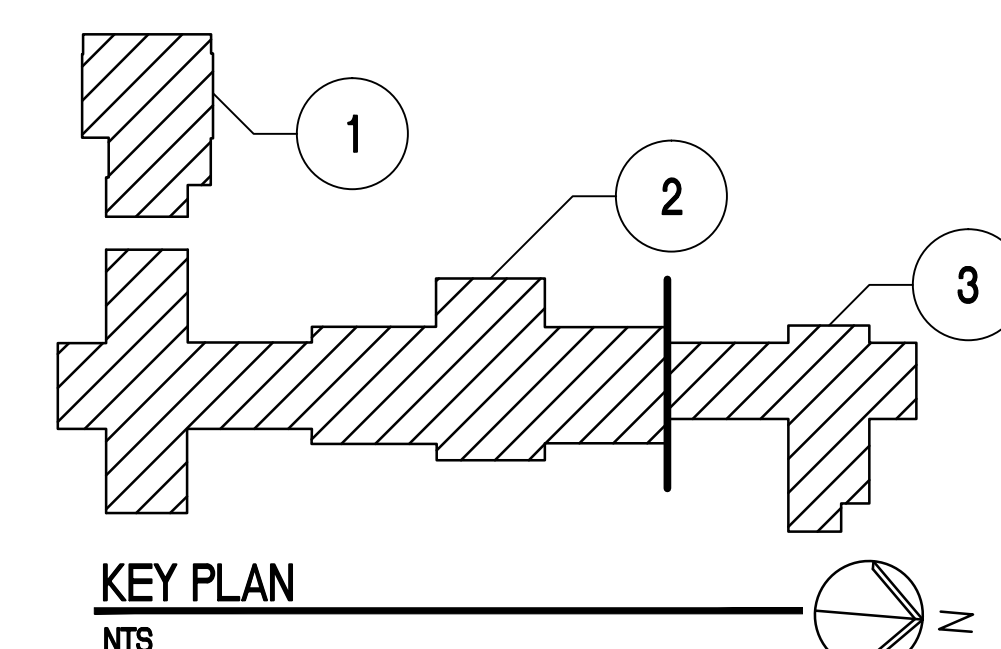

**FULLY SPRINKLERED
BID DOCUMENTS**

		ARCHITECT/ENGINEERS:		ALL WORK TO BE IN ACCORDANCE WITH N.F.P.A., NATIONAL, STATE AND CITY CODES & O.S.H.A.		Approved: A.F.G.E. _____ Date _____		Approved: Fire Chief _____ Date _____		Approved: Patient Safety _____ Date _____		Drawing Title FIRE ALARM DEMOLITION / REPLACEMENT SECOND FLOOR		Project Title UPGRADE FIRE ALARM SYSTEM BUILDING 76		Date 07-21-2014				
				Approved: Logistics Manager. _____ Date _____		Approved: Interior Designer _____ Date _____		Approved: Safety Officer _____ Date _____		Approved: M&R Foreman _____ Date _____		Approved: _____ Date _____		Project No. 528A6-14-601		Building No. 76			Checked BAM	Drawn MMF
AMENDMENT #2 08/26/2014		08/26/2014		Approved: Infection Control Mgr. _____ Date _____		Approved: Info. Sys. _____ Date _____		Approved: Industrial Hygienist _____ Date _____		Approved: Industrial Hygienist _____ Date _____		Approved: Eng. Project Supervisor _____ Date _____		Drawing No. VAMC-528A6-0012		FD105			Dwg. 7 of 33	
AMENDMENT #1 08/14/2014		08/14/2014		Approved: Chief Security _____ Date _____		Approved: Women's Health Rep _____ Date _____		Approved: Space Owner _____ Date _____		Approved: Associate Director _____ Date _____		Approved: Medical Center Director _____ Date _____		Location BATH, NEW YORK						
Revisions Date _____		Date _____		200 Envoy Circle #201, Louisville KY 40299 - PH: 502.339.8511 - www.paradigmusa.com																