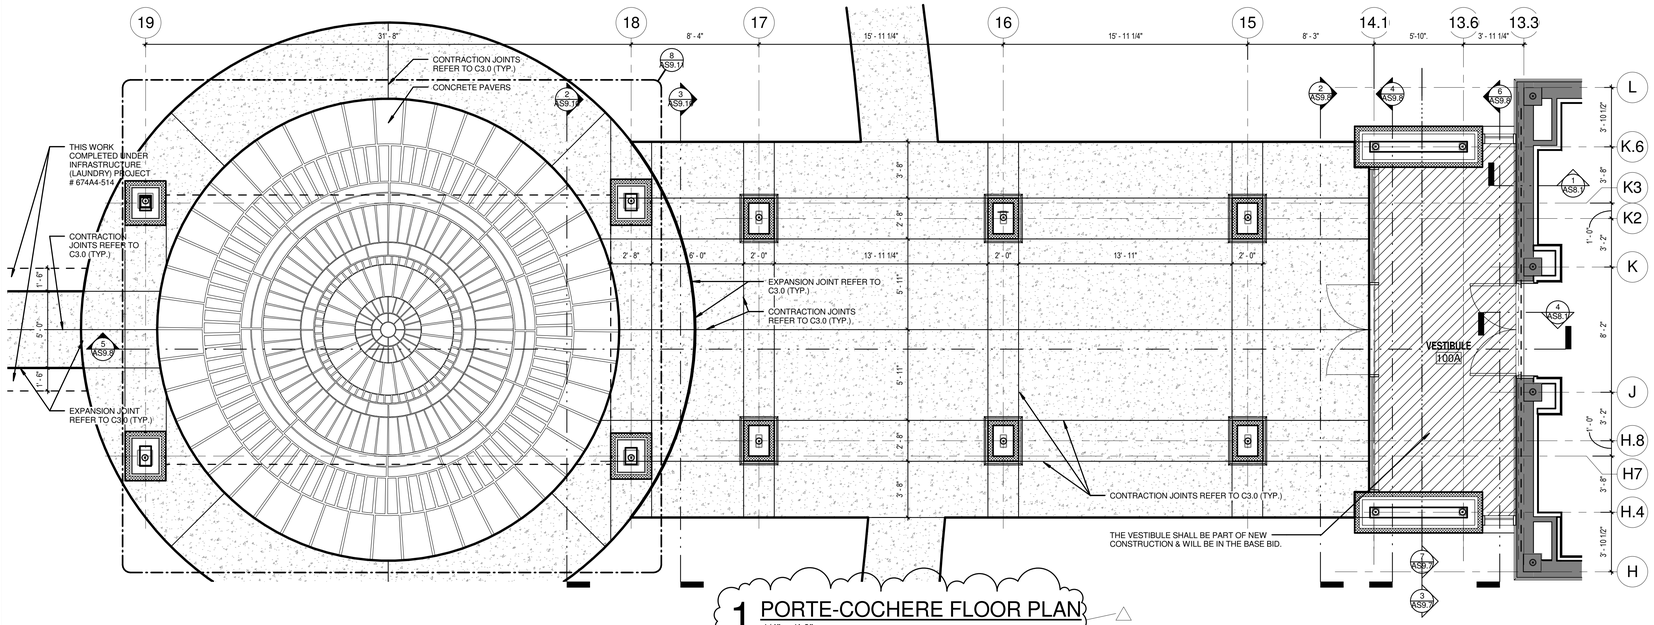

1 PORTE-COCHERE FLOOR PLAN
1/4" = 1'-0"

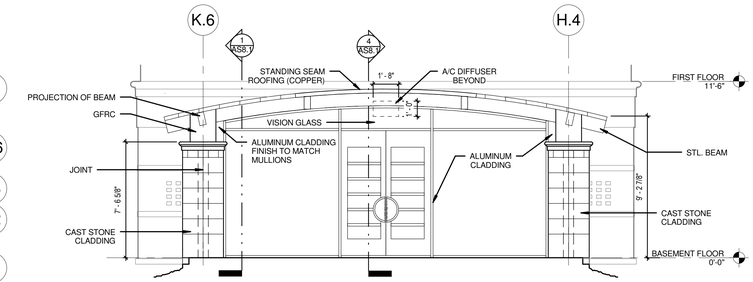

2 ELEV. @ VESTIBULE
1/4" = 1'-0"

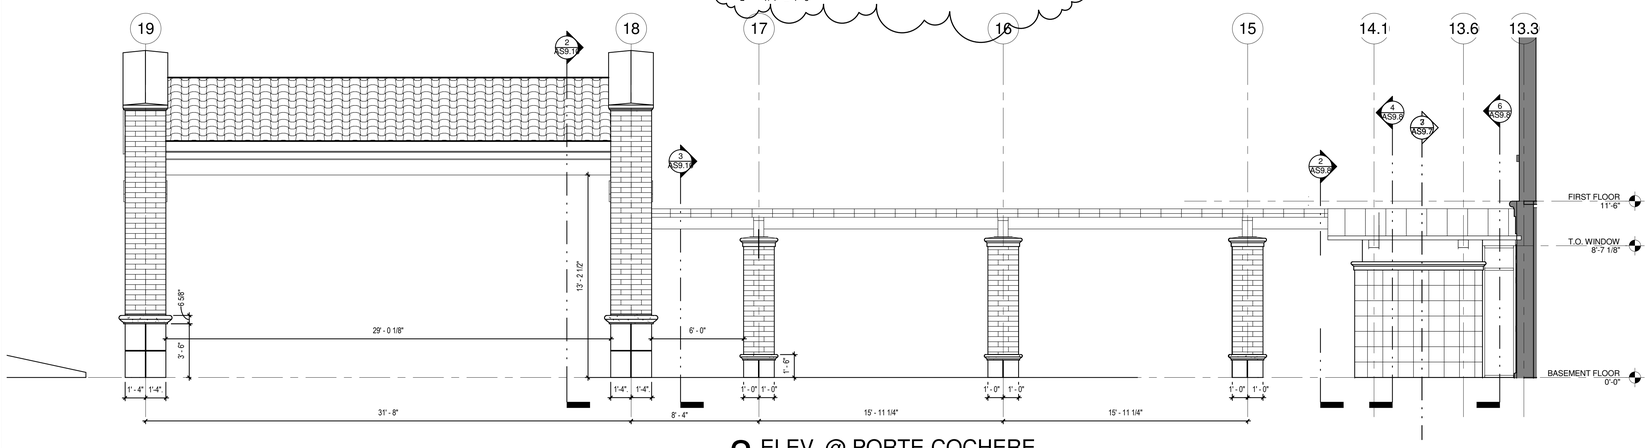

3 ELEV. @ PORTE-COCHERE
1/4" = 1'-0"

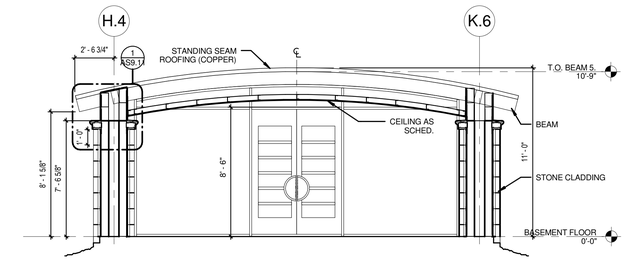

4 SECTION THRU VESTIBULE
1/4" = 1'-0"

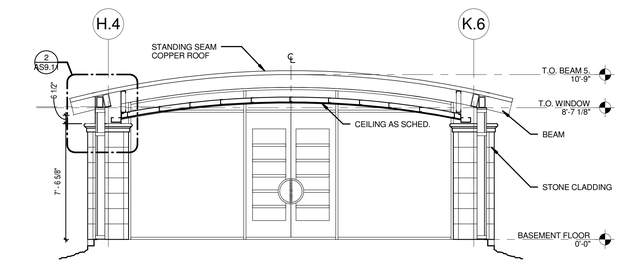

6 SECTION THRU VESTIBULE WINDOWS
1/4" = 1'-0"

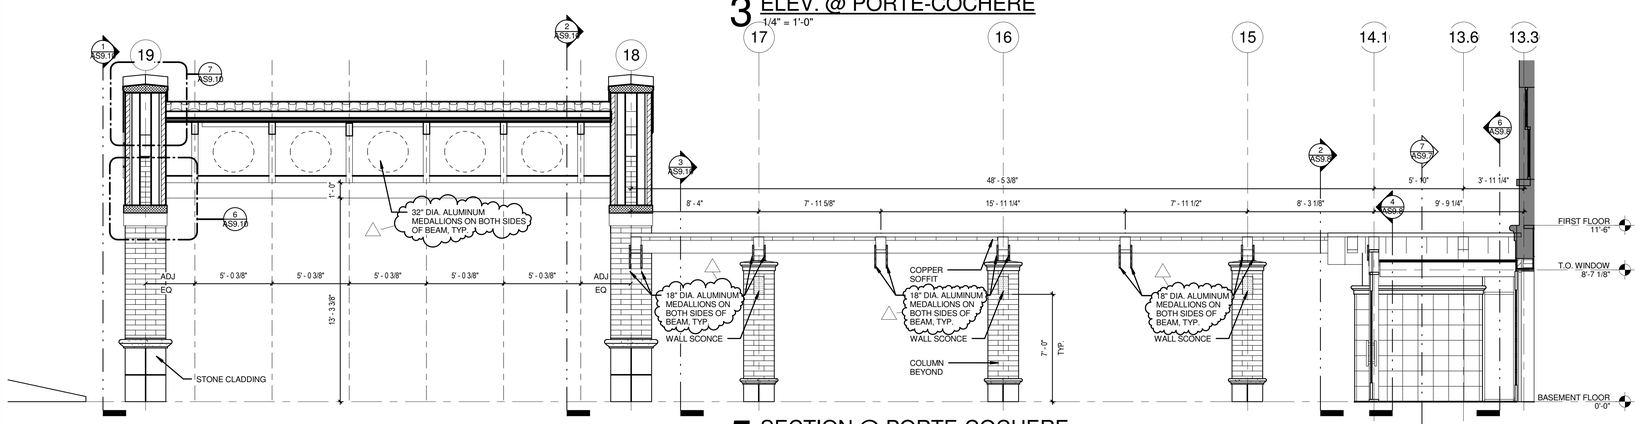

5 SECTION @ PORTE-COCHERE
1/4" = 1'-0"

REVISED DECEMBER 7, 2010 (REPLACES APRIL 29, 2010)	12-07-10
Revisions:	Date:

CONSULTANTS:

REGISTERED ARCHITECT LANCE MELTON STATE OF TEXAS 19288
12.07.10

ARCHITECT/ ENGINEERS

WIGINTON HOOKER JEFFRY P.C.
ARCHITECTS
500 N. Central Expressway Suite 300
Plano, Texas 75074
P : 972.665.0657
F : 972.665.0656

DRAWING TITLE: CANOPY & PORTE-COCHERE

PROJECT MANAGER:

Project Title: MENTAL HEALTH - CENTER OF EXCELLENCE
TASK ORDER NO. 0001

Location: 4800 MEMORIAL DRIVE WACO, TEXAS 76710

Date: APRIL 29, 2010

Project Number: 674A4-510

Building Number: 93

Drawing Number: AS9.8

Dwg. _____ of _____

CENTRAL TEXAS VETERANS HEALTHCARE SYSTEM

Department of Veterans Affairs