## GENERAL NOTES

A THE INTENTION OF PHASE 5 IS TO REMOVE THE TEMPORARY COOLING SYSTEM SERVING AUDITORIUM.

B REFER TO SHEET M001 FOR LEGEND, ABBREVIATIONS AND ADDITIONAL GENERAL NOTES.

## NOTES

1. REMOVE TEMPORARY AIR CONDITIONING UNIT AND ASSOCIATED DUCTWORK.
2. RE-INSTALL EXISTING WINDOW.
3. REMOVE SHEET METAL PLENUM BOX AND ASSOCIATED AIR DEVICES.
4. TEMPORARY AIR CONDITIONING OF MEDICAL MEDIA IS BEING PROVIDED BY VA OUTSIDE OF THIS PROJECT SCOPE.
5. BALANCE EXISTING AIR TERMINAL UNIT TO INDICATED CFM.
6. ALL EXISTING 1-AHU21 SUPPLY DUCTWORK UPSTREAM OF AIR TERMINAL UNITS SHALL BE TESTED AND SEALED USING "AEROSEAL" PRODUCT. AFTER SPECIFIED TRADITIONAL DUCT SEALING PROCESS IS COMPLETE. THE "AEROSEAL" DUCT SEALING SHALL BE DELETED UNDER BID ITEM 2. (1)
7. NEW THERMOSTAT TO CONTROL AIR TERMINAL UNIT 21-1. PROVIDE IN PHASE 3. PLACE IN SAME LOCATION AS EXISTING.
8. PROVIDE AUDITORIUM THERMOSTAT AND CO2 SENSOR IN PHASE 3.
9. NEW THERMOSTAT TO CONTROL AIR TERMINAL UNIT 21-2. PROVIDE IN PHASE 3. PLACE IN SAME LOCATION AS EXISTING.

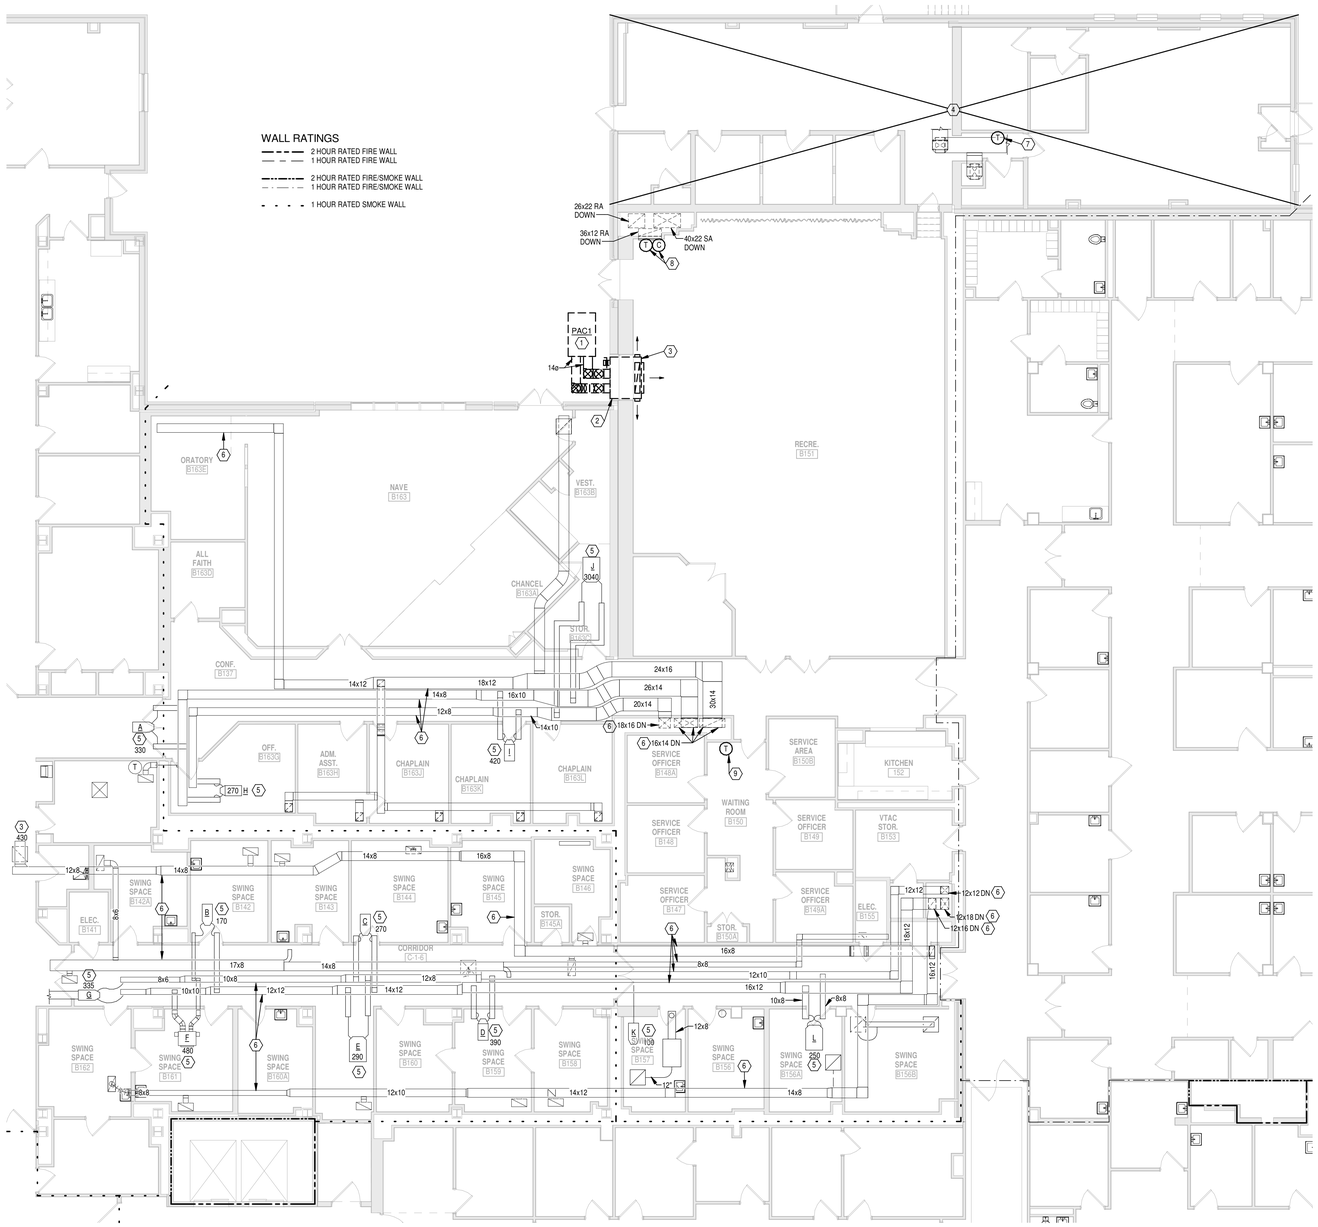


## PHASE 5 - FIRST FLOOR PLAN

Scale: 1/8" = 1'-0"

| | | |
|---|---|---|
| 1 | Amendment 1 | 10/20/2014 |
| Revisions | | Date |

10/20/2014 8:15:51 AM

CONSULTANTS:

STATE OF OHIO — GARY S. EODICE E-52755 — REGISTERED PROFESSIONAL ENGINEER

ARCHITECT/ENGINEERS:


Heapy Engineering
MEP Design Technology Planning Commissioning Energy
*Nationally Recognized Leader in Sustainability*
1400 W Dorothy Lane, Dayton, OH 45409-1310
Ph 937-224-0861 Fax 937-224-5777 www.heapy.com
HEAPY PROJECT No.: 2013-04024 FIRM LICENSE No.: 01528


Drawing Title: PHASE 5 - FIRST FLOOR PLAN

Approved: Project Director

Project Title: INSTALL NEW HVAC IN AUDITORIUM

Location: Cincinnati, Ohio

Date: 05/23/2014 | Checked: DLE | Drawn: WJS

Project No. VA Project No. 539-15-202

Building Number: 1

Drawing Number: MH106

Dwg. of xx

Office of Construction and Facilities Management

Department of Veterans Affairs