DEMOLITION PLAN LEGEND:

NOTES:
1. SEE MECHANICAL DRAWINGS FOR PLUMBING, HVAC AND FIRE PROTECTION DEMOLITION.
2. SEE ELECTRICAL DRAWINGS FOR POWER, LIGHTING AND COMMUNICATIONS DEMOLITION.
3. SEE ASBESTOS ABATEMENT DRAWINGS FOR ABATEMENT WORK.

REMOVE DOOR, FRAME AND HARDWARE

TEMPORARY CONSTRUCTION PARTITION

EXISTING TEMPORARY DOOR

REMOVE INTERIOR PARTITION FROM FLOOR TO UNDERSIDE OF STRUCTURE ABOVE. PREPARE ALL ADJACENT SURFACES TO RECEIVE NEW CONSTRUCTION AND SCHEDULED FINISH.

1. PROTECT EXISTING ELECTRICAL CHASE DURING ALL CONSTRUCTION PHASES.
2. REMOVE LEAD LINED WALLS AND DOORS, SEE ABATEMENT DRAWINGS AND SPECIFICATIONS.
3. REMOVE EXISTING CEILING SYSTEM, SUPPORTS, TIES, AND RELATED EQUIPMENT, COORDINATE WITH ELECTRICAL WORK ON REMOVAL AND/ OR RELOCATION OF LIGHTS, CONDUIT, TIES, SUPPORTS AND RELATED WIRING. COORDINATE WITH MECHANICAL ON REMOVAL OF DIFFUSERS, GRILLES AND RELATED DUCTWORK AND EQUIPMENT. CONTRACTOR SHALL VERIFY FIXTURES FOR SALVAGE OR RELOCATION PRIOR TO COMMENCING DEMOLITION.

4. REMOVE EXISTING FLOOR FINISH AND BASE FROM ENTIRE ROOM TO TOP OF STRUCTURAL SLAB OR SUBFLOOR AS REQUIRED FOR NEW CONSTRUCTION, PATCH AND LEVEL EXISTING FLOOR TO RECEIVE NEW FLOOR FINISH AS SCHEDULED. LEVEL PER NEW FLOOR FINISH MANUFACTURER'S RECOMMENDATIONS. PATCH EXISTING WALL AS REQUIRED TO RECEIVE NEW WALL BASE AS SCHEDULED.
5. APPROXIMATE AREA OF EXISTING DEPRESSED SLAB.
6. REMOVE PORTION OF WALL AS REQUIRED FOR NEW OPENING. PATCH AND PREPARE ADJACENT SURFACES TO MATCH EXISTING OR SCHEDULED FINISH. TEMPORARILY PROTECT ADJACENT OCCUPIED AREAS UNTIL WORK IS COMPLETED.

7. REMOVE PORTION OF WALL AS REQUIRED FOR NEW OPENING.
8. REMOVE EXISTING DUMBWAITER IN ITS ENTIRETY THROUGH OUT THE PROJECT AREA
9. TEMPORARILY SEAL DOORS DURING CONSTRUCTION
10. REMOVE EXISTING FLOORING
11. REMOVE EXISTING WALL FINISHES. PREPARE WALLS FOR NEW FINISHES
12. REMOVE EXISTING CEILING TILES AND GRID. PATCH WALLS AS REQ'D.

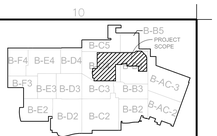

KEY PLAN - BASEMENT
Scale = None

TRUE NORTH

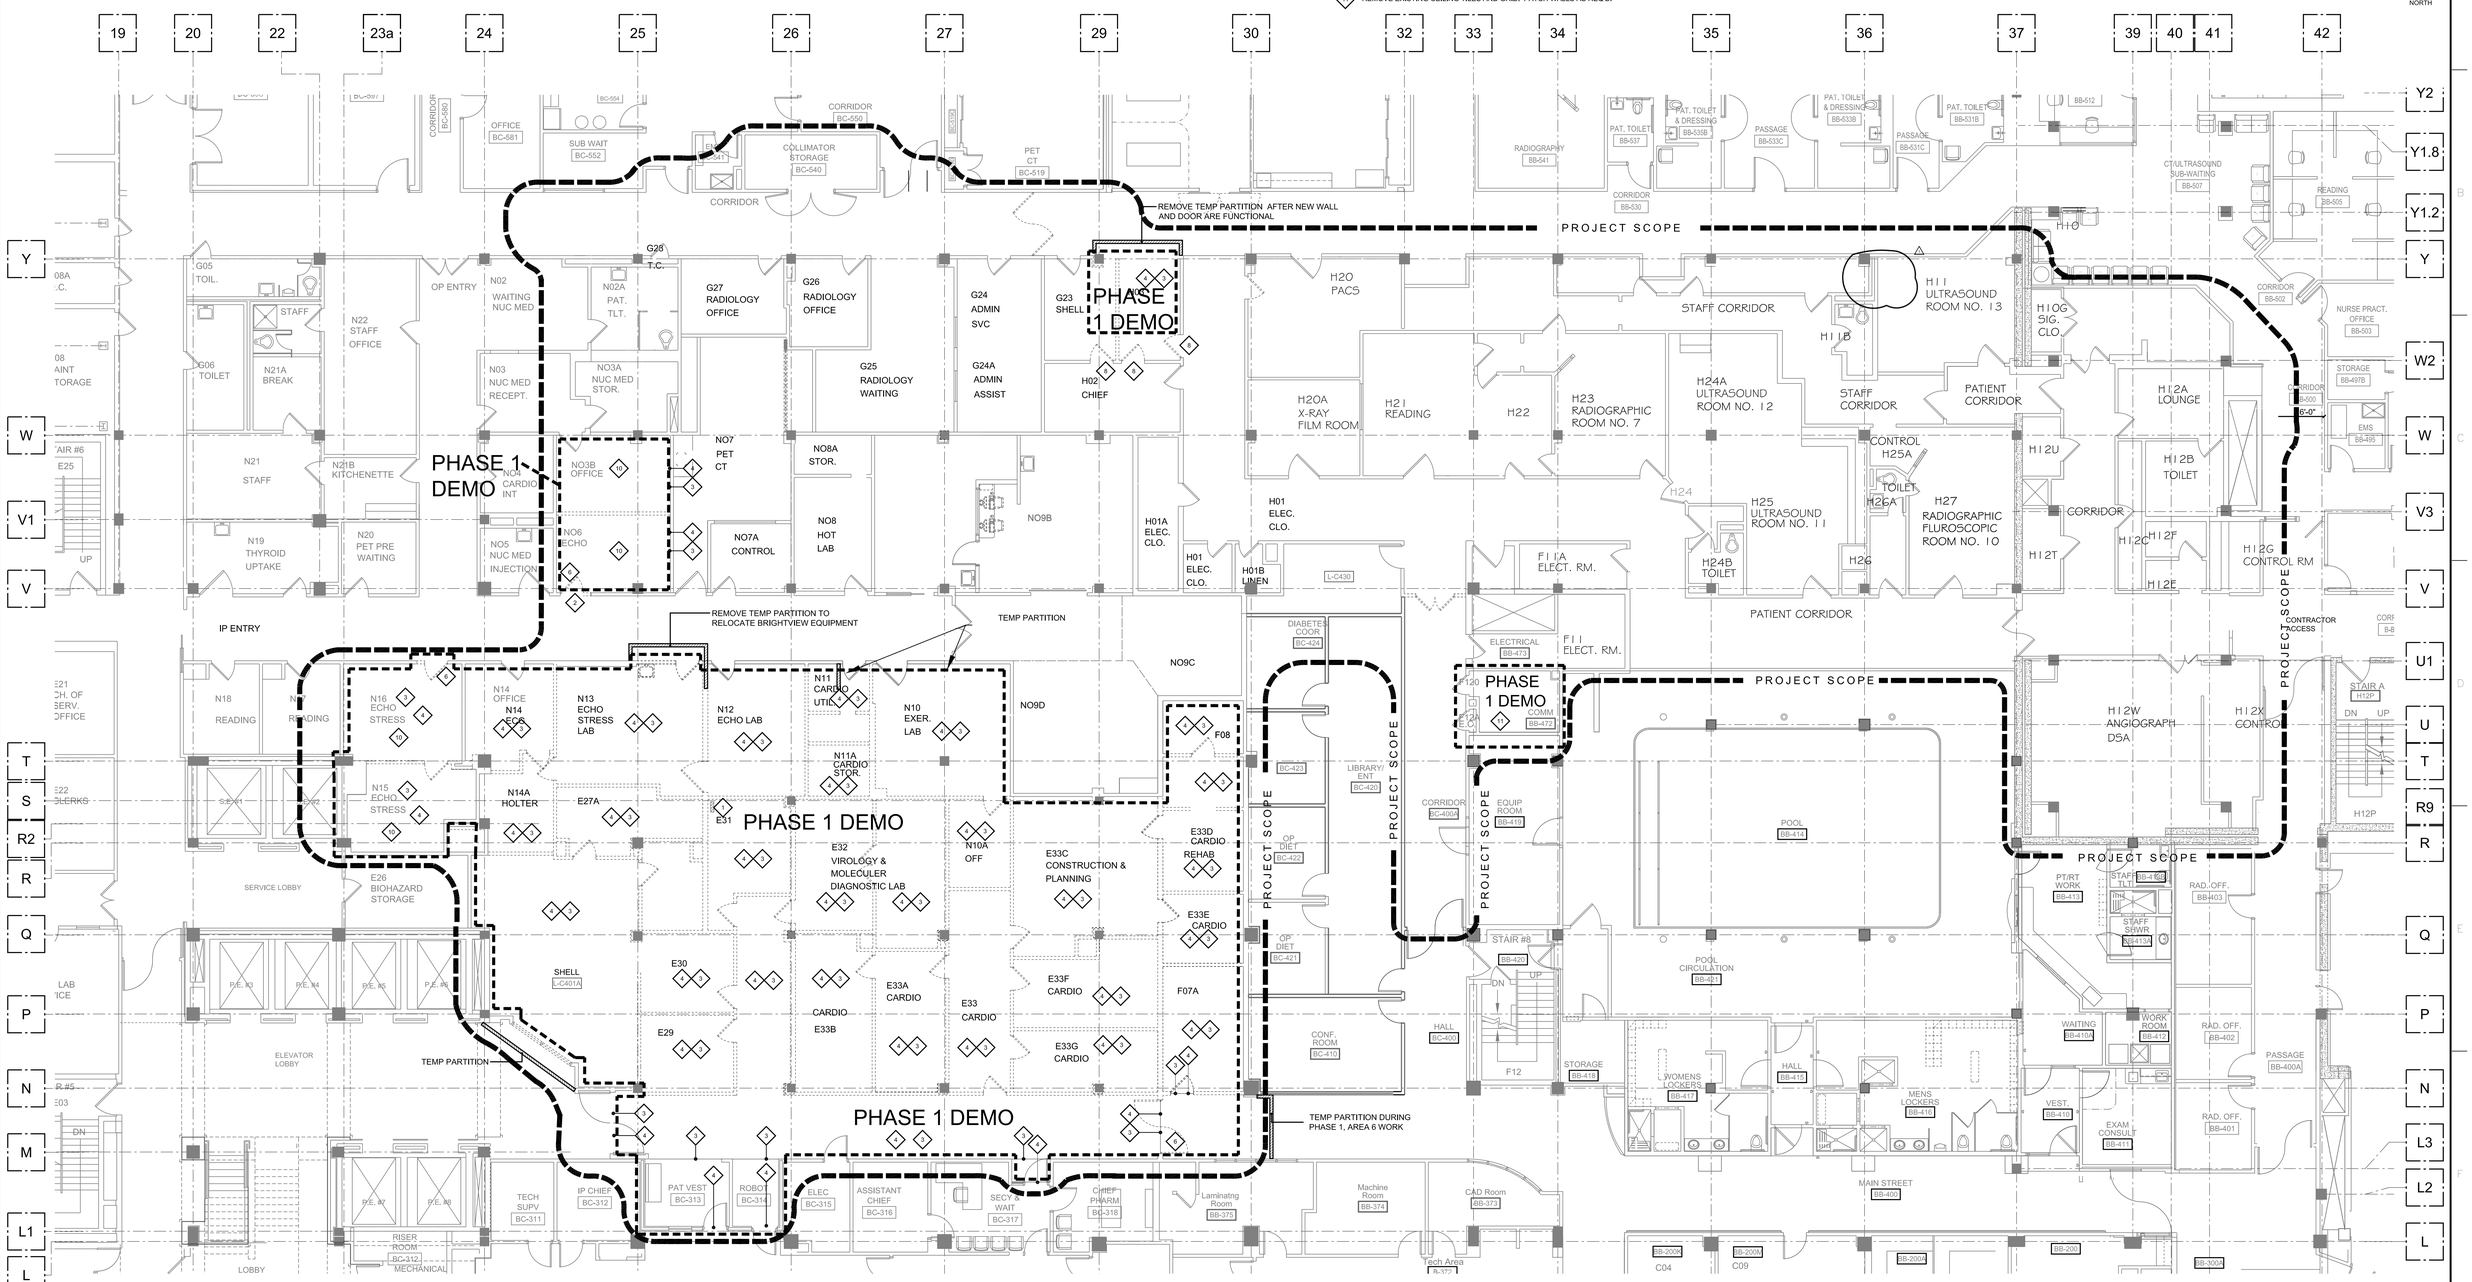

Partial Basement Floor Demolition Plan - Phase 1 (1)

Scale 1/8" = 1'-0"

FULLY SPRINKLERED

Amendment 03	1	10/21/14
Bid Issue		01/17/14
Revisions:		**Date**

CONSULTANTS:

FREDRICK, FREDRICK & HELLER ENGINEERS, INC.
672 EAST ROYALTON ROAD
BROADVIEW HTS., OHIO 44147
TEL. (440) 546-9696
FAX. (440) 546-9699

2217 East 9th Street, Suite 350
Cleveland OH 44115-1257
216-875-0100/ (F) 216-875-0111
barberhoffman.com
BARBER & HOFFMAN, INC.
Consulting Engineers

STATE OF OHIO
WILLIAM C. AYARS
7259
REGISTERED ARCHITECT

ARCHITECT:

Perspectus architecture
13212 Shaker Square Suite 204 Cleveland, Ohio 44120
P. 216.752.1800 F.216.752.3833

DESIGN AND CONSTRUCTION DOCUMENTS AS INSTRUMENTS OF SERVICE ARE GIVEN IN CONFIDENCE AND REMAIN THE PROPERTY OF PERSPECTUS ARCHITECTURE. THE USE OF THIS DESIGN AND THESE CONSTRUCTION DOCUMENTS FOR PURPOSES OTHER THAN THE SPECIFIC PROJECT NAMED HEREIN IS STRICTLY PROHIBITED WITHOUT THE EXPRESSED WRITTEN CONSENT OF PERSPECTUS ARCHITECTURE.

Drawing Title: **PARTIAL BASEMENT DEMOLITION PLAN - PHASE 1**

Approved: Project Director

Project Title: **EXPAND AND RENOVATE NUCLEAR MEDICINE AND RADIOLOGY**

Location: **VAMC - WADE PARK**

Date: 1-17-2014 | Checked: RN | Drawn: PRM

Project Number: 541-14-101

Building Number: 1

Drawing Number: **1-03.3** Dwg. of

Office of Facilities Management

Department of Veterans Affairs

VA FORM 08-6231, OCT 1978