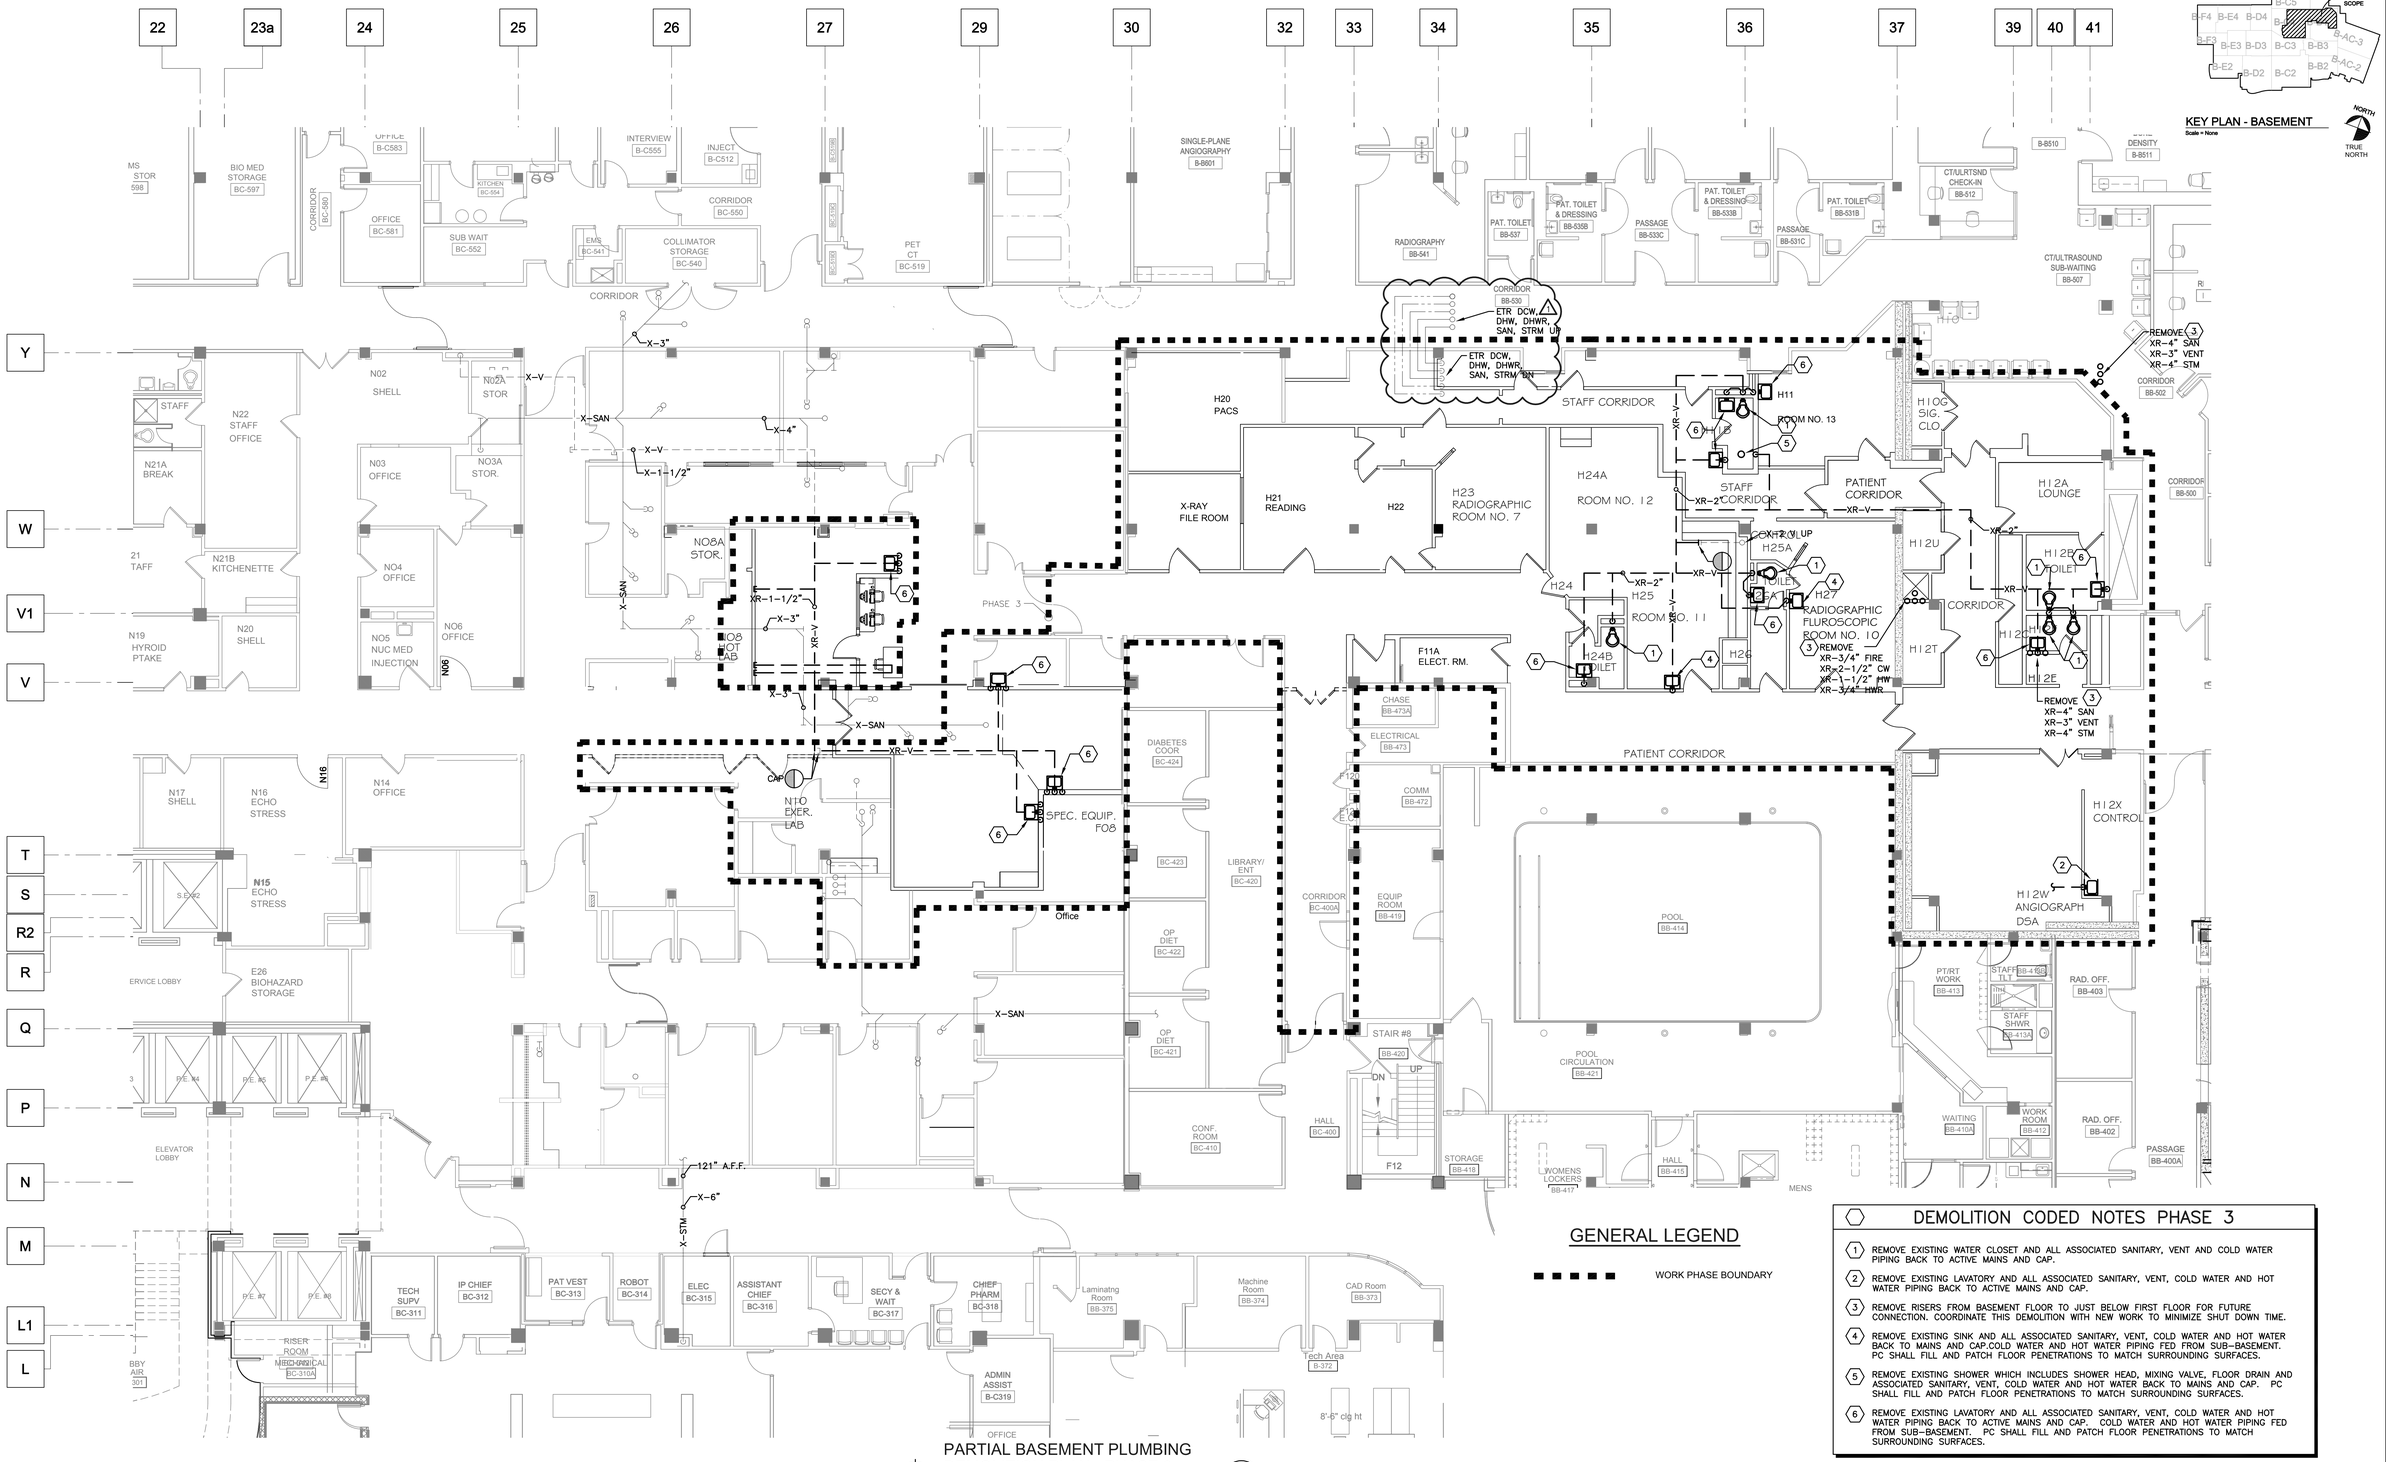

GENERAL LEGEND

WORK PHASE BOUNDARY

DEMOLITION CODED NOTES PHASE 3

1. REMOVE EXISTING WATER CLOSET AND ALL ASSOCIATED SANITARY, VENT AND COLD WATER PIPING BACK TO ACTIVE MAINS AND CAP.
2. REMOVE EXISTING LAVATORY AND ALL ASSOCIATED SANITARY, VENT, COLD WATER AND HOT WATER PIPING BACK TO ACTIVE MAINS AND CAP.
3. REMOVE RISERS FROM BASEMENT FLOOR TO JUST BELOW FIRST FLOOR FOR FUTURE CONNECTION. COORDINATE THIS DEMOLITION WITH NEW WORK TO MINIMIZE SHUT DOWN TIME.
4. REMOVE EXISTING SINK AND ALL ASSOCIATED SANITARY, VENT, COLD WATER AND HOT WATER BACK TO MAINS AND CAP.COLD WATER AND HOT WATER PIPING FED FROM SUB-BASEMENT. PC SHALL FILL AND PATCH FLOOR PENETRATIONS TO MATCH SURROUNDING SURFACES.
5. REMOVE EXISTING SHOWER WHICH INCLUDES SHOWER HEAD, MIXING VALVE, FLOOR DRAIN AND ASSOCIATED SANITARY, VENT, COLD WATER AND HOT WATER BACK TO MAINS AND CAP. PC SHALL FILL AND PATCH FLOOR PENETRATIONS TO MATCH SURROUNDING SURFACES.
6. REMOVE EXISTING LAVATORY AND ALL ASSOCIATED SANITARY, VENT, COLD WATER AND HOT WATER PIPING BACK TO ACTIVE MAINS AND CAP. COLD WATER AND HOT WATER PIPING FED FROM SUB-BASEMENT. PC SHALL FILL AND PATCH FLOOR PENETRATIONS TO MATCH SURROUNDING SURFACES.

PARTIAL BASEMENT PLUMBING DEMOLITION PLAN - PHASE 3

1

SCALE: 1/8" = 1'0"

0' 4' 8' 16' 32'

FULLY SPRINKLERED

Revisions:	Date
Amendment 03	10/21/14
Bid Issue	01/17/14

CONSULTANTS:

FREDRICK, FREDRICK & HELLER ENGINEERS, INC.
672 EAST ROYALTON ROAD
BROADVIEW HTS., OHIO 44147
TEL. (440) 546-9696
FAX: (440) 546-9699

BARBER & HOFFMAN, INC.
Consulting Engineers
2217 East 9th Street, Suite 350
Cleveland OH 44115-1257
216-875-0100/ (F) 216-875-0111
barberhoffman.com

BRIAN M. WOJCIK 69425
FFH #13027

ARCHITECT:

Perspectus architecture
13212 Shaker Square Suite 204 Cleveland, Ohio 44120
P. 216.752.1800 F.216.752.3833

DESIGN AND CONSTRUCTION DOCUMENTS AS INSTRUMENTS OF SERVICE ARE GIVEN IN CONFIDENCE AND REMAIN THE PROPERTY OF PERSPECTUS ARCHITECTURE. THE USE OF THIS DESIGN AND THESE CONSTRUCTION DOCUMENTS FOR PURPOSES OTHER THAN THE SPECIFIC PROJECT NAMED HEREIN IS STRICTLY PROHIBITED WITHOUT THE EXPRESSED WRITTEN CONSENT OF PERSPECTUS ARCHITECTURE.

Drawing Title: **PARTIAL BASEMENT PLUMBING DEMOLITION PLAN- PHASE 3**

Approved: Project Director

Project Title: **EXPAND AND RENOVATE NUCLEAR MEDICINE AND RADIOLOGY**

Location: **VAMC - WADE PARK**

Date: 1-17-2014 | Checked: BMW | Drawn: DAD

Project Number: 541-14-101

Building Number: 1

Drawing Number: **1-P2.3**

Dwg. of

Office of Facilities Management

Department of Veterans Affairs