



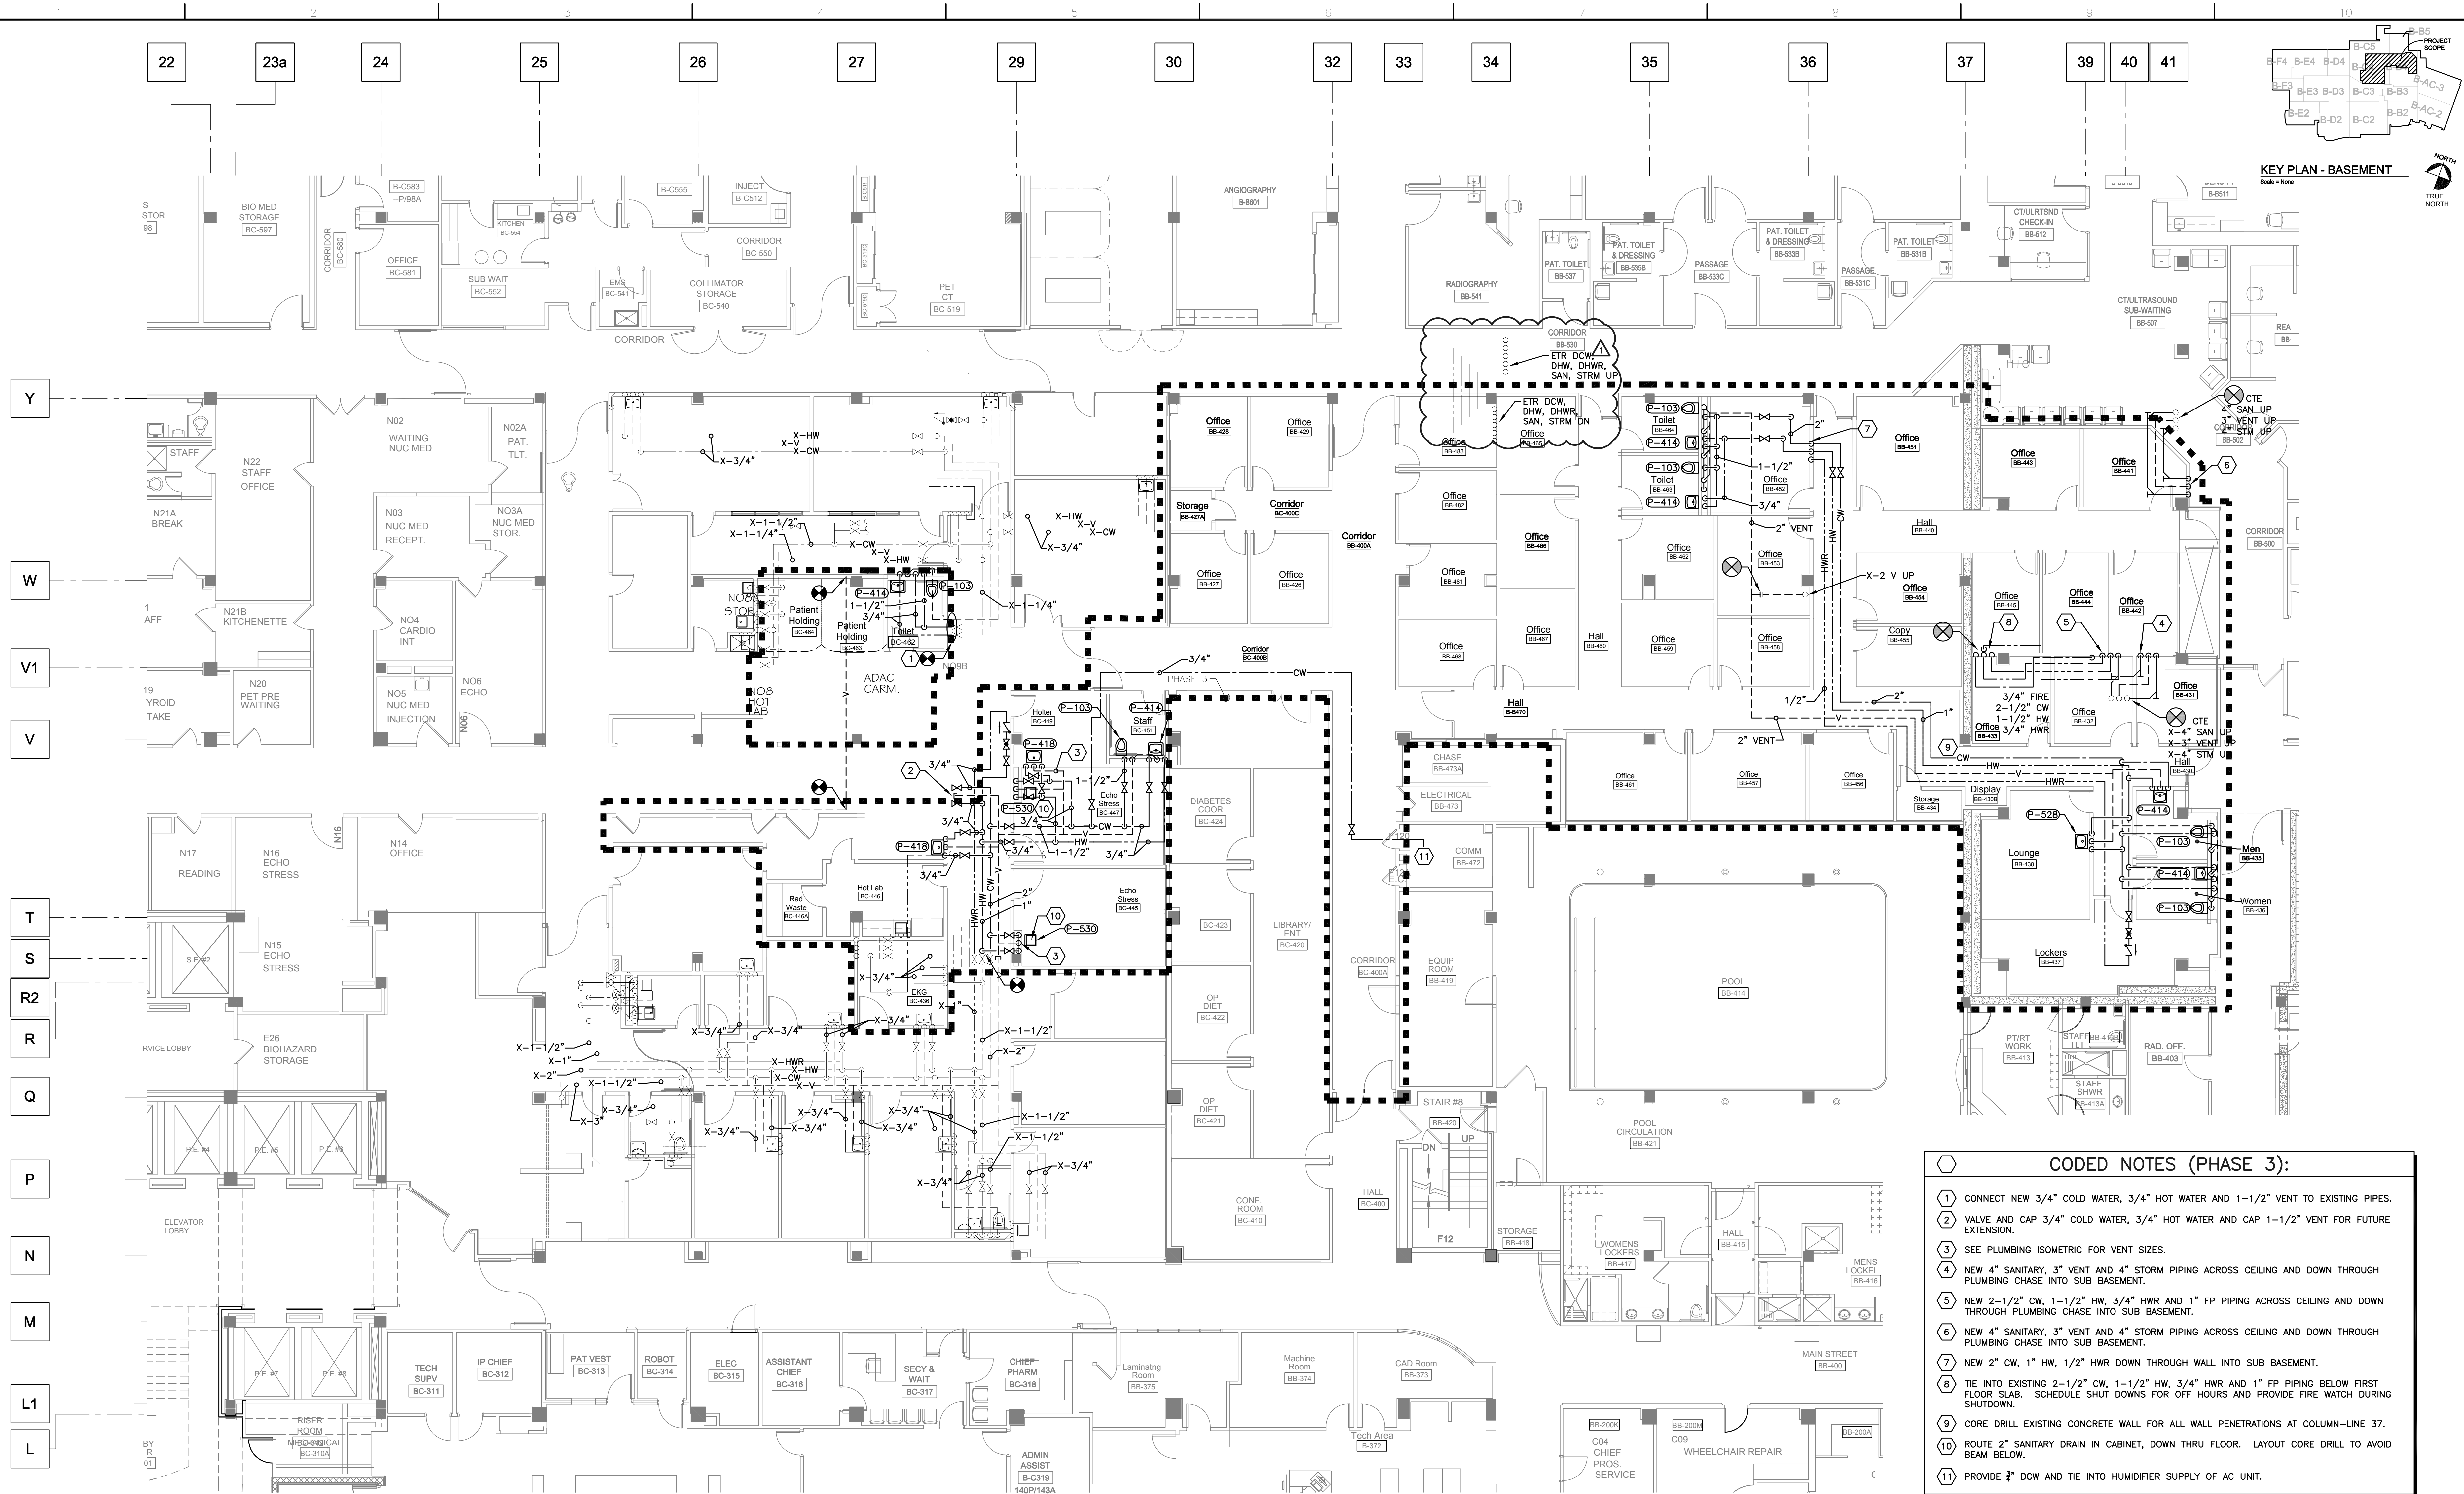

PARTIAL BASEMENT PLUMBING PLAN - PHASE 3  
SCALE: 1/8" = 1'-0"  
1

- CODED NOTES (PHASE 3):**
- CONNECT NEW 3/4" COLD WATER, 3/4" HOT WATER AND 1-1/2" VENT TO EXISTING PIPES.
  - VALVE AND CAP 3/4" COLD WATER, 3/4" HOT WATER AND CAP 1-1/2" VENT FOR FUTURE EXTENSION.
  - SEE PLUMBING ISOMETRIC FOR VENT SIZES.
  - NEW 4" SANITARY, 3" VENT AND 4" STORM PIPING ACROSS CEILING AND DOWN THROUGH PLUMBING CHASE INTO SUB BASEMENT.
  - NEW 2-1/2" CW, 1-1/2" HW, 3/4" HWR AND 1" FP PIPING ACROSS CEILING AND DOWN THROUGH PLUMBING CHASE INTO SUB BASEMENT.
  - NEW 4" SANITARY, 3" VENT AND 4" STORM PIPING ACROSS CEILING AND DOWN THROUGH PLUMBING CHASE INTO SUB BASEMENT.
  - NEW 2" CW, 1" HW, 1/2" HWR DOWN THROUGH WALL INTO SUB BASEMENT.
  - TIE INTO EXISTING 2-1/2" CW, 1-1/2" HW, 3/4" HWR AND 1" FP PIPING BELOW FIRST FLOOR SLAB. SCHEDULE SHUT DOWNS FOR OFF HOURS AND PROVIDE FIRE WATCH DURING SHUTDOWN.
  - CORE DRILL EXISTING CONCRETE WALL FOR ALL WALL PENETRATIONS AT COLUMN-LINE 37.
  - ROUTE 2" SANITARY DRAIN IN CABINET, DOWN THRU FLOOR. LAYOUT CORE DRILL TO AVOID BEAM BELOW.

<b>CONSULTANTS:</b>		<b>ARCHITECT:</b>		<b>Project Title</b>		<b>Project Number</b>		<b>Office of Facilities Management</b>	
 <b>FREDRICK, FREDRICK &amp; HELLER ENGINEERS, INC.</b> 672 EAST ROYALTON ROAD BROADVIEW HTS., OHIO 44147 TEL: (440) 546-8888 FAX: (440) 546-8889		 <b>Perspectus</b> architecture 13212 Shaker Square Suite 204 Cleveland, Ohio 44120 P. 216.752.1800 F. 216.752.3833		<b>EXPAND AND RENOVATE NUCLEAR MEDICINE AND RADIOLOGY</b>		541-14-101		<b>Department of Veterans Affairs</b>	
 <b>BARBER &amp; HOFFMAN, INC.</b> Consulting Engineers 2217 East 9th Street, Suite 350 Cleveland OH 44115-1257 216-875-0100/(F) 216-875-0111 barberhoffman.com		 <b>Brian Widowski</b> Professional Engineer FFH #13027		<b>Location</b> <b>VAMC - WADE PARK</b>		Building Number 1		<b>1-P5.3</b>	
Amendment 03 Bid Issue Revisions:		Approved: Project Director		Date 1-17-2014		Checked BMW		Dwg. of	
10/21/14 01/17/14 Date				Drawn DAD					