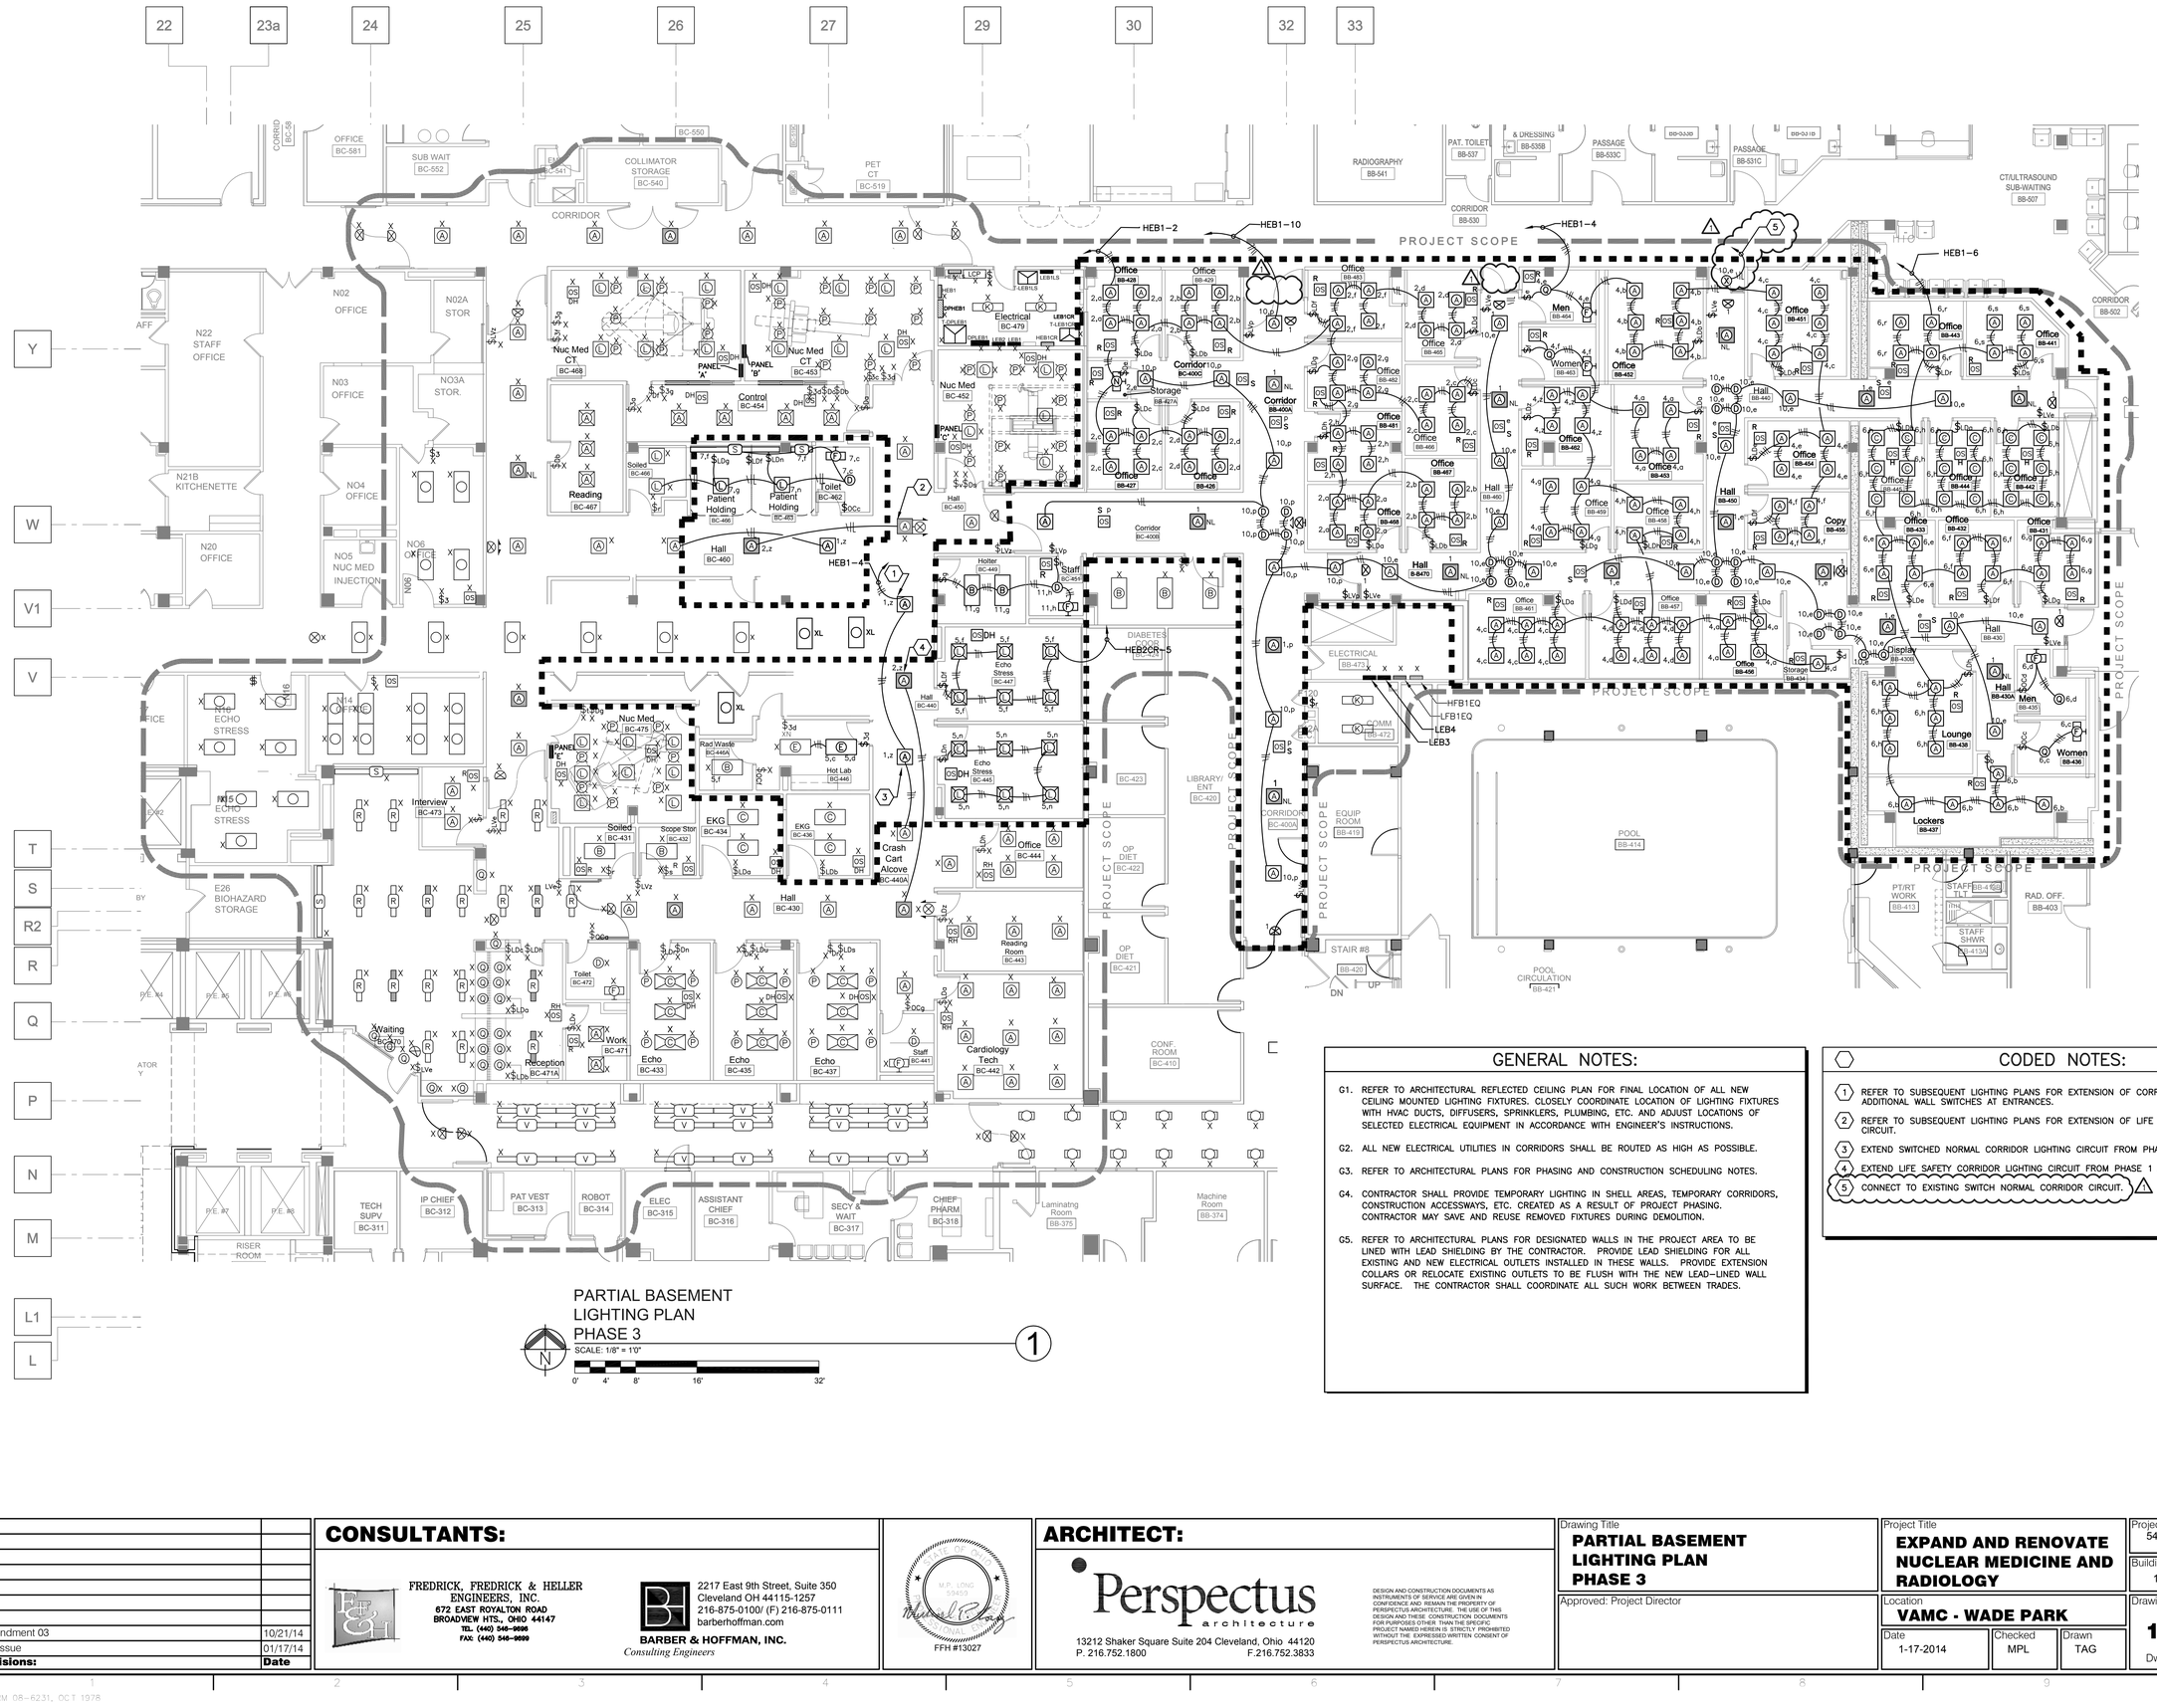

PARTIAL BASEMENT
LIGHTING PLAN
PHASE 3

SCALE: 1/8" = 1'0"

0' 4' 8' 16' 32'

1

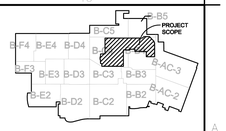

KEY PLAN - BASEMENT

Scale = None

NORTH
TRUE NORTH

GENERAL NOTES:

G1. REFER TO ARCHITECTURAL REFLECTED CEILING PLAN FOR FINAL LOCATION OF ALL NEW CEILING MOUNTED LIGHTING FIXTURES. CLOSELY COORDINATE LOCATION OF LIGHTING FIXTURES WITH HVAC DUCTS, DIFFUSERS, SPRINKLERS, PLUMBING, ETC. AND ADJUST LOCATIONS OF SELECTED ELECTRICAL EQUIPMENT IN ACCORDANCE WITH ENGINEER'S INSTRUCTIONS.

G2. ALL NEW ELECTRICAL UTILITIES IN CORRIDORS SHALL BE ROUTED AS HIGH AS POSSIBLE.

G3. REFER TO ARCHITECTURAL PLANS FOR PHASING AND CONSTRUCTION SCHEDULING NOTES.

G4. CONTRACTOR SHALL PROVIDE TEMPORARY LIGHTING IN SHELL AREAS, TEMPORARY CORRIDORS, CONSTRUCTION ACCESSWAYS, ETC. CREATED AS A RESULT OF PROJECT PHASING. CONTRACTOR MAY SAVE AND REUSE REMOVED FIXTURES DURING DEMOLITION.

G5. REFER TO ARCHITECTURAL PLANS FOR DESIGNATED WALLS IN THE PROJECT AREA TO BE LINED WITH LEAD SHIELDING BY THE CONTRACTOR. PROVIDE LEAD SHIELDING FOR ALL EXISTING AND NEW ELECTRICAL OUTLETS INSTALLED IN THESE WALLS. PROVIDE EXTENSION COLLARS OR RELOCATE EXISTING OUTLETS TO BE FLUSH WITH THE NEW LEAD-LINED WALL SURFACE. THE CONTRACTOR SHALL COORDINATE ALL SUCH WORK BETWEEN TRADES.

CODED NOTES:

1. REFER TO SUBSEQUENT LIGHTING PLANS FOR EXTENSION OF CORRIDOR LIGHTING CIRCUIT AND ADDITIONAL WALL SWITCHES AT ENTRANCES.
2. REFER TO SUBSEQUENT LIGHTING PLANS FOR EXTENSION OF LIFE SAFETY CORRIDOR LIGHTING CIRCUIT.
3. EXTEND SWITCHED NORMAL CORRIDOR LIGHTING CIRCUIT FROM PHASE 2 AREA.
4. EXTEND LIFE SAFETY CORRIDOR LIGHTING CIRCUIT FROM PHASE 1 AREA.
5. CONNECT TO EXISTING SWITCH NORMAL CORRIDOR CIRCUIT. ⚠

FULLY SPRINKLERED

Revisions:	Date
Amendment 03	10/21/14
Bid Issue	01/17/14

CONSULTANTS:

FREDRICK, FREDRICK & HELLER ENGINEERS, INC.
672 EAST ROYALTON ROAD
BROADVIEW HTS., OHIO 44147
TEL. (440) 546-9696
FAX: (440) 546-9699

BARBER & HOFFMAN, INC.
Consulting Engineers
2217 East 9th Street, Suite 350
Cleveland OH 44115-1257
216-875-0100/ (F) 216-875-0111
barberhoffman.com

FFH #13027

ARCHITECT:

Perspectus architecture
13212 Shaker Square Suite 204 Cleveland, Ohio 44120
P. 216.752.1800 F.216.752.3833

DESIGN AND CONSTRUCTION DOCUMENTS AS INSTRUMENTS OF SERVICE ARE GIVEN IN CONFIDENCE AND REMAIN THE PROPERTY OF PERSPECTUS ARCHITECTURE. THE USE OF THIS DESIGN AND THESE CONSTRUCTION DOCUMENTS FOR PURPOSES OTHER THAN THE SPECIFIC PROJECT NAMED HEREIN IS STRICTLY PROHIBITED WITHOUT THE EXPRESSED WRITTEN CONSENT OF PERSPECTUS ARCHITECTURE.

Drawing Title: **PARTIAL BASEMENT LIGHTING PLAN PHASE 3**

Approved: Project Director

Project Title: **EXPAND AND RENOVATE NUCLEAR MEDICINE AND RADIOLOGY**

Location: **VAMC - WADE PARK**

Date: 1-17-2014 | Checked: MPL | Drawn: TAG

Project Number: 541-14-101

Building Number: 1

Drawing Number: **1-E4.3**

Dwg. of

Office of Facilities Management

Department of Veterans Affairs

VA FORM 08-6231, OCT 1978