


REVISIONS				
ZONE	REV	DESCRIPTION	DATE	APPROVED
	1	Revised work in IT Closets to show number of receptacles required. Added IT18: Room B2-152.	11/05/14	SR

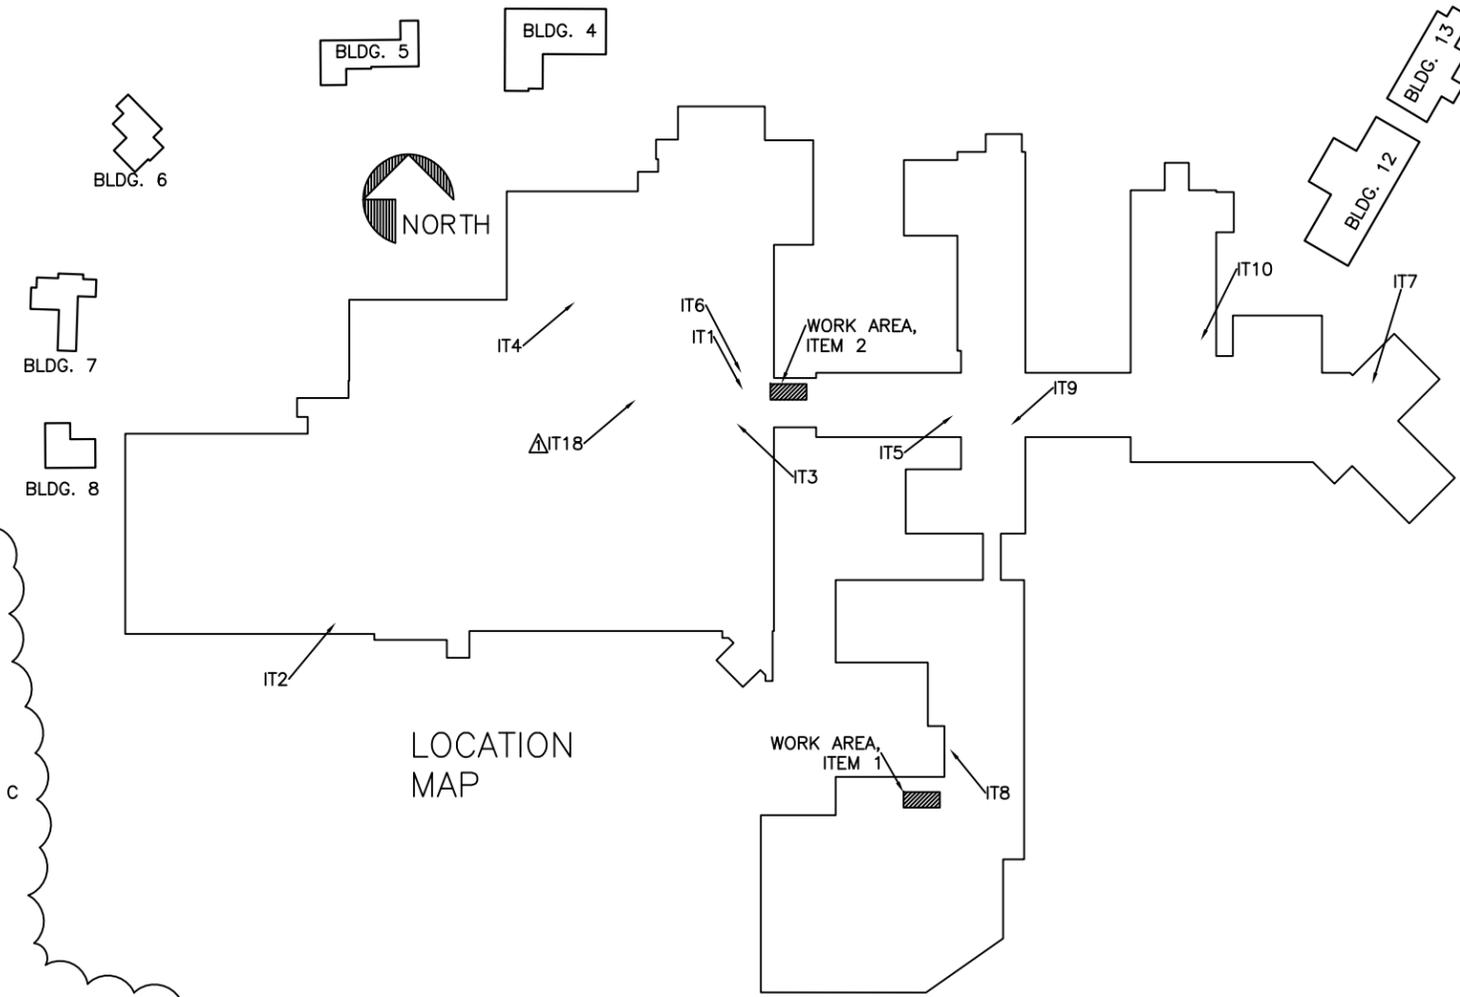

**WORK ITEM 3. UPGRADE IT CLOSETS:**

IT1: Room BL-70, Basement: A(2), B, C  
 IT2: Room A1-26, 1st Floor: A(2)  
 IT3: Room B1-103, 1st Floor: B, C  
 IT4: Room B1-112, 1st Floor: B, C  
 IT4: Room C1-41, 1st Floor: A(1), B, C  
 IT5: Room B2-93, 2nd Floor: A(2), C  
 IT6: Room C2-15, 2nd Floor: A(2)  
 IT7: Room C2-119, 2nd Floor: A(2), C  
 IT8: Room D2-36, 2nd Floor: A(2)  
 IT9: Room C3-61, 3rd Floor: B, C  
 IT10: Room C3-73B, 3rd Floor: A(1), B, C  
 IT11: Building 4: A(1)  
 IT12: Building 5: A(1)  
 IT13: Building 6: A(1)  
 IT14: Building 7: A(1)  
 IT15: Building 8: A(1)  
 IT16: Building 12: A(1)  
 IT17: Building 13: A(1)  
 IT18: Room B2-152, 2nd Floor: A(2), C

A - Install L5-30R Receptacle, 10 AWG Conductor & Conduit from Electrical Room to IT Closet and New 30 Amp Breaker in Electrical Panel. Number in parenthesis represents number of receptacles required for that room.  
 B - HVAC  
 C - Provide and install 24" x 5" security louver in existing door.

DEPARTMENT OF VETERAN AFFAIRS VETERANS HEALTH ADMINISTRATION			
DENTAL, STAIRWAY, IT CLOSETS PROJECT			
DATE: OCTOBER 2014	SIZE: FSDM NO.	SHEET TITLE: LOCATION PLAN	REV
SCALE: NO SCALE		SHEET 2 OF 3	