


REVISIONS				
ZONE	REV	DESCRIPTION	DATE	APPROVED
	⚠	Revised work in IT Closets to show number of receptacles required. Added IT18: Room B2-152.	11/05/14	SR
	⚠	Room B2-93 number changed to B2-152. Removed IT18 from revision 1. Corrected designation for room C2-15 to IT6.	11/13/14	SR

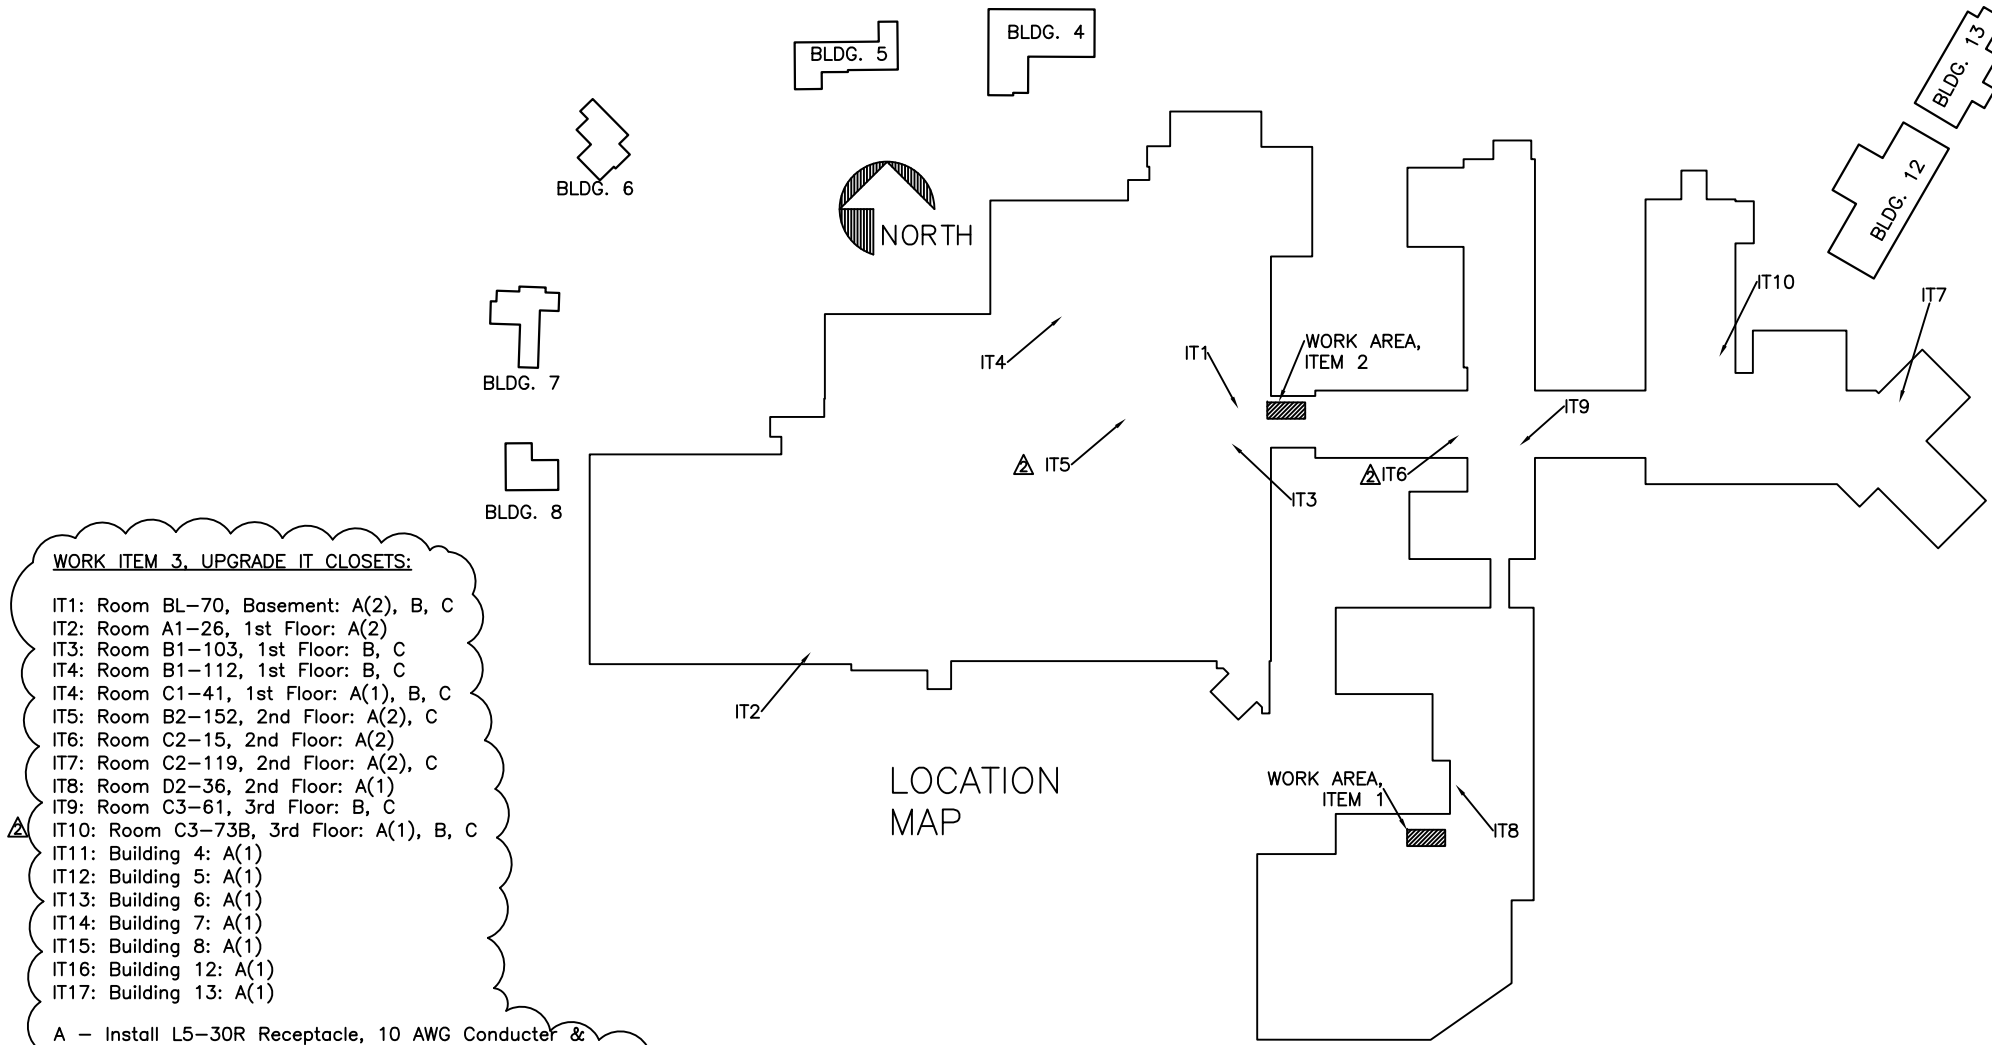

WORK ITEM 3. UPGRADE IT CLOSETS:

IT1: Room BL-70, Basement: A(2), B, C
IT2: Room A1-26, 1st Floor: A(2)
IT3: Room B1-103, 1st Floor: B, C
IT4: Room B1-112, 1st Floor: B, C
IT4: Room C1-41, 1st Floor: A(1), B, C
IT5: Room B2-152, 2nd Floor: A(2), C
IT6: Room C2-15, 2nd Floor: A(2)
IT7: Room C2-119, 2nd Floor: A(2), C
IT8: Room D2-36, 2nd Floor: A(1)
IT9: Room C3-61, 3rd Floor: B, C
IT10: Room C3-73B, 3rd Floor: A(1), B, C
IT11: Building 4: A(1)
IT12: Building 5: A(1)
IT13: Building 6: A(1)
IT14: Building 7: A(1)
IT15: Building 8: A(1)
IT16: Building 12: A(1)
IT17: Building 13: A(1)

A - Install L5-30R Receptacle, 10 AWG Conductor & Conduit from Electrical Room to IT Closet and New 30 Amp Breaker in Electrical Panel. Number in parenthesis represents number of receptacles required for that room.
B - HVAC
C - Provide and install 24" x 5" security louver in existing door.

DEPARTMENT OF VETERAN AFFAIRS VETERANS HEALTH ADMINISTRATION			
DENTAL, STAIRWAY, IT CLOSETS PROJECT			
DATE: OCTOBER 2014	SIZE	FSOM NO.	REV
SCALE: NO SCALE		SHEET 2 OF 3	