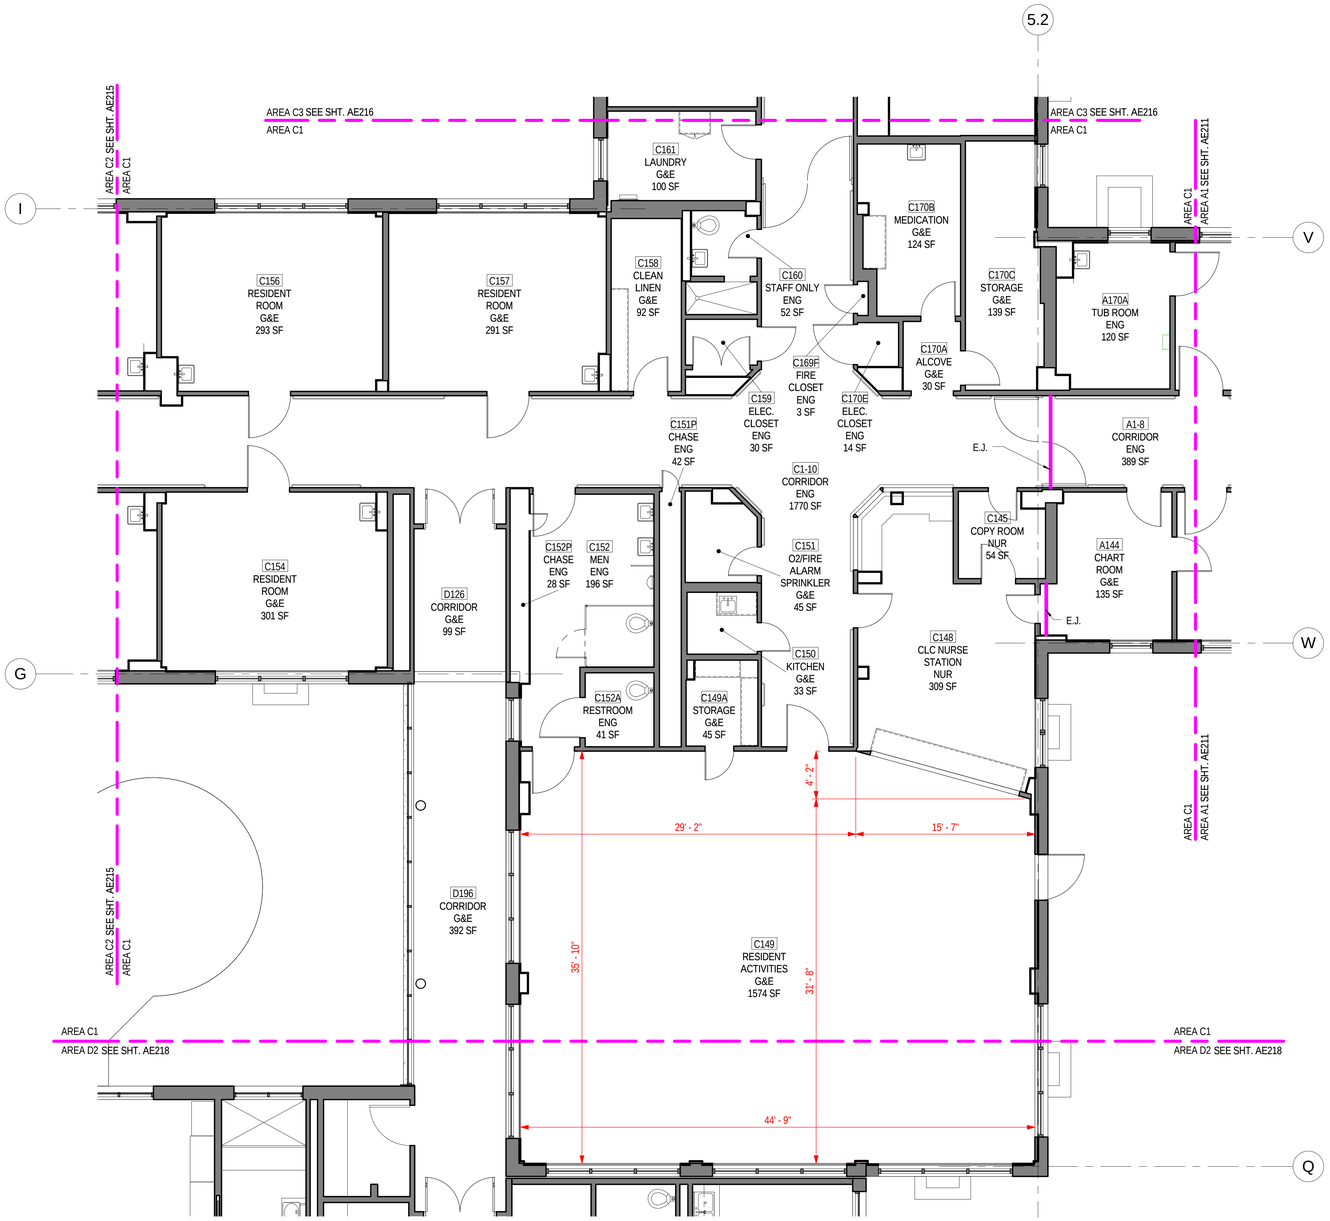

1 LEVEL 1 - AREA C1
3/16" = 1'-0"

No.	Description	Date
0	100% SUBMITTAL	01/21/2014

ARCHITECTS/ENGINEERS:

Burns & McDonnell SINCE 1898

9400 Ward Parkway
Kansas City, MO 64114
Phone: (816) 333-9400
Fax: (816) 822-3321
http://burnsmcd.com

Building Key Plan:

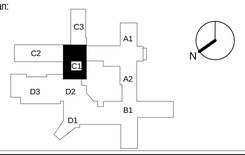

FACILITIES MANAGEMENT
FLOOR PLAN DRAWINGS

- FOR REFERENCE ONLY -
NOT FOR
CONSTRUCTION

VA EASTERN KANSAS HEALTH CARE SYSTEM

Dwight D. Eisenhower VA Medical Center, Leavenworth
Colmery-O'Neil VA Medical Center, Topeka

Drawing Title: **LEVEL 1 - AREA C1**

Scale: **3/16" = 1'-0"**

Approved:

Project Title: **VA RTLS COMMUNITY LIVING CENTER**

Building Number: **6** | Checked By: **AS** | Drawn By: **TC**

Location: Colmery-O'Neil VA Medical Center, Topeka

Date: 01/21/2014

Project No. **74344**

Drawing No. **AE214**

Dwg. Of

Department of Veterans Affairs

S:\ENGINEERING SERVICE LINE\Building Data & AutoCAD Drawings\Topeka\Master REVIT-CAD-PDF Files Only\Building 006\Export\2014-11-12 BIM\Bldg 6.rvt