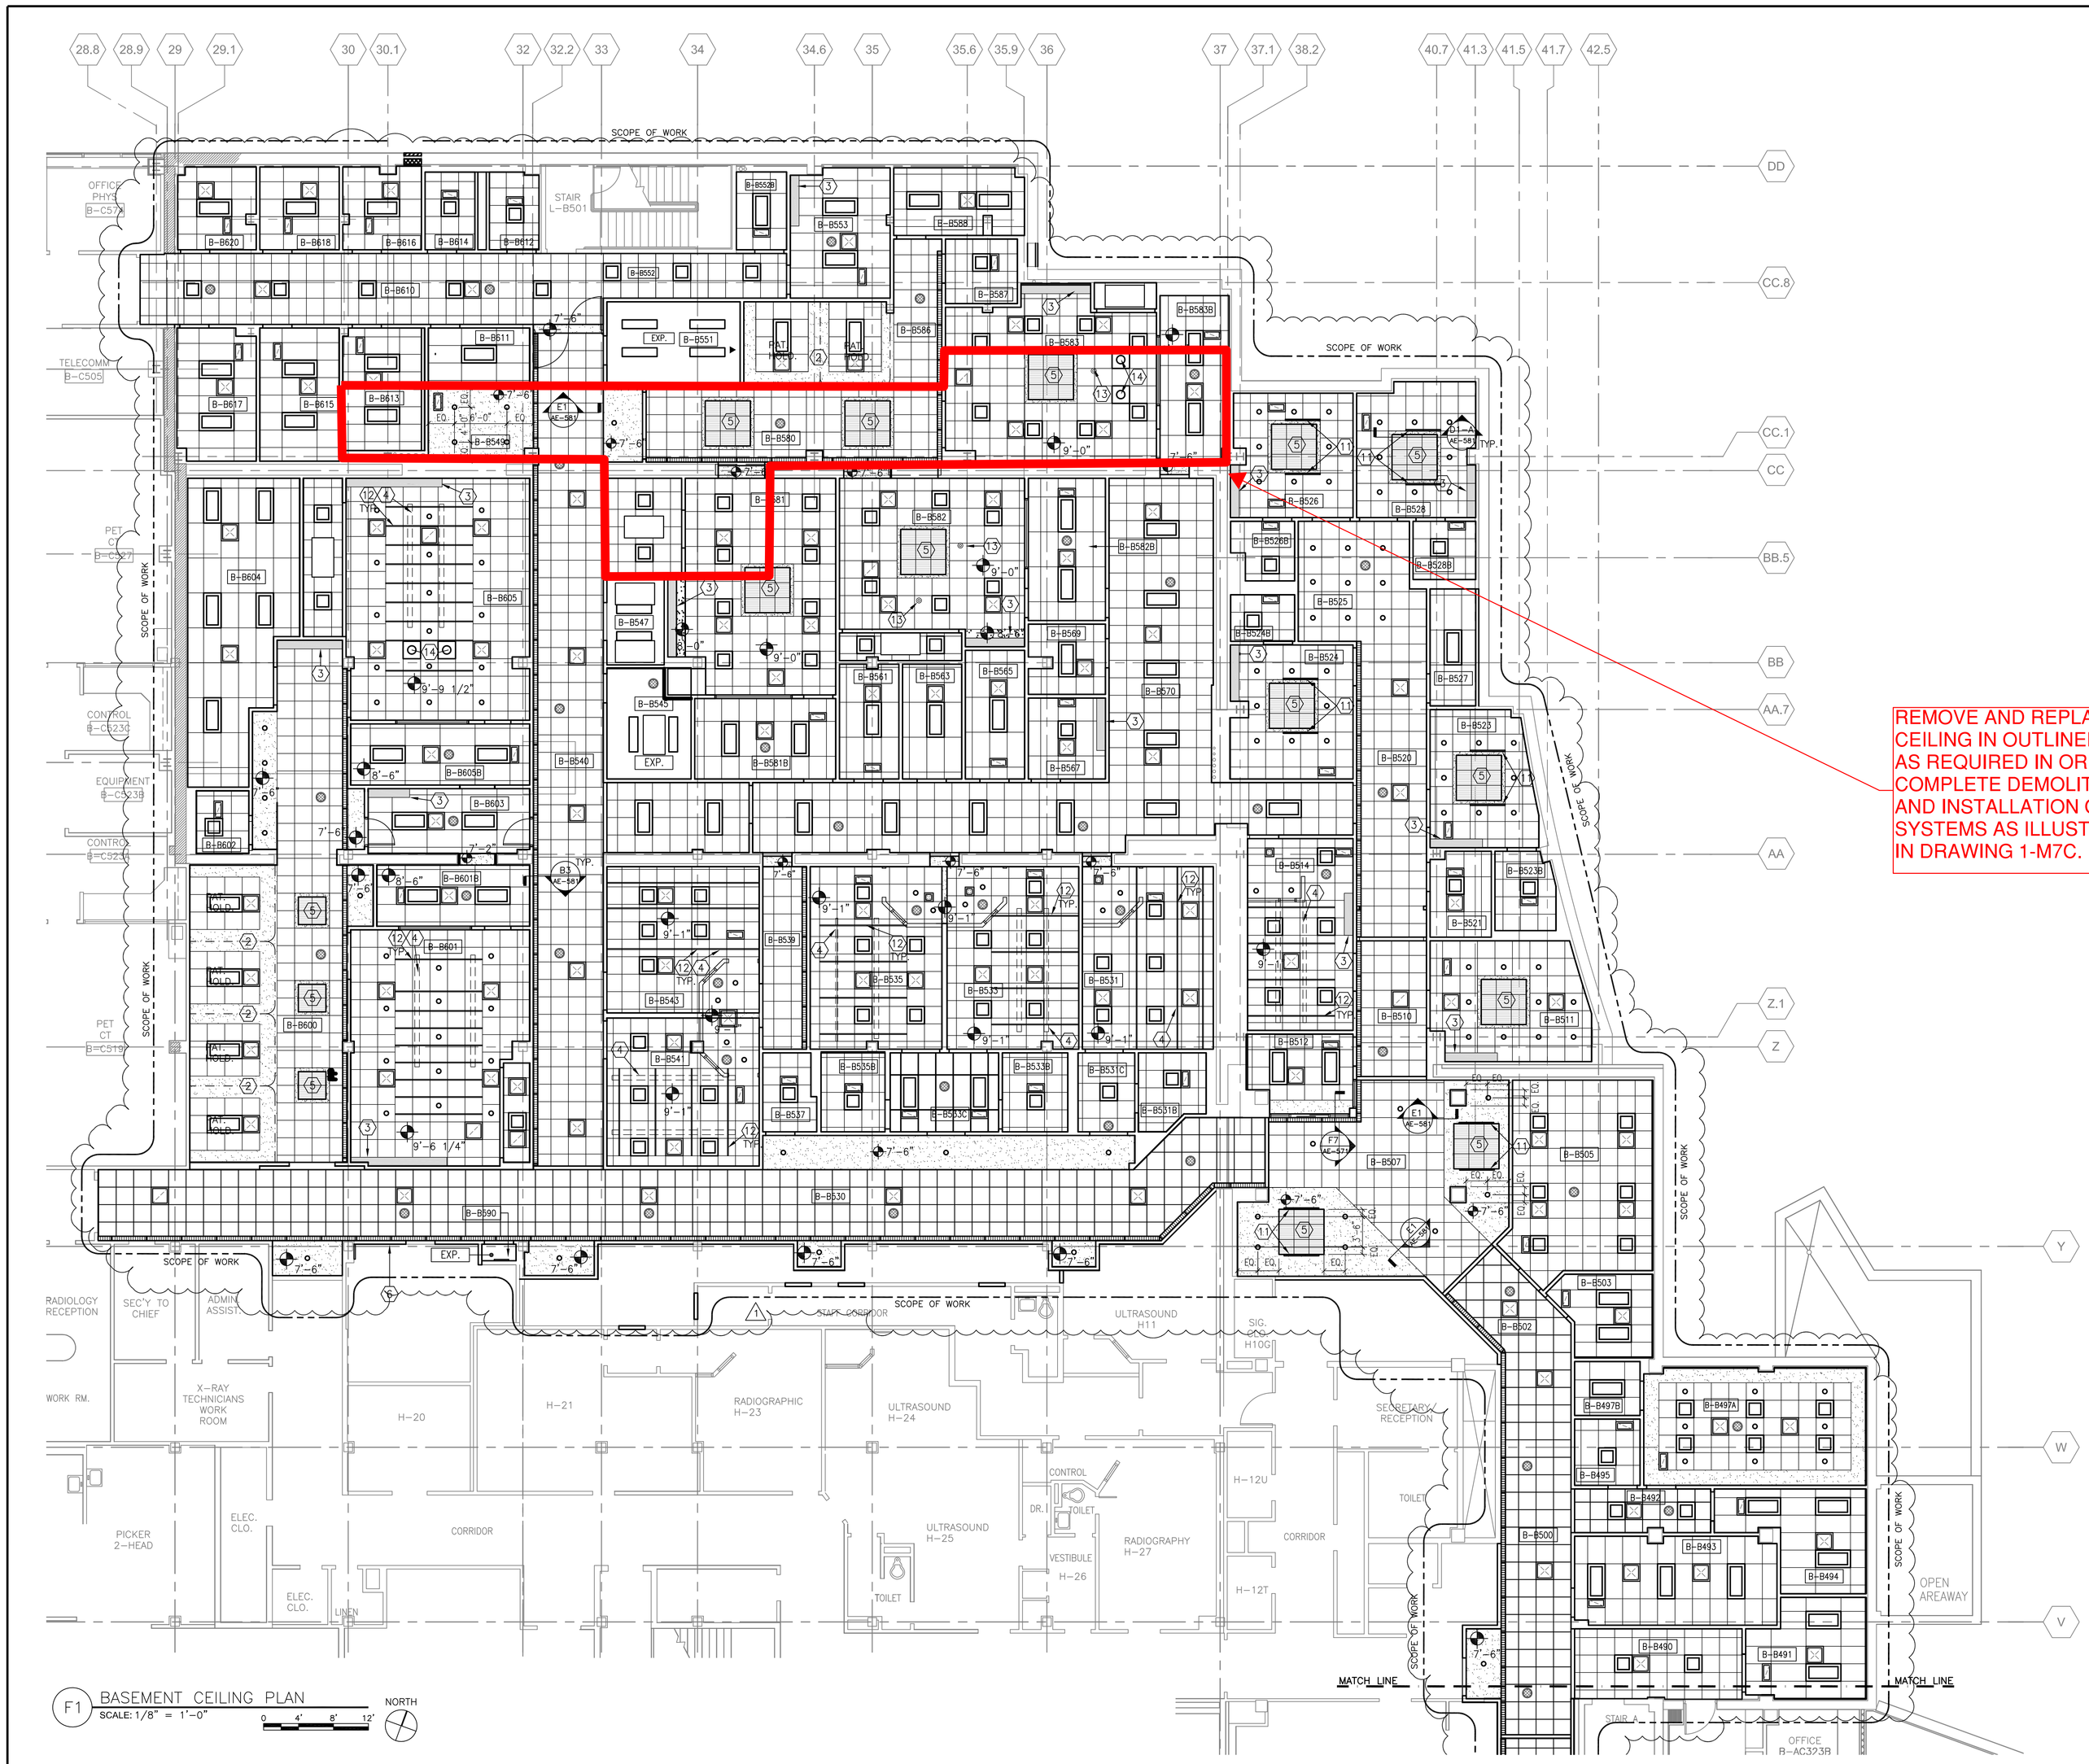

F1 BASEMENT CEILING PLAN
SCALE: 1/8" = 1'-0"

NOTES:

GENERAL NOTES

A. ALL CEILINGS ARE TO BE CENTERED IN ROOMS IN BOTH DIRECTIONS UNLESS OTHERWISE NOTED.
B. ALL CEILING HEIGHTS ARE 8'-0" A.F.F. UNLESS OTHERWISE NOTED.
C. UNLESS OTHERWISE NOTED, CENTER AND/OR EDGE ALIGN ALL CEILING MOUNTED LUMINARES, DIFFUSERS, EQUIPMENT IN CEILING TILES AS INDICATED GRAPHICALLY.
D. REFER TO ELECTRICAL FOR LIGHT FIXTURE DESCRIPTIONS AND ALL CEILING MOUNTED DEVICES.
E. REFER TO MECHANICAL FOR DIFFUSER DESCRIPTIONS
F. REFER TO TECHNOLOGY FOR IDENTIFICATION AND DESCRIPTION OF CEILING MOUNTED EQUIPMENT.
G. REFER TO FIRE PROTECTION FOR CEILING MOUNTED LIFE SAFETY RELATED LIGHTING AND EQUIPMENT.
H. CONFIRM CEILING HEIGHTS IN PROCEDURE ROOMS w/ EQUIPMENT MANUFACTURERS.
I. CONFIRM/COORDINATE LOCATIONS OF CEILING MOUNTED RAILS AND EQUIPMENT WITH IMAGING EQUIPMENT MANUFACTURER.

RCP KEYNOTES

1. NOT USED
2. CURTAIN TRACK. (V.V)
3. GYPSUM BOARD SOFFIT ABOVE WALL CABINETS.
4. CEILING MOUNTED EQUIPMENT RAILS, PROVIDED AND INSTALLED BY EQUIPMENT VENDOR.
5. BACK-LIT, DECORATIVE PANELS.
6. PATCH CEILING TO MATCH EXIST. AS NECESSARY AT LOCATION OF NEW WALL.
7. PARTIAL HEIGHT WALL BELOW.
8. ALIGN EDGE OF GYP. BD. CEILING WITH FACE OF WALL.
9. NOT USED
10. RECESSED, ADJUSTABLE EXAM LIGHT.
11. LINEAR DIFFUSER; REFER TO MECHANICAL.
12. MEDICAL SUPPORT SYSTEM: COORDINATE WITH IMAGERY EQUIPMENT. REFER TO DETAIL C7/AE-581.
13. CEILING MOUNTED EQUIPMENT: PROVIDE MEDICAL SUPPORT SYSTEM. COORDINATE WITH IMAGING EQUIPMENT.
14. EXAM LIGHT: PROVIDE MEDICAL SUPPORT SYSTEM.

RCP LEGEND

EXP	EXPOSED CONSTRUCTION
	LAY IN CEILING
	GYPSUM BOARD SOFFIT/CEILING
	CEILING MOUNTED LUMINAIRE
	CEILING RECESSED LUMINAIRE
	COVE LUMINAIRE
	SURFACE MOUNTED LUMINAIRE
	SPRINKLER HEAD
	SUPPLY AIR DEVICE
	RETURN/EXHAUST AIR DEVICE
	CEILING MOUNTED SPEAKER

KEY PLAN NTS — PLAN NORTH

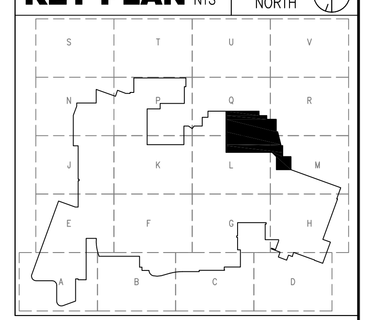

FULLY SPRINKLERED

Revisions:	Date
AMENDMENT 2	8/31/12

CONSULTANTS:

ARCHITECT/ENGINEERS:

Drawing Title: **BASEMENT REFLECTED CEILING PLAN**
Approved: Project Director
Project Title: Wade Park — Radiology North
Location: Cleveland, Ohio
Date: 11-17-14
Checked:
Drawn:
Project Number: 541-10-1003
Building Number: 1
Drawing Number: MSK-1 (Ref. 1-M7C)

Office of Facilities Management
Department of Veterans Affairs

VA FORM 08-6231, OCT 1978