


80" Drop  
6'-6" Drop  
30" Stepup

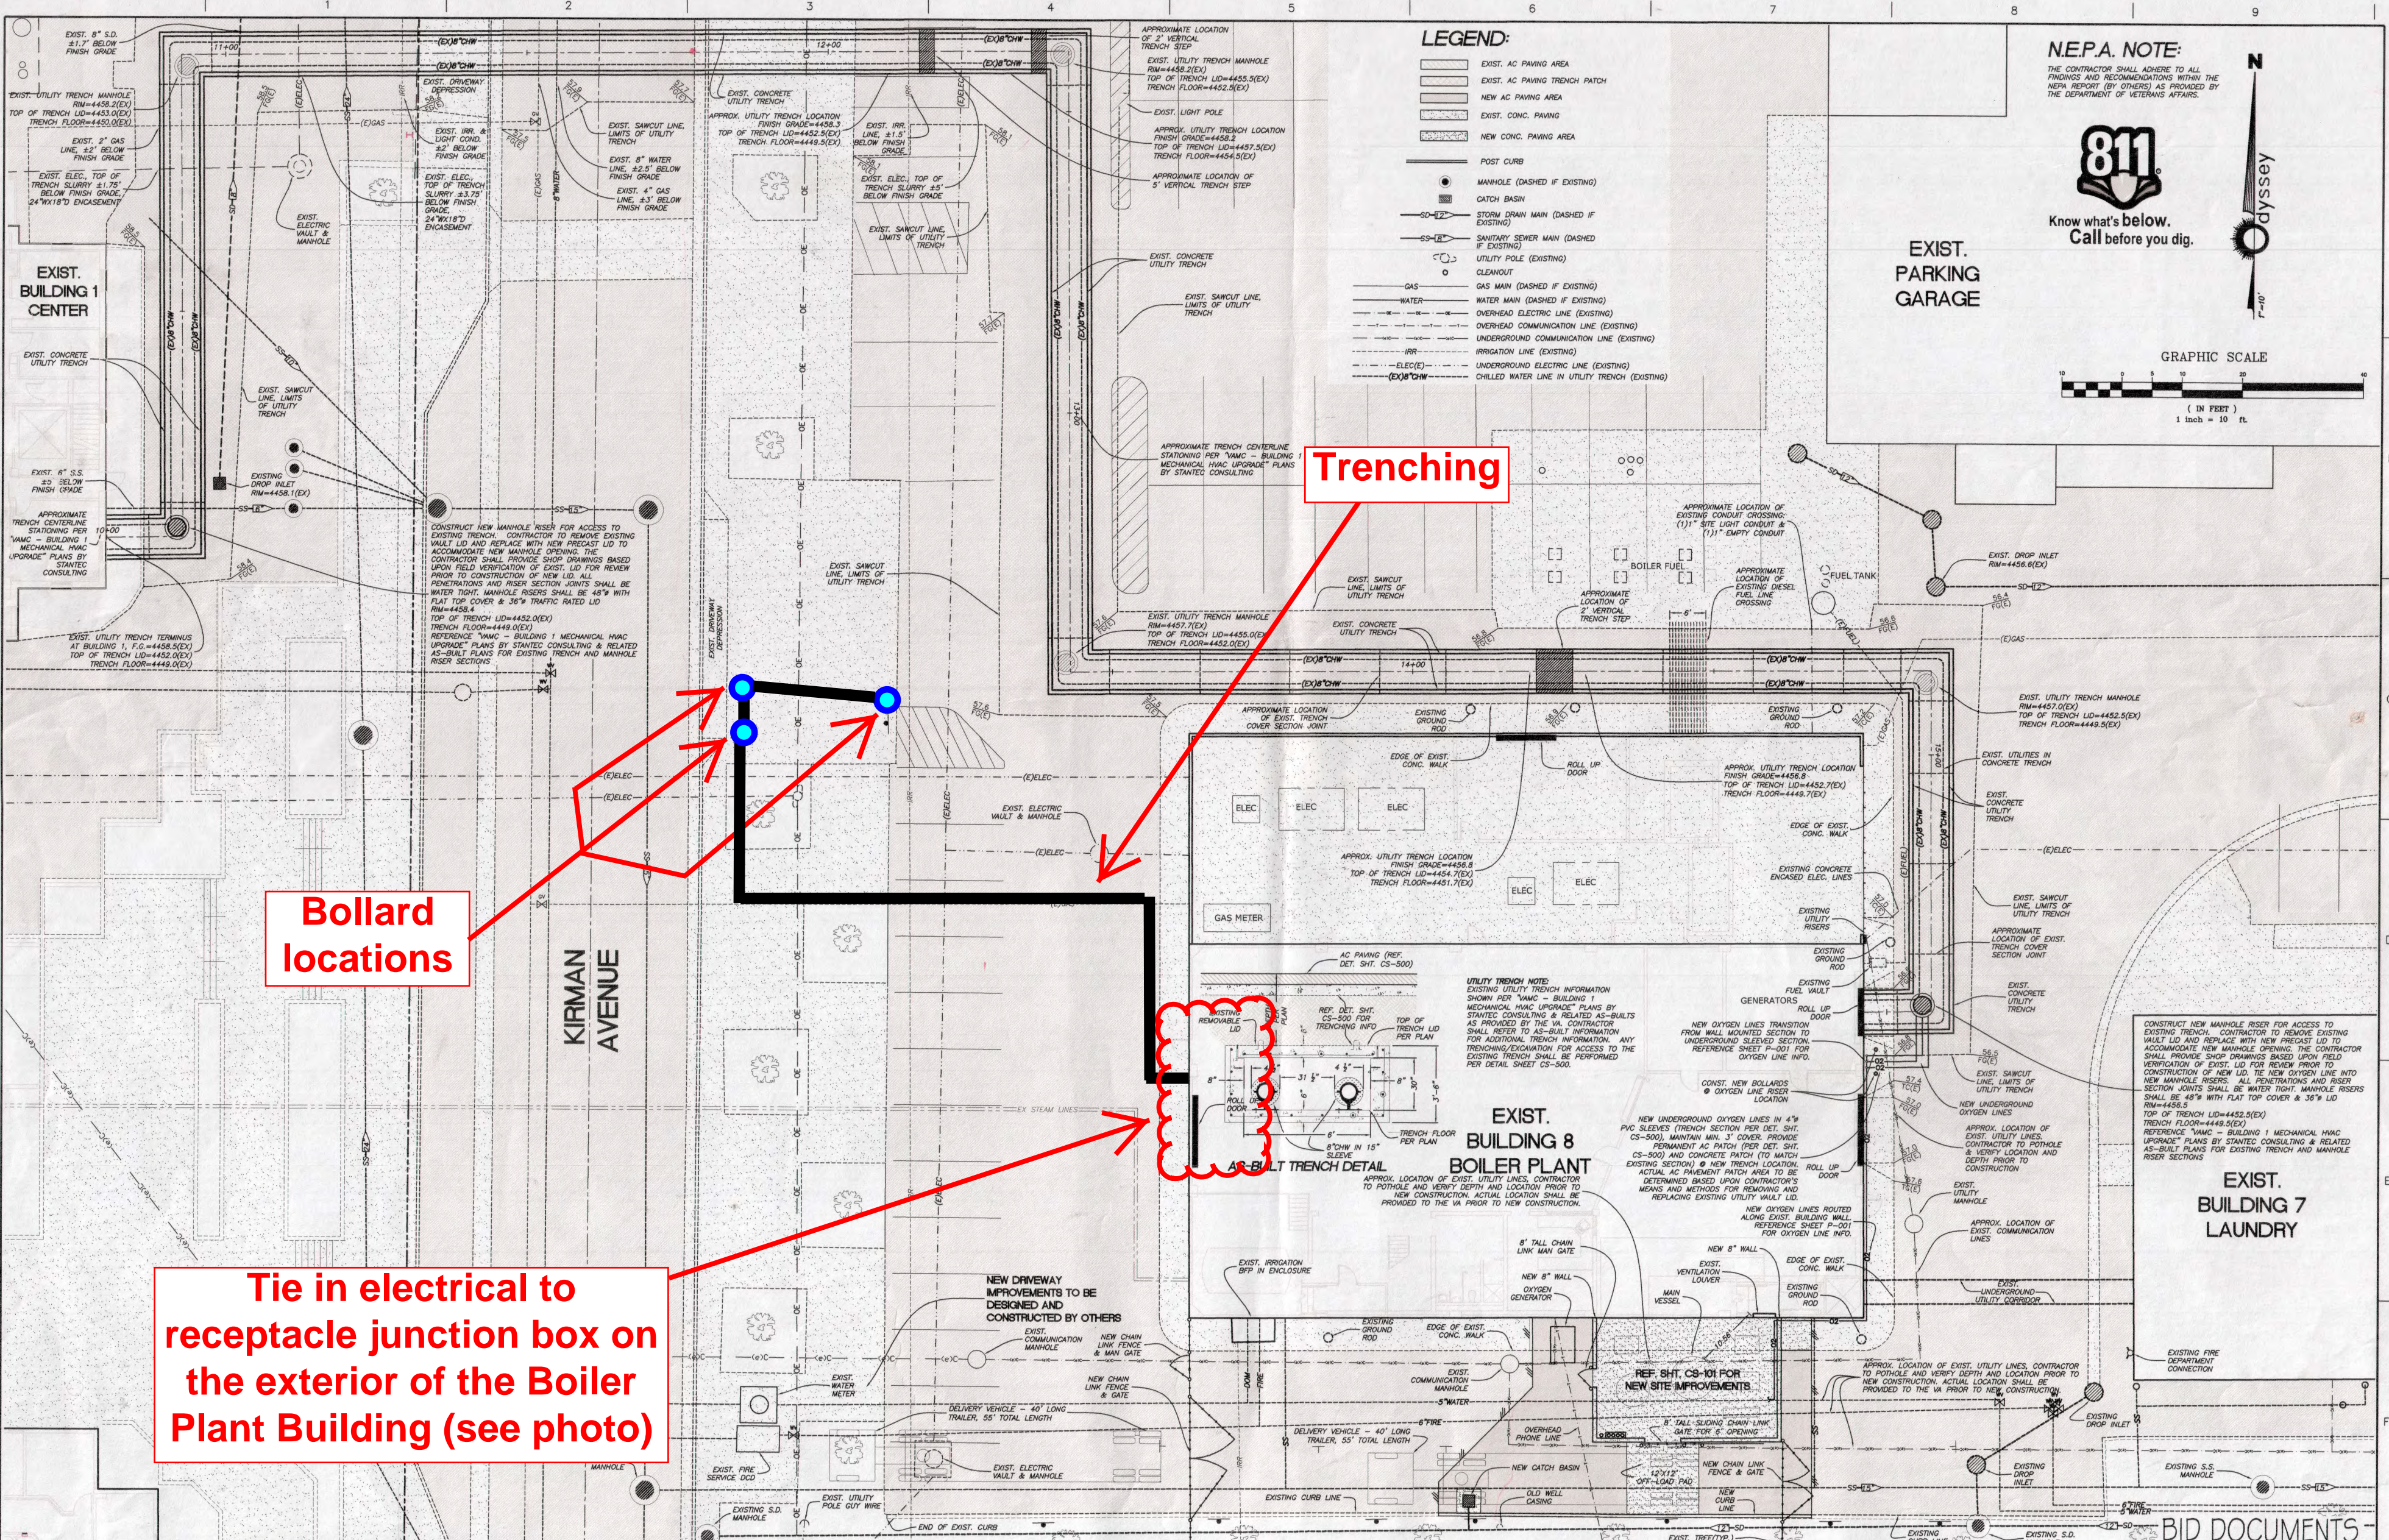

**Tie in electrical to receptacle junction box on the exterior of the Boiler Plant Building (see photo)**

**Trenching**

**Bollard locations**

<b>CONSULTANTS:</b>  895 ROBERTA LANE, SUITE 104, SPARKS, NV 89431 (775) 359-3303 FAX (775) 359-3329 odyssey ENGINEERING INCORPORATED		<b>ARCHITECT/ENGINEERS:</b>  <b>PK Electrical, Inc.</b> 681 Sierra Rose Dr., Ste. B • Reno, Nevada 89511 P. 775.826.9010 • F. 775.826.9030 • pk-electrical.com 10048		<b>BID DOCUMENTS</b> Drawing Title: OVERALL SITE DISPLAY Approved Project Director: _____		<b>Project Title:</b> Package 1 - VA Oxygen Tank Relocation + System Upgrade <b>Location:</b> 1000 Locust Street, Reno, NV 89520 <b>Date:</b> FEBRUARY 23, 2011 <b>Checked:</b> GWS <b>Drawn:</b> GWS		<b>Project Number:</b> 654-10-110 <b>Building Number:</b> 1, 1D, 8 + 12 <b>Drawing Number:</b> CS-100 <b>Office of Construction and Facilities Management</b> 	
---	--	---	--	---	--	--	--	---	--