one eighth inch = one foot | one quarter inch = one foot | three eighths inch = one foot | one half inch = one foot | three quarters inch = one foot | one inch = one foot | one and one half inches = one foot | three inches = one foot

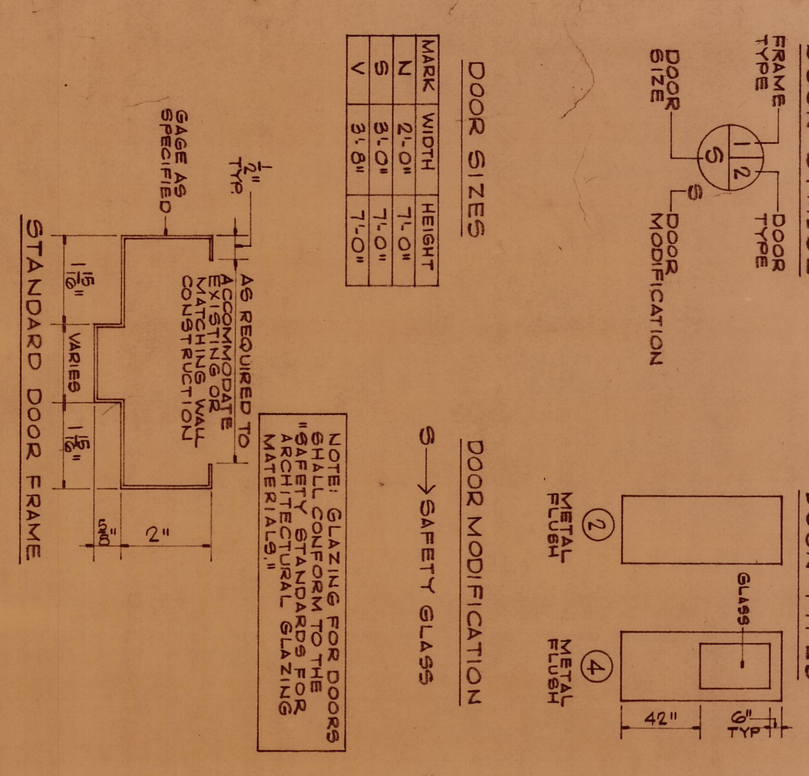

MARK	WIDTH	HEIGHT
N	2'-0"	7'-0"
S	3'-0"	7'-0"
V	3'-8"	7'-0"

FINISH SCHEDULE

ROOM NO.	FLOOR	BASE	WALLS MATERIAL	WALLS FINISH	CEILING	REMARKS
B-211	VAT	V	PLASTER	PAINT	A.T.	1
B-212	VAT	V	PLASTER	PAINT	A.T.	1
B-213	C.T.	C.T.	PLASTER	C.T.-PAINT	PLAS-PAINT	2
B-214	VAT	V	PLASTER	PAINT	A.T.	
B-215	VAT	V	PLASTER	V.W.C.	A.T.	3
B-216	VAT	V	PLASTER	PAINT	A.T.	1
B-217	VAT	V	PLASTER	PAINT	A.T.	
B-217A	VAT	V	PLASTER	PAINT	A.T.	1
B-218	VAT	V	PLASTER	PAINT	A.T.	4
B-221	VAT	V	PLASTER	PAINT	A.T.	1
B-222	VAT	V	PLASTER	PAINT	A.T.	1
B-224A					PLAS-PAINT	1
B-224B			PLASTER	PAINT		1 DELETE
B-225						4
B-227				VWC		3
B-230		PLASTER	PAINT		PLAST-PAINT	
B-231		PLASTER	PAINT-VWC			1, 3

KEY TO REMARKS
1. PAINT ALL WALLS
2. PROVIDE 4'-0" HIGH C.T. WAINSCOT
3. MATCH ADJACENT EXISTING FINISHES.
4. LOW PLASTIC LAMINATE CLAD PARTITIONS WITH GLAZED TOP.

KEY TO ABBREVIATIONS
A.T. — ACOUSTIC TREATMENT
C.T. — CERAMIC TILE
V. — VINYL
V.A.T. — VINYL ASBESTOS TILE
V.W.C. — VINYL WALL COVERING

FINISH NOTES
IN GENERAL FINISHES SHALL MATCH EXISTING COLORS AND PATTERNS ALREADY ESTABLISHED IN RMS. SUBMIT ALL PROPOSED COLORS AND PATTERNS FOR APPROVAL.

△ AS-BUILT REVISIONS 2-10-86

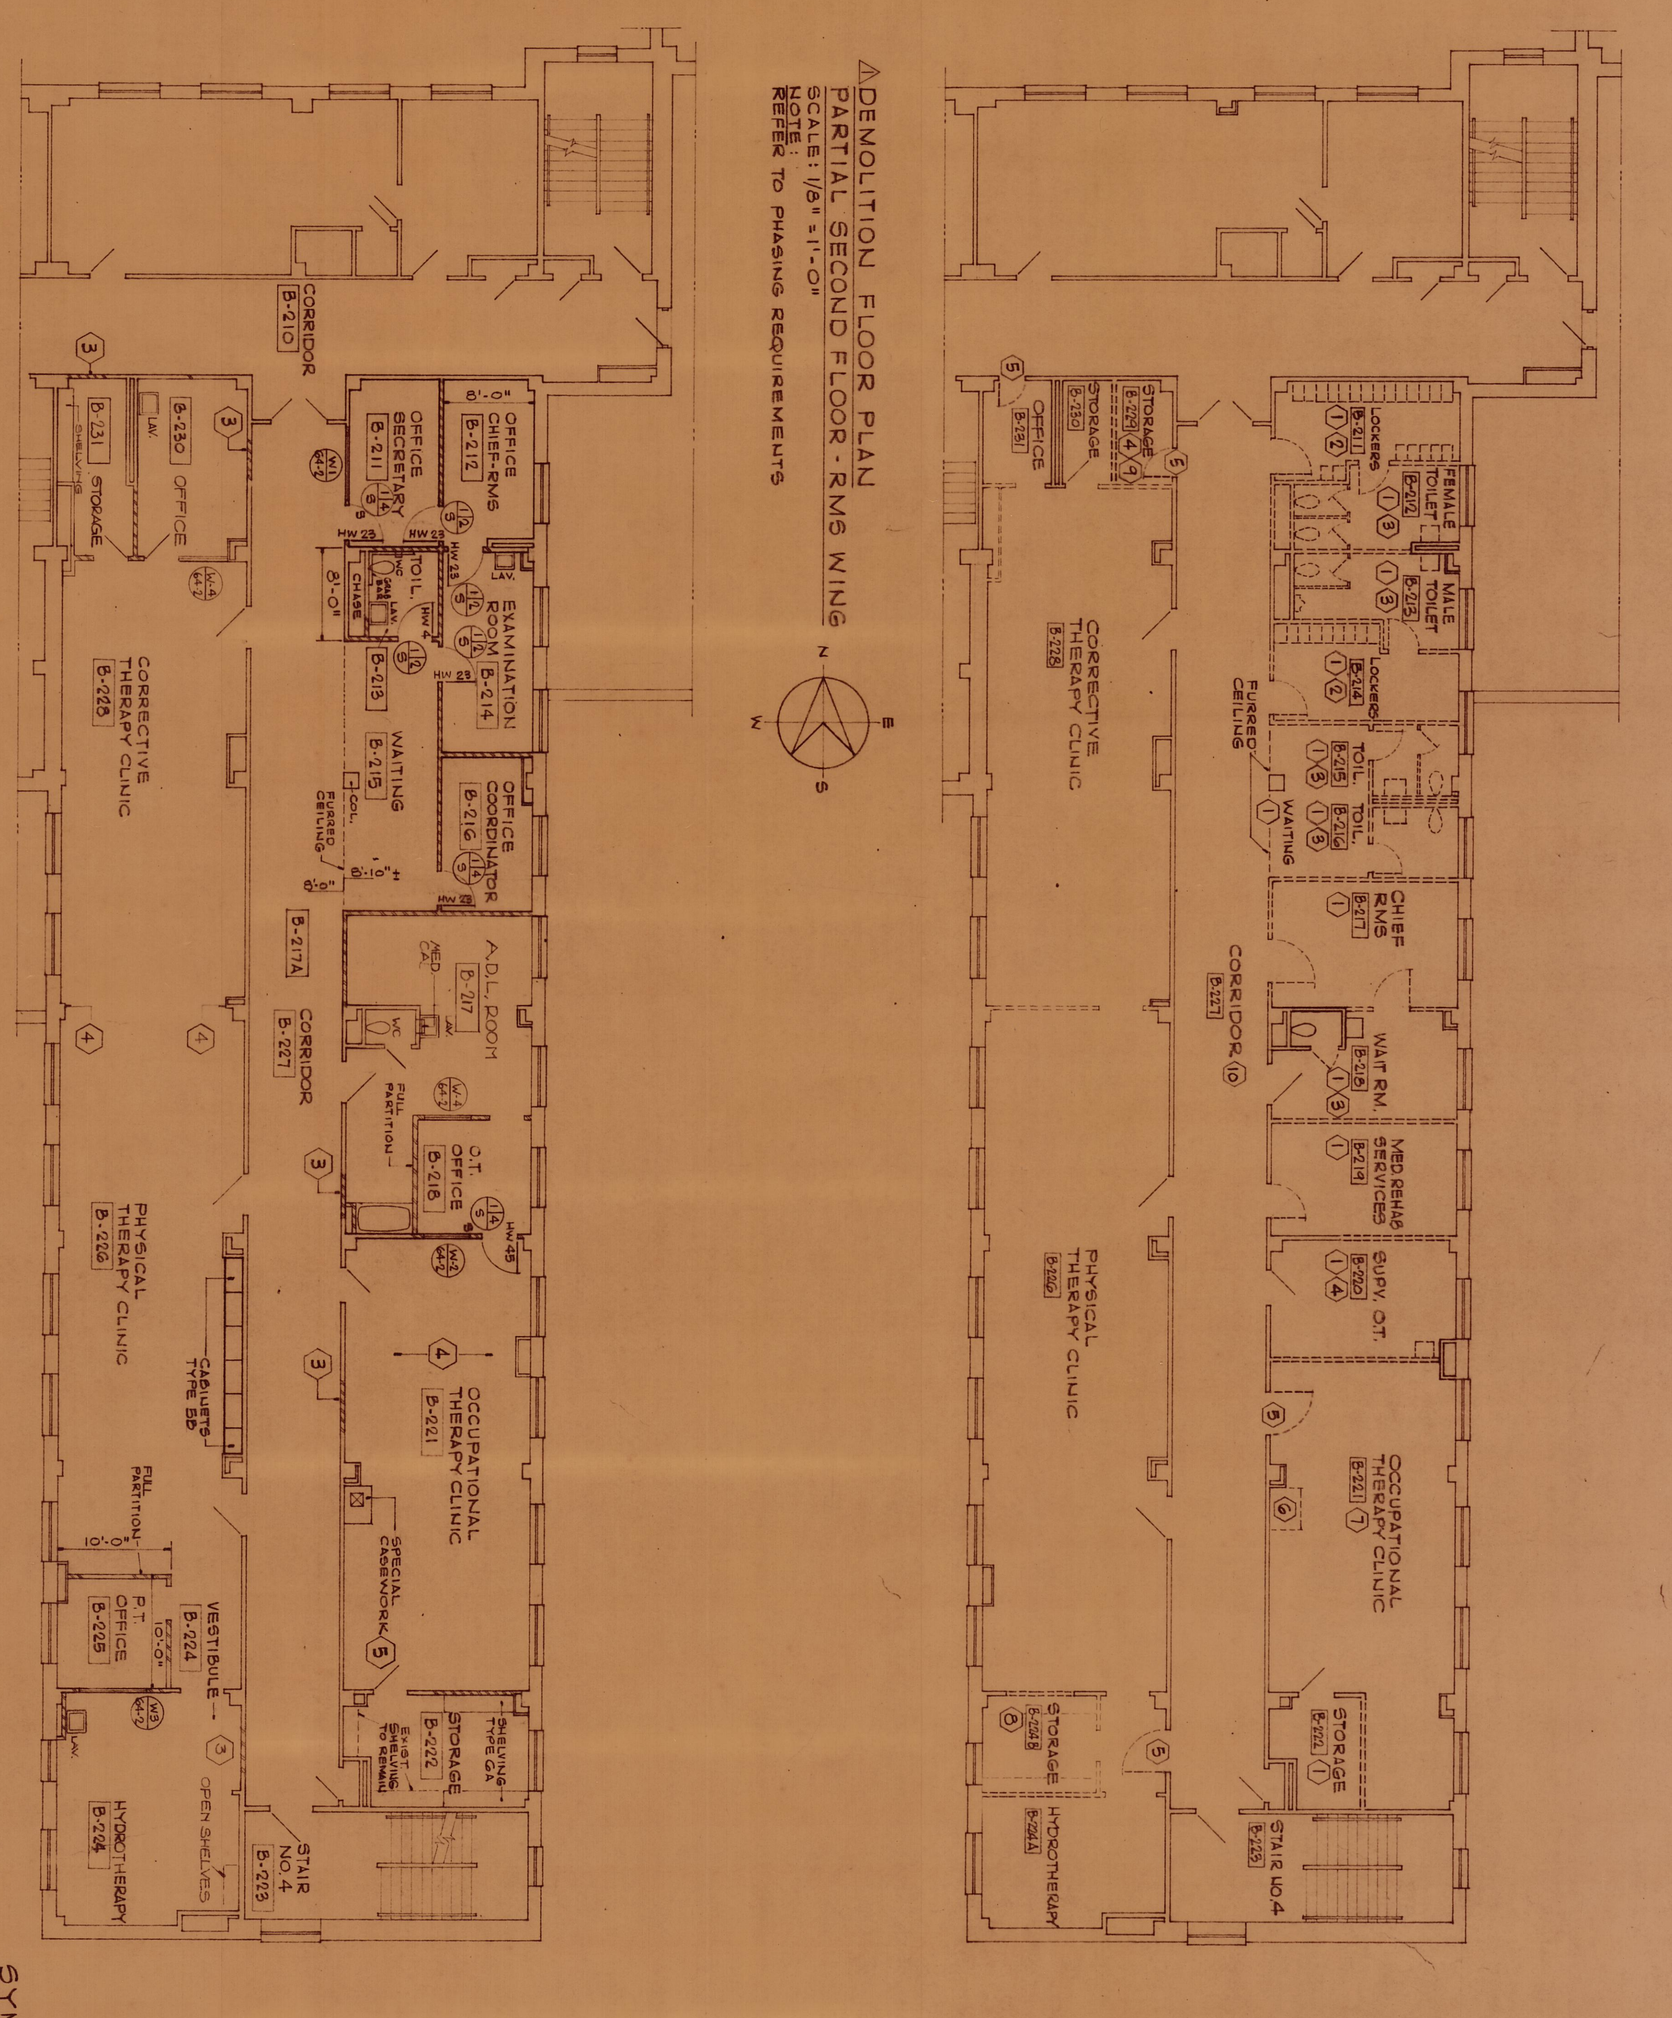

DEMOLITION NOTES

1. REMOVE FLOOR FINISH, PARTITIONS - DOORS - FRAMES WHERE INDICATED AND CEILING CONSTRUCTION.
2. REMOVE METAL LOCKERS. FREE STANDING LOCKERS SHALL REMAIN THE PROPERTY OF THE GOVERNMENT.
3. REMOVE TOILET PARTITIONS AND PLUMBING FIXTURES REFER TO PLUMBING PLANS.
4. REMOVE PLUMBING FIXTURE
5. REMOVE DOOR AND FRAME.
6. REMOVE CASEWORK. REFER TO RELOCATION PLAN AND PLUMBING DWGS.
7. REMOVE CEILING CONSTRUCTION AS REQUIRED FOR INSTALLATION OF NEW CEILING.
8. REMOVE PORTION OF PARTITIONS WHERE INDICATED TO ACCOMMODATE NEW VIEW WINDOWS. MODIFY EXISTING SHELVING (METAL) AT VIEW WINDOW LOCATIONS. RETAIN MAXIMUM SHELVING.
9. REMOVE PARTITION WHERE INDICATED.
10. REMOVE SUSPENDED CEILING AS REQUIRED TO PERFORM MECHANICAL AND ELECTRICAL WORK. REINSTALL CEILING REPLACING ALL DAMAGED TILE OR SUSPENSION RESULTING FROM WORK OF THIS CONTRACT.

RENOVATION - CONSTRUCTION NOTES

1. ALL PARTITIONS (NEW) ARE 4" NOMINAL METAL STUDS AND PLASTER TO MATCH ADJACENT CONSTRUCTION.
2. NEW PARTITIONS SHALL ALIGN WITH EXISTING PARTITIONS, WITH COLUMN FACES OR WITH WINDOW JAMBS AS SHOWN ON THE DRAWING UNLESS LOCATED OTHERWISE BY DIMENSION.
3. CLOSE WALL OPENING AT REMOVED DOOR AND FRAME WITH NEW CONSTRUCTION TO MATCH ADJACENT CONSTRUCTION. PROVIDE NEW FINISHES TO MATCH ADJACENT FINISHES.
4. PATCH FLOOR, WALL AND CEILING AT REMOVED PARTITION TO MATCH EXISTING ADJACENT CONSTRUCTION AND FINISHES.
5. REMOVE EXISTING CASEWORK AND PROVIDE NEW CASEWORK SIMILAR TO EXISTING AND AS SPECIFIED.

SYMBOLS AND MATERIALS LEGEND

ROOM NAME / ROOM NUMBER — WALL TO BE REMOVED
DETAIL NUMBER / DWG. NO. — METAL STUD WALL FINISHES AS SPECIFIED
SECTION NUMBER / DWG. NO. — SUSPENDED ACOUSTICAL CEILING
FLUORESCENT LIGHT FIXTURE — SUSPENDED PLASTER CEILING
MECHANICAL DIFFUSER & GRILLE

GRAPHIC SCALE
0 1 2 3 4 8 12 16 20 24
SCALE: 1/8" = 1'-0"

Drawing Title	DEMOLITION AND RENOVATION FLOOR PLANS SCHEDULES AND LEGEND
Approved: Division Chief	
Approved: Service Director	
Drawn	RJW
Checked	RJW
Project Title	RENOVATE REHABILITATIVE MEDICINE SERVICE BLDG. 64 V.A.M.C.
Building Number	64
Location	LAKE CITY, FLORIDA
Date	FEB. 15, 1984
Project No.	82-115
DRAWING No.	64-1
Dwg. 1 Of 4	

Revisions | Date

Veterans Administration

VA FORM 08-6231, OCT 1978

RENOVATE REHAB. MED. SVCS. BLD. 64-0516

DEMO/RENOV. FLOOR PLANS, LEGEND + SCHEDULE

PROJ. 82-115 64-1 SHEET 1 of 4

64-0516