



three inches = one foot  
 one and one half inches = one foot  
 one inch = one foot  
 three quarters inch = one foot  
 one half inch = one foot  
 three eighths inch = one foot  
 one quarter inch = one foot  
 one eighth inch = one foot

A  
 B  
 C  
 D  
 E  
 F

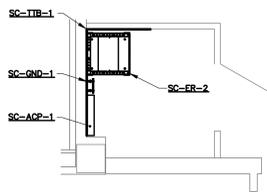


**1 TECHNOLOGY ROOM LAYOUT HC-1, ROOM 100D1-1**

- SCALE: 1/4"=1'-0"
- NOTES:
- REFER TO ELECTRICAL DRAWINGS FOR GROUNDING RISER DIAGRAM.
  - REFER TO 2/00 TY401 FOR CONNECTIVITY RISER DIAGRAM.
  - REFER TO 00 TY600 FOR TECHNOLOGY GENERAL EQUIPMENT SCHEDULE.
  - FIBER CONNECTIVITY SHALL BE FROM O&T ROOM 100A2-1.

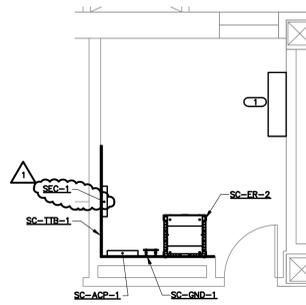


**2 TECHNOLOGY ROOM LAYOUT HC-2, ROOM 1C144-1**

- SCALE: 1/4"=1'-0"
- NOTES:
- REFER TO ELECTRICAL DRAWINGS FOR GROUNDING RISER DIAGRAM.
  - REFER TO 2/00 TY401 FOR CONNECTIVITY RISER DIAGRAM.
  - REFER TO 00 TY600 FOR TECHNOLOGY GENERAL EQUIPMENT SCHEDULE.
  - FIBER CONNECTIVITY SHALL BE FROM O&T ROOM 100B-1.
- KEYNOTES:
- EXISTING COMMON ALARM CONTROL PANEL TO REMAIN. DUPLICATE EMERGENCY SHALL BE LOCATED IN PRIMARY AND SECONDARY SSC.

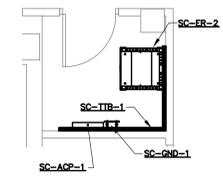

**3 TECHNOLOGY ROOM LAYOUT HC-3, ROOM 2C25A-1**

- SCALE: 1/4"=1'-0"
- NOTES:
- REFER TO ELECTRICAL DRAWINGS FOR GROUNDING RISER DIAGRAM.
  - REFER TO 2/00 TY401 FOR CONNECTIVITY RISER DIAGRAM.
  - REFER TO 00 TY600 FOR TECHNOLOGY GENERAL EQUIPMENT SCHEDULE.
  - FIBER CONNECTIVITY SHALL BE FROM O&T ROOM 2C25-1.

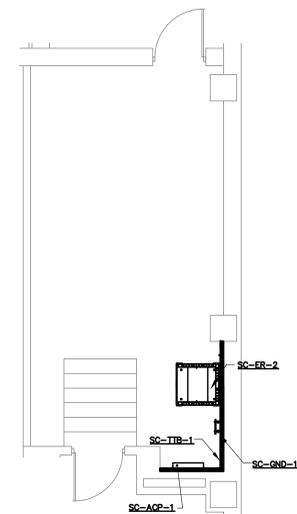

**4 TECHNOLOGY ROOM LAYOUT HC-5, ROOM 601B1-1**

- SCALE: 1/4"=1'-0"
- NOTES:
- REFER TO ELECTRICAL DRAWINGS FOR GROUNDING RISER DIAGRAM.
  - REFER TO 2/00 TY401 FOR CONNECTIVITY RISER DIAGRAM.
  - REFER TO 00 TY600 FOR TECHNOLOGY GENERAL EQUIPMENT SCHEDULE.
  - FIBER CONNECTIVITY SHALL BE FROM O&T ROOM 5A03A.

No.	Description	Date
1	ADDENDUM #4	12/05/14

**CONSULTANTS:**

**K J W V ENGINEERING CONSULTANTS**  
 Experience you can build on  
 870 SUMNER DRIVE, SUITE 104  
 2110210, MUSKOGEE, OK 74401  
 205-212-1234  
 FAX: 205-212-1173  
 WWW.KJWV.COM

**ARCHITECTS/ENGINEERS:**

**303rd Engineering Group, LLC**  
 Service-Disabled Veteran-Owned Small Business  
 1925 AIRBORNE STREET  
 BY LOGUE #40 63118  
 PHOENIX 321 41 5649 3282  
 HTTP://WWW.303ENGINEERING.COM

Dept. of Veterans Affairs  
 Jack C. Montgomery  
 Medical Center  
 1011 Honor Height Drive  
 Muskogee, Oklahoma 74401

APPROVED

APPROVED President AF.G.E. 2250

APPROVED Energy Engineer

APPROVED Safety Manager

APPROVED Medical Center Director

Drawing Title:  
**ROOM ENLARGEMENTS**

Scale:  
**AS SHOWN**

Building Number:  
 1

Project Title:  
**REPLACE SURVEILLANCE SYSTEM**

Approved: TWC - JCMVAMC  
 Checked By: DAVLAR  
 Drawn By: KEIEVE

Location:  
 Jack C. Montgomery  
 VA Medical Center - Muskogee, OK

Date: 08.23.13  
 Project No. 623.12.105  
 Drawing No. **01 TY200**  
 Dwg. 61 of 122

Department of Veterans Affairs

ISSUED FOR CONSTRUCTION