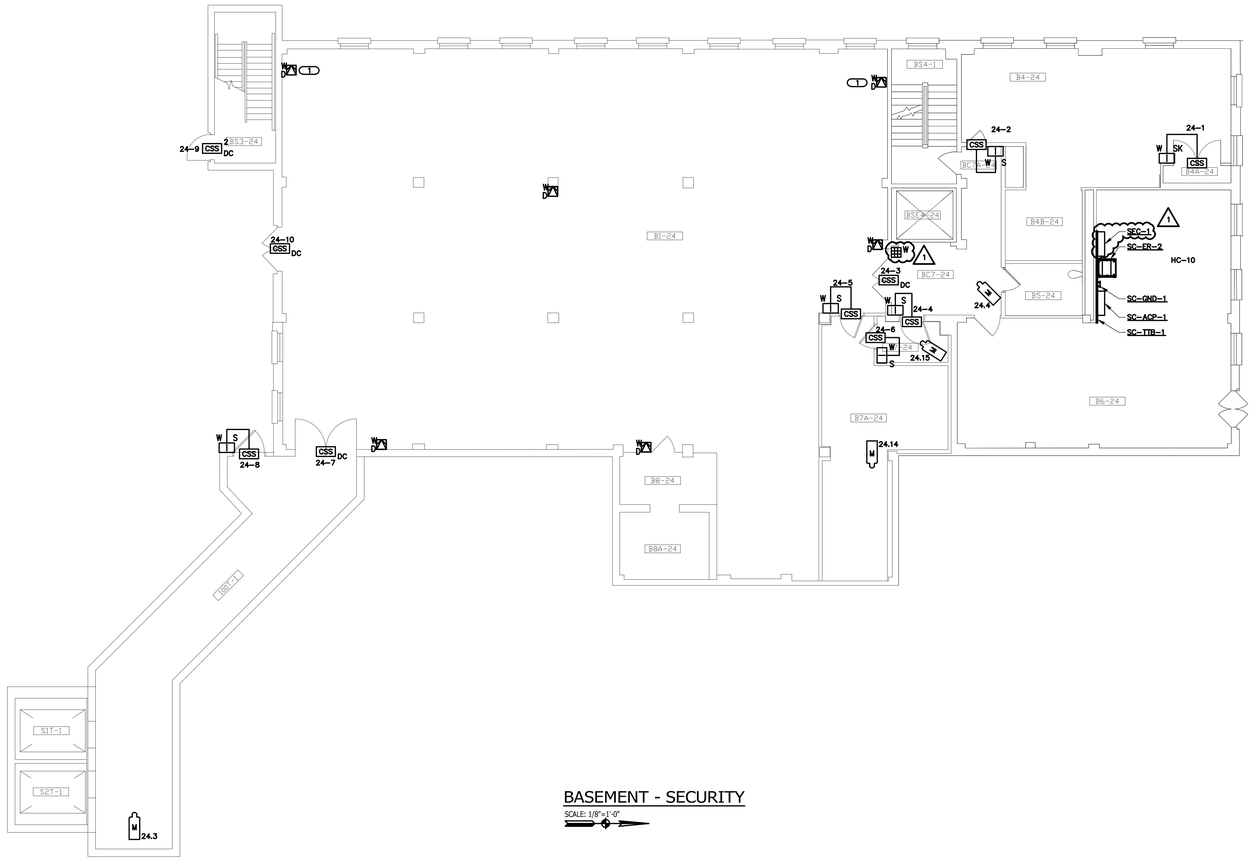

BASEMENT - SECURITY

SCALE: 1/8"=1'-0"

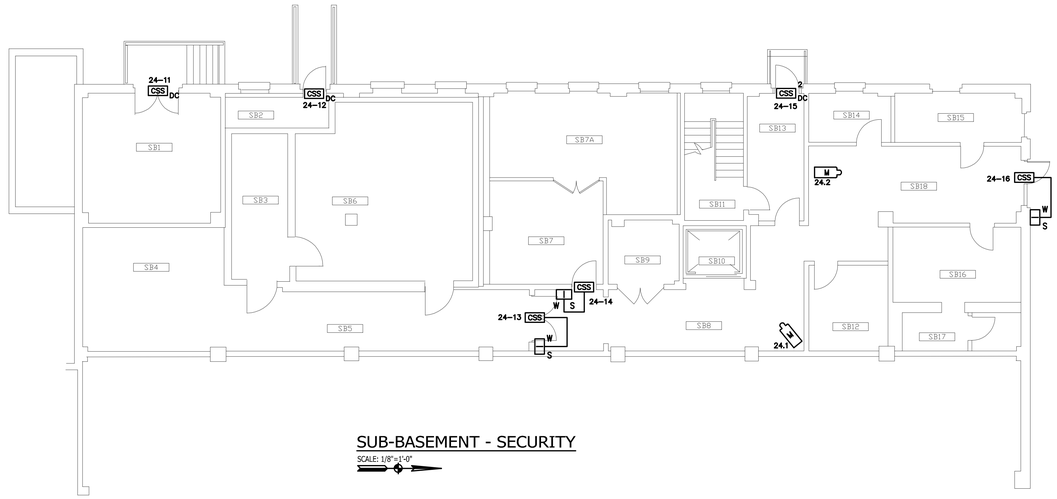

SUB-BASEMENT - SECURITY

SCALE: 1/8"=1'-0"

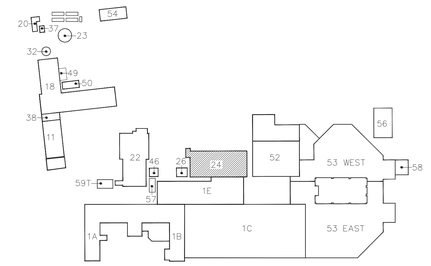

KEY PLAN

NO SCALE

GENERAL NOTES

1. NETWORK CABLES TO DEVICES ON THIS SHEET SHALL BE ROUTED TO HC-10.

KEYNOTES

1. NARROW, LONG RANGE FIELD OF VIEW ALONG WINDOWNS

ISSUED FOR CONSTRUCTION

No.	Description	Date
1	ADDENDUM #4	12/05/14

Revisions

CONSULTANTS:

KJW ENGINEERING CONSULTANTS
Experience you can build on.
#25 SUNNEN DRIVE, SUITE 104
ST. LOUIS, MISSOURI 63143
314.645.0333
FAX 314.645.0173
www.kjwweb.com
STRUCTURAL | MECHANICAL | ELECTRICAL
TECHNOLOGY | MEDICAL EQUIPMENT SOLUTIONS
Kjww, PC
Missouri State Certificate of Authority #2003008920

ARCHITECTS/EARNERS:

303rd Engineering Group, LLC
A Service-Disabled Veteran-Owned Small Business
1935 Arsenal Street
St. Louis, MO 63118
Phone: (314) 664-3382
http://www.303rdengineering.com

Dept. of Veterans Affairs
Jack C. Montgomery
Medical Center
1011 Honor Height Drive
Muskogee, Oklahoma 74401

APPROVED:	APPROVED: President A.F.G.E. 2250	APPROVED: Energy Engineer	APPROVED: Medical Center Director
APPROVED:	APPROVED:	APPROVED: Safety Manager	APPROVED: Associate Director
APPROVED:	APPROVED:	APPROVED: Infection Control Nurse	APPROVED: Chief of Staff
APPROVED:	APPROVED:	APPROVED: Industrial Hygienist	APPROVED: Chief of Engineering Service

Drawing Title: SUB-BASEMENT AND BASEMENT

Project Title: REPLACE SURVEILLANCE SYSTEM

Date: 08.23.13

Project No. 623.12.105

Scale: AS SHOWN

Approved: TWC - JCMVAMC

Checked By: DAVLAR

Drawn By: KEIEVE

Building Number: 24

Location: Jack C. Montgomery VA Medical Center - Muskogee, OK

Drawing No. 24 TY101

Dwg. 77 of 122

Department of Veterans Affairs

VA FORM 08-6231 PRINTED ON: December 4, 2014 ORIGINAL SIZE OF SHEET IS 30" X 42"