



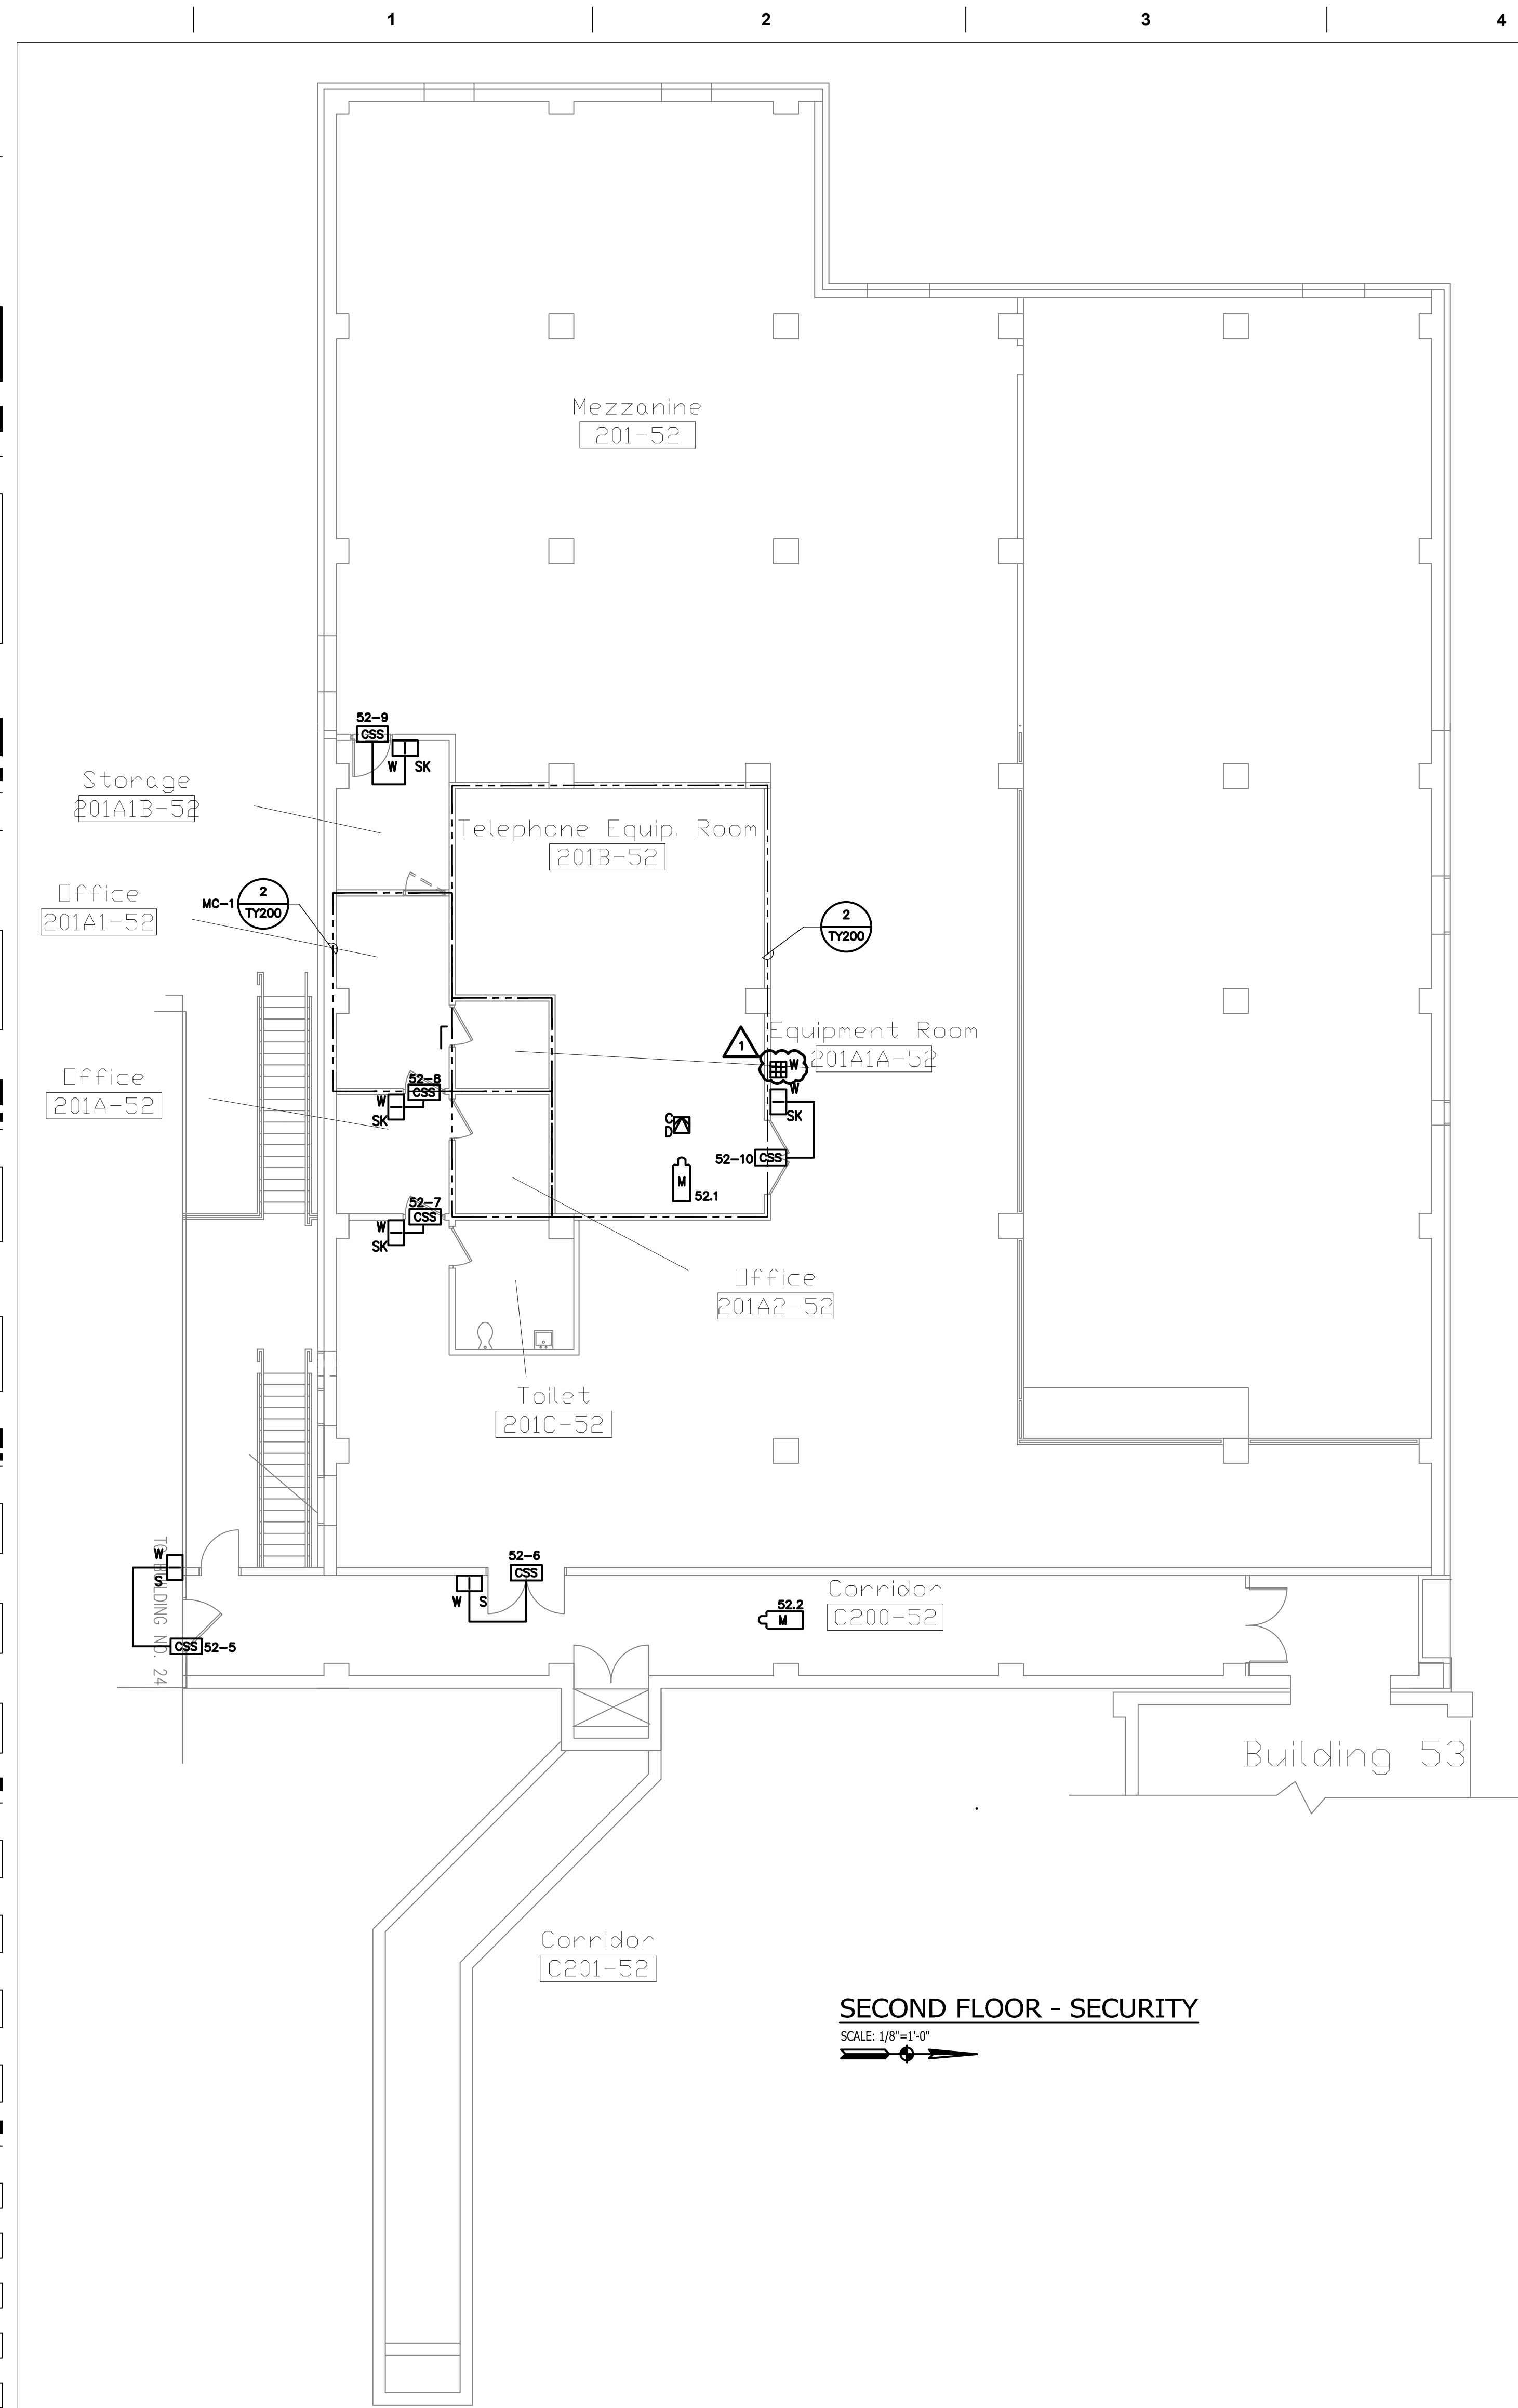

SECOND FLOOR - SECURITY

SCALE: 1/8"=1'-0"

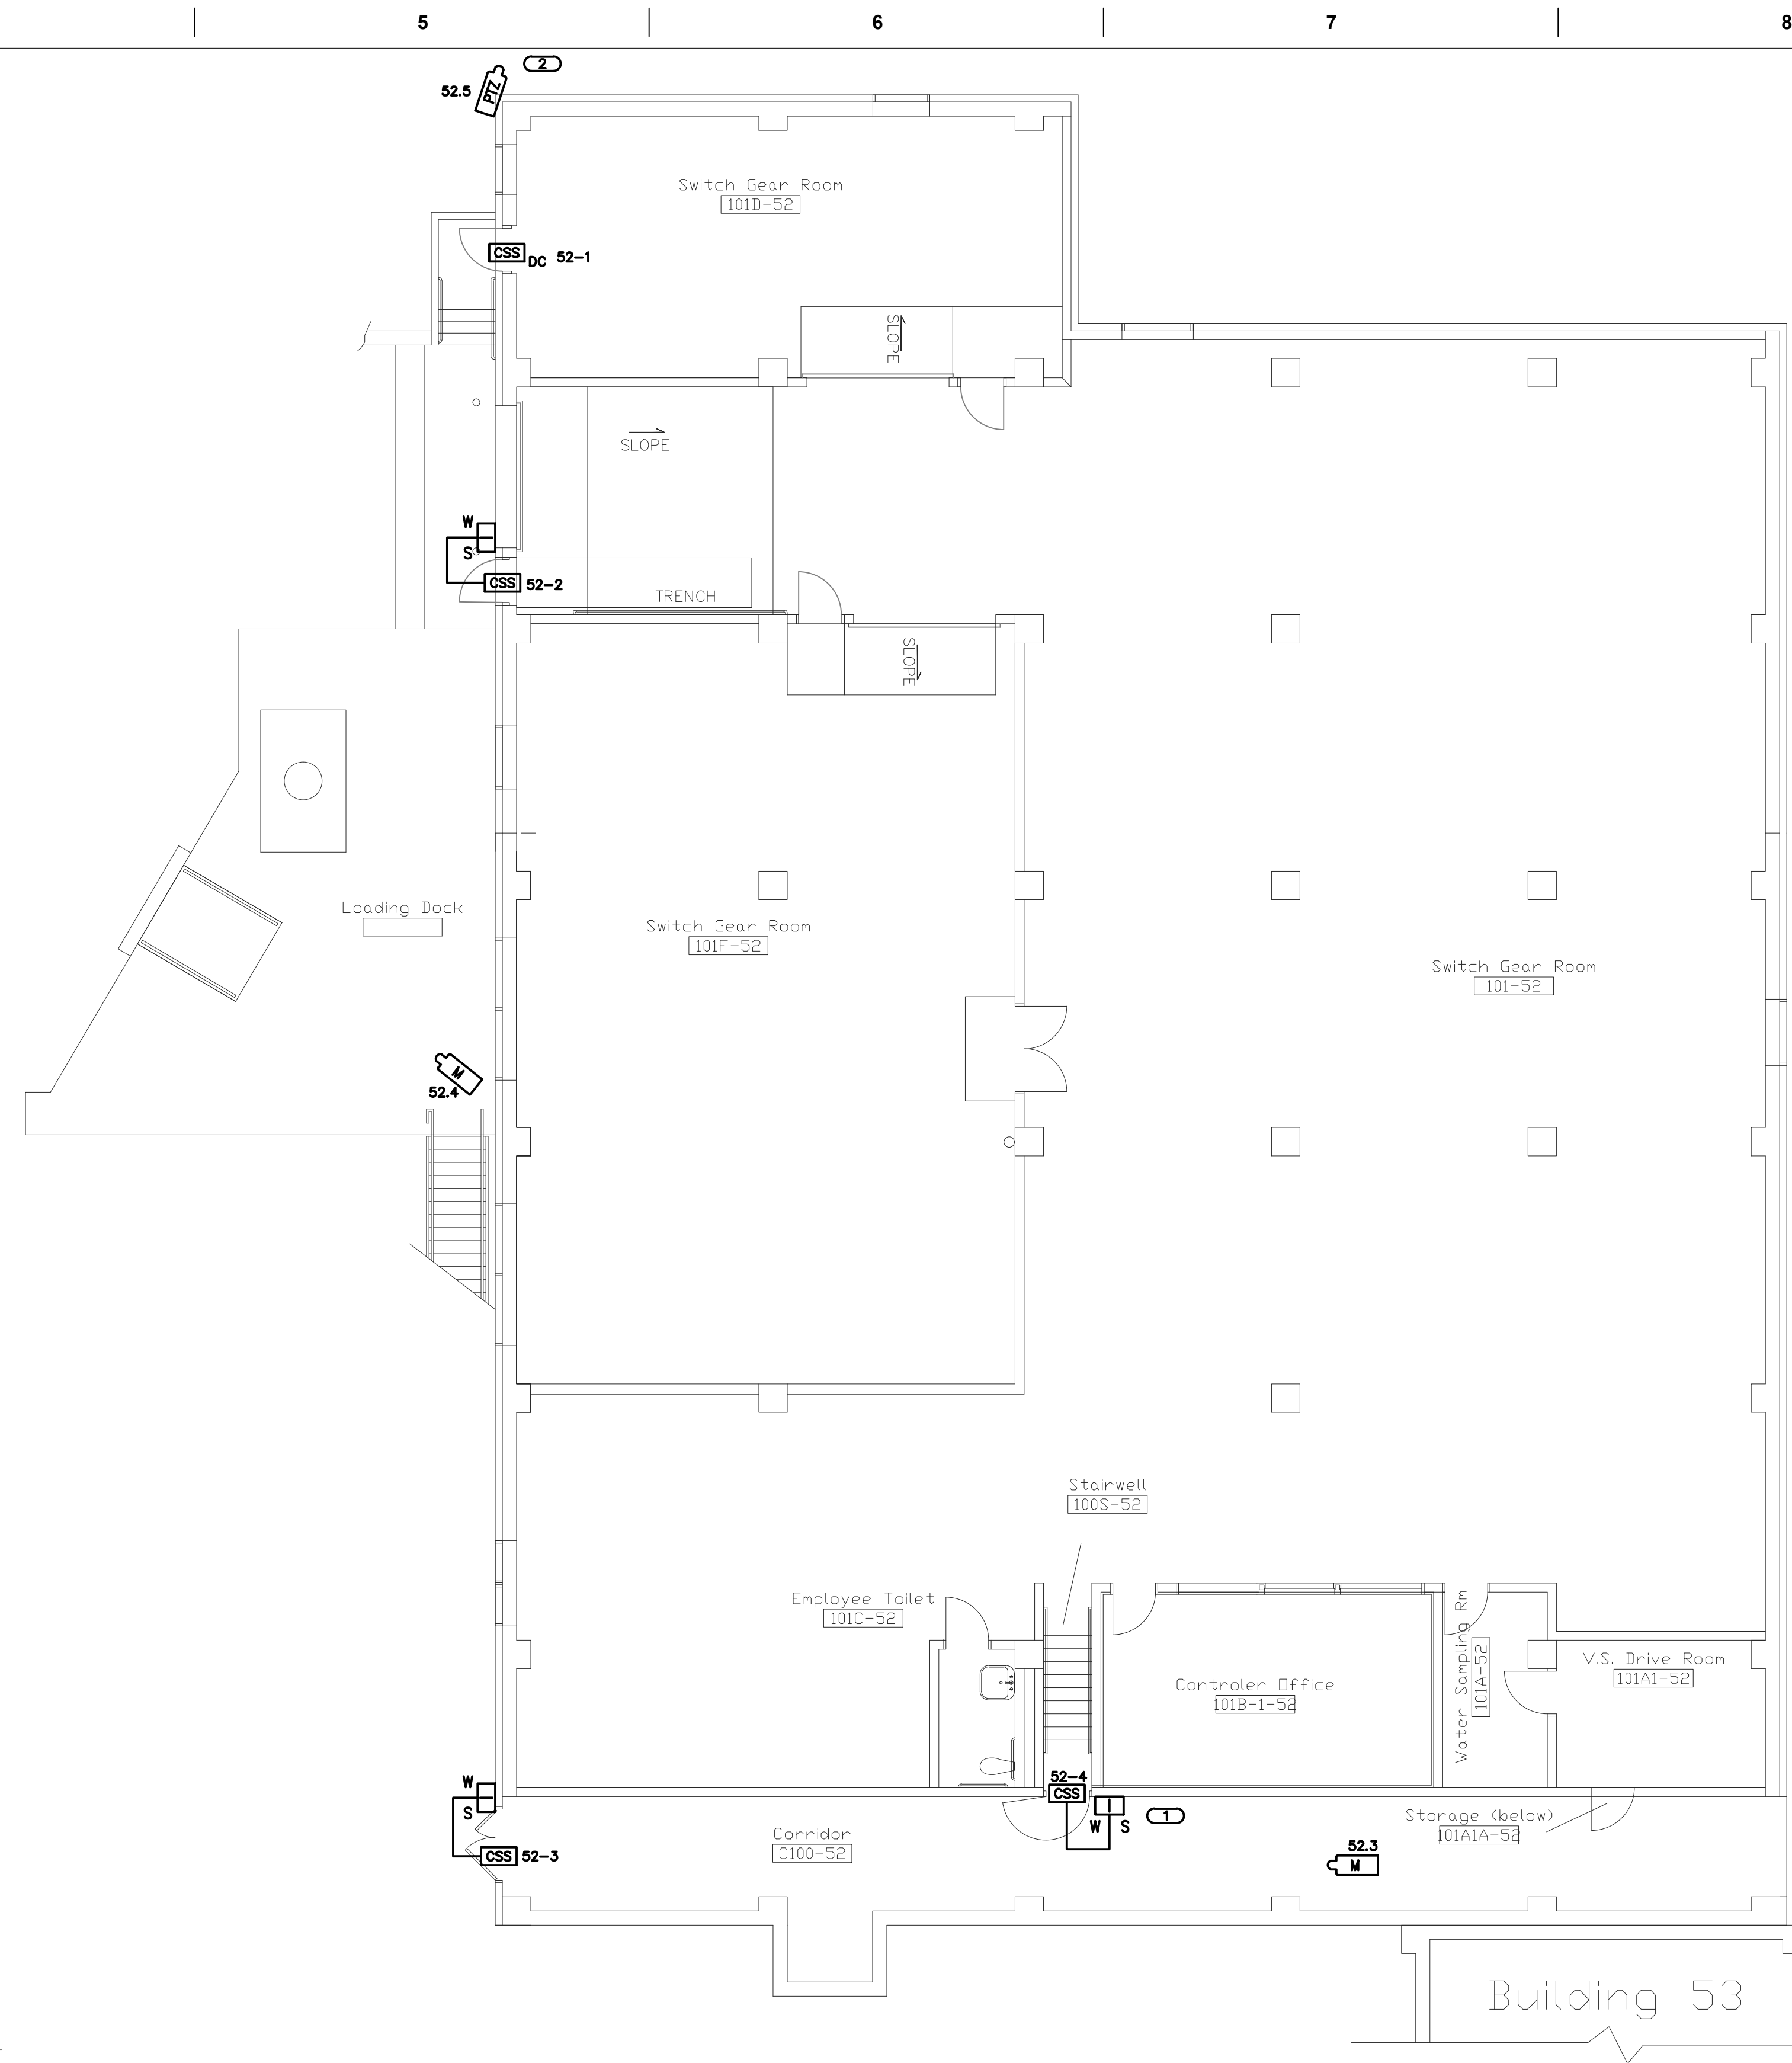

FIRST FLOOR - SECURITY

SCALE: 1/8"=1'-0"

