


1 TELEPHONE EQUIPMENT ROOM ENLARGEMENT 201B-52
SCALE: 1/4"=1'-0"

KEYNOTES:
 1 EXISTING MAIN FIBER CROSS CONNECT PANEL. THERE IS EXISTING SPARE FIBER FROM THIS PANEL TO O&T ROOMS. REFER TO 00 TY400 FOR O&T ROOMS TO BE USED IN THIS PROJECT. CONTRACTOR SHALL FURNISH, INSTALL AND TERMINATE FIBER FROM THIS PANEL TO MC-1 IN ROOM 201A1-52.

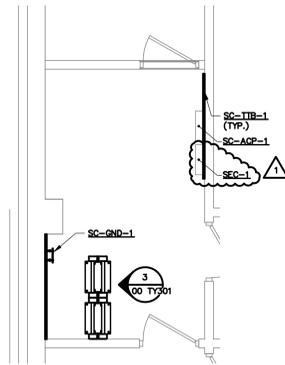

2 TECHNOLOGY ROOM LAYOUT MC-1
SCALE: 1/4"=1'-0"

NOTES:
 1. REFER TO ELECTRICAL DRAWINGS FOR GROUNDING RISER DIAGRAM.
 2. REFER TO 3/00 TY401 FOR CONNECTIVITY RISER DIAGRAM.
 3. REFER TO 00 TY600 FOR TECHNOLOGY GENERAL EQUIPMENT SCHEDULE.

three inches = one foot
 one and one half inches = one foot
 one inch = one foot
 three quarters inch = one foot
 three eighths inch = one foot
 one half inch = one foot
 three eighths inch = one foot
 one quarter inch = one foot
 one eighth inch = one foot

A
 B
 C
 D
 E
 F

ISSUED FOR CONSTRUCTION

No.	Description	Date
1	ADDENDUM #4	12/05/14

CONSULTANTS:

 K J W ENGINEERING CONSULTANTS
 Experience you can build on.
 870 SUMNER DRIVE, SUITE 104
 21110120, MUSKOGEE, OK 74401
 205-271-2124
 FAX: 205-271-1173
 WWW.KJW.COM
 STRUCTURAL | MECHANICAL | ELECTRICAL
 TECHNOLOGY | MEDICAL EQUIPMENT SOLUTIONS
 Equal Opportunity Employer

ARCHITECTS/ENGINEERS:

 303rd Engineering Group, LLC
 Service-Disabled Veteran-Owned Small Business
 1925 AIRBORNE STREET
 87. LOUIS MO. 63118
 PHONE: (314) 569-3282
 HTTP://WWW.303ENGINEERING.COM

Dept. of Veterans Affairs
 Jack C. Montgomery
 Medical Center
 1011 Honor Height Drive
 Muskogee, Oklahoma 74401

APPROVED:	APPROVED: President AF.G.E. 2250	APPROVED: Energy Engineer	APPROVED: Medical Center Director
APPROVED:	APPROVED:	APPROVED: Safety Manager	APPROVED: Associate Director
APPROVED:	APPROVED:	APPROVED: Infection Control Nurse	APPROVED: Chief of Staff
APPROVED:	APPROVED:	APPROVED: Industrial Hygienist	APPROVED: Chief of Engineering Service

APPROVED:	APPROVED:	APPROVED:	APPROVED:
APPROVED:	APPROVED:	APPROVED:	APPROVED:
Drawing Title: ROOM ENLARGEMENTS	Scale: AS SHOWN	Building Number: 52
--	---------------------------	-------------------------------

Project Title: REPLACE SURVEILLANCE SYSTEM		
Approved: TWC - JCMVAMC	Checked By: DAVLAR	Drawn By: KEIEVE
Location: Jack C. Montgomery VA Medical Center - Muskogee, OK		

Date: 08.23.13
Project No.: 623.12.105
Drawing No.: 52 TY200
Dwg.: 81 of 122

